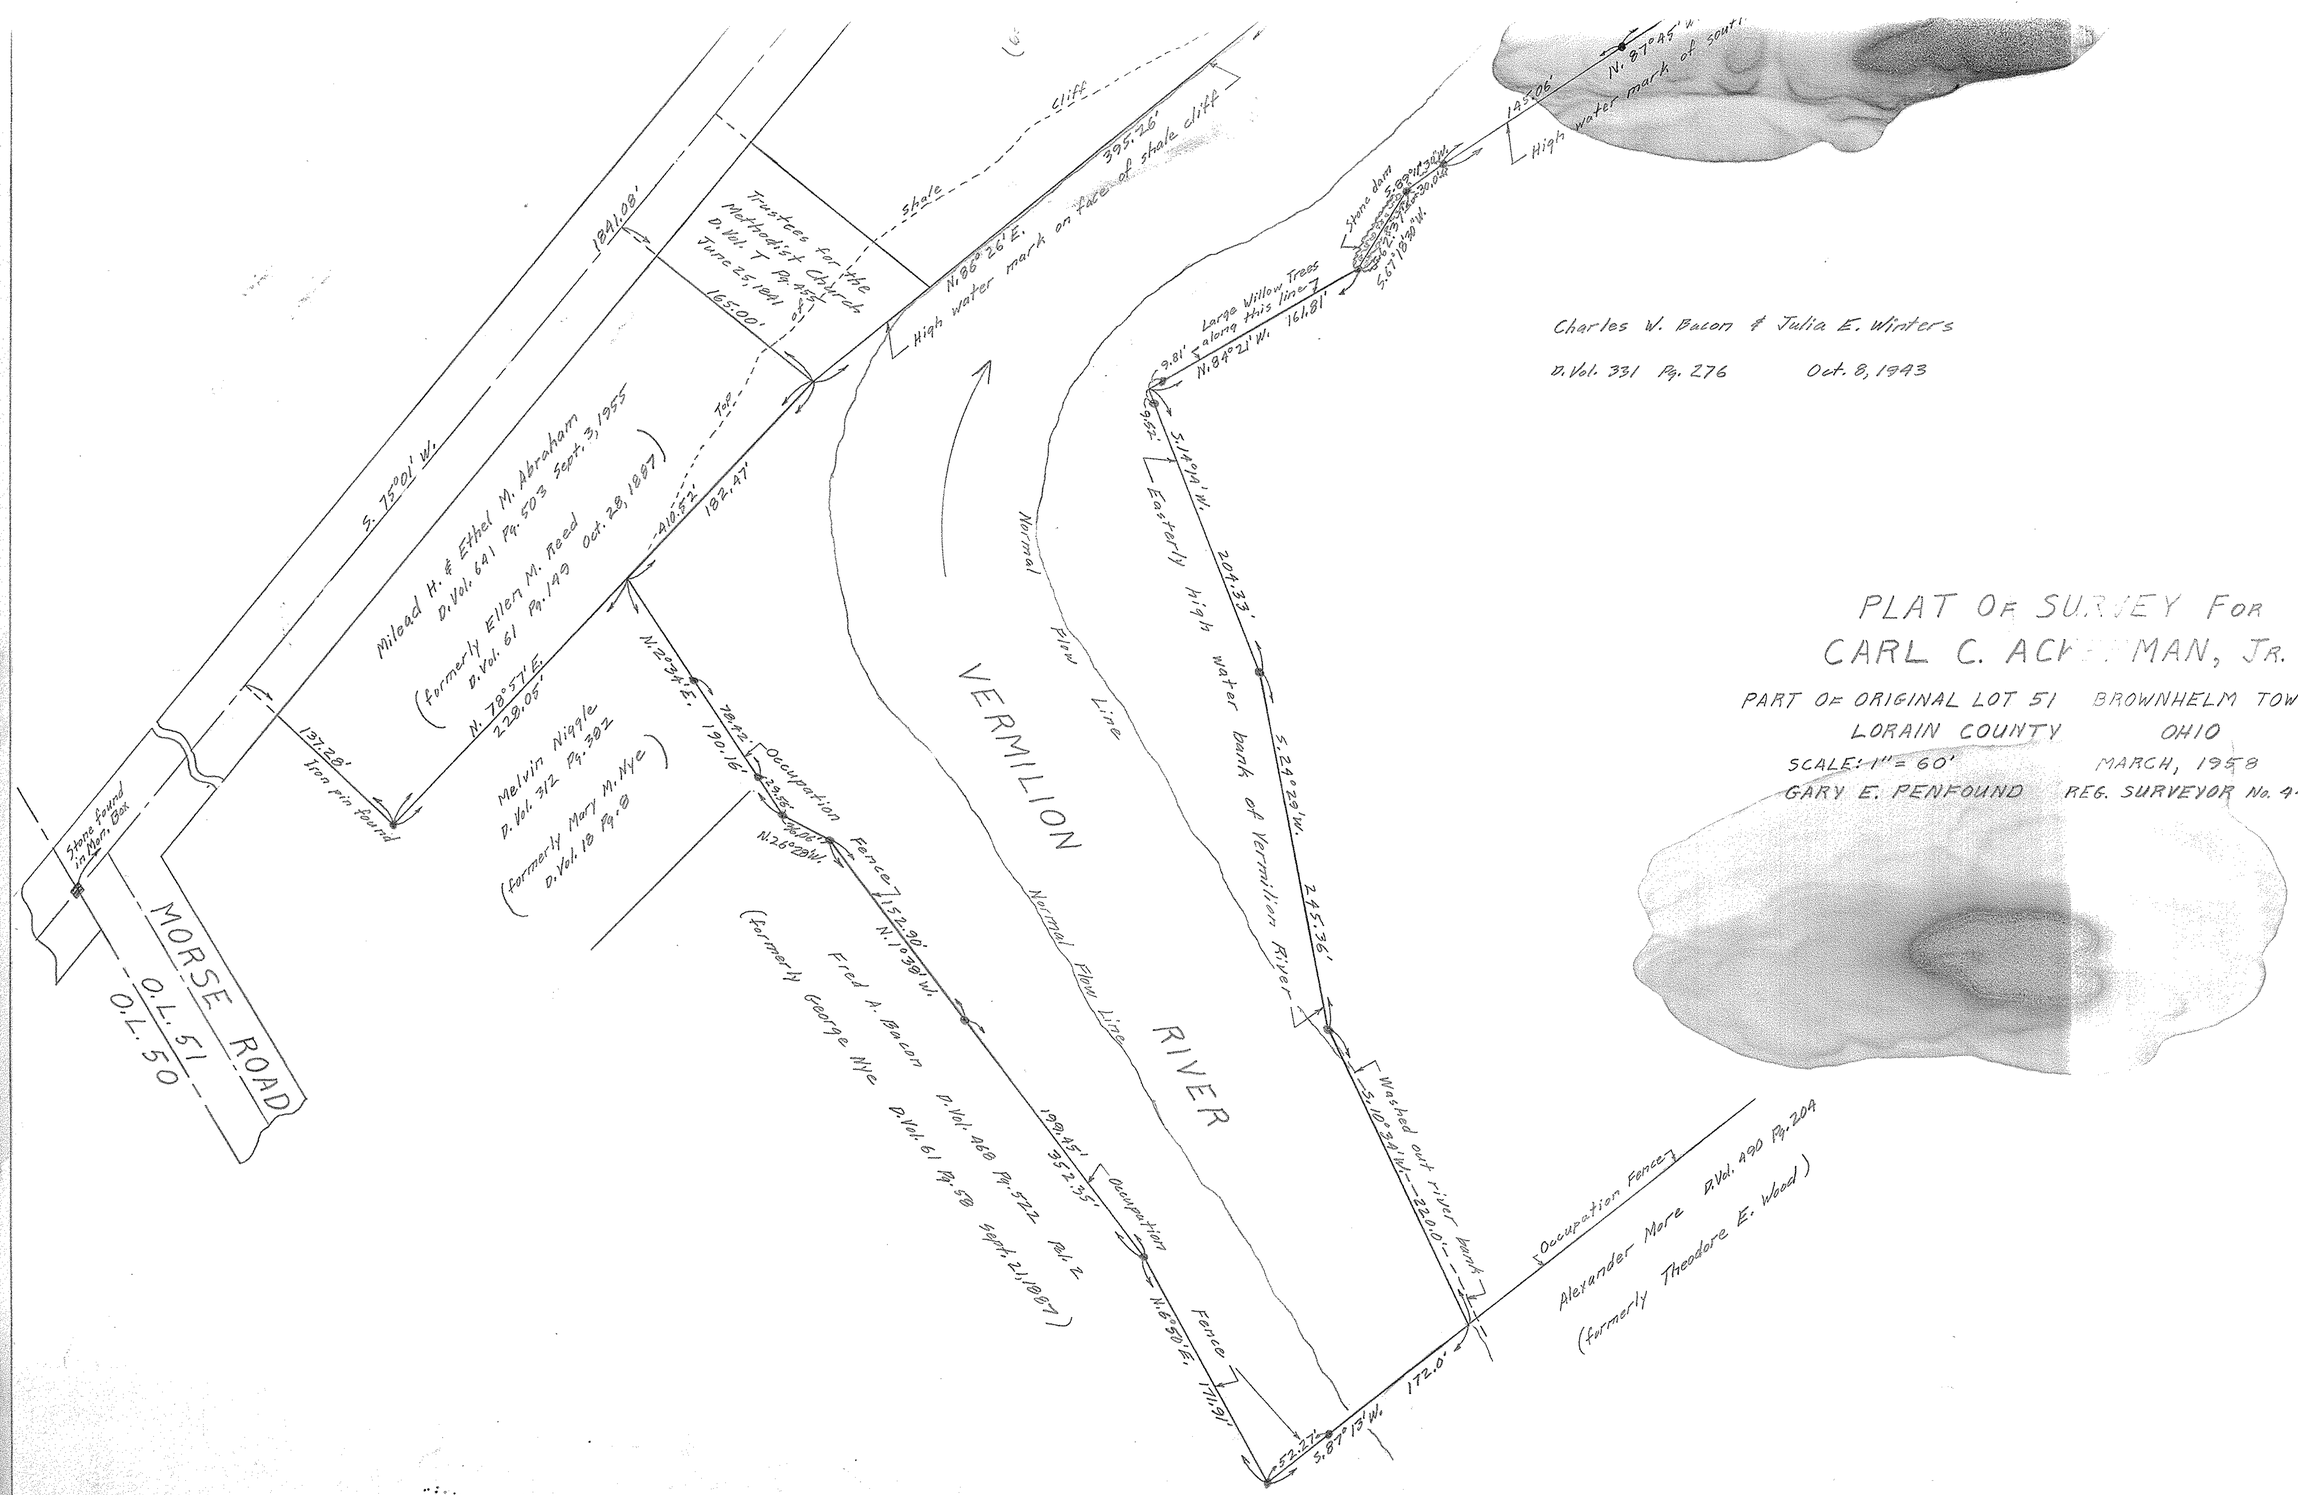

NOTE: Iron pins found or set shown thus: ●