PLAT OF PARTIAL SURVEY FOR
MARGARET L. BUCHS AND ROBERT L. KING, REALTOR
DIVISION OF LAND IN ORIGINAL LOT 5 OF TRACT No. 13
HENRIETTA TOWNSHIP - LORAIN COUNTY - OHIO
SCALE: 1" = 100' JUNE 23-1970
Gary E. Penfound Reg. Surveyor No. 4457

NOTES: Heavy Line indicates lines actually surveyed.
● indicates iron pin set this or previous survey.

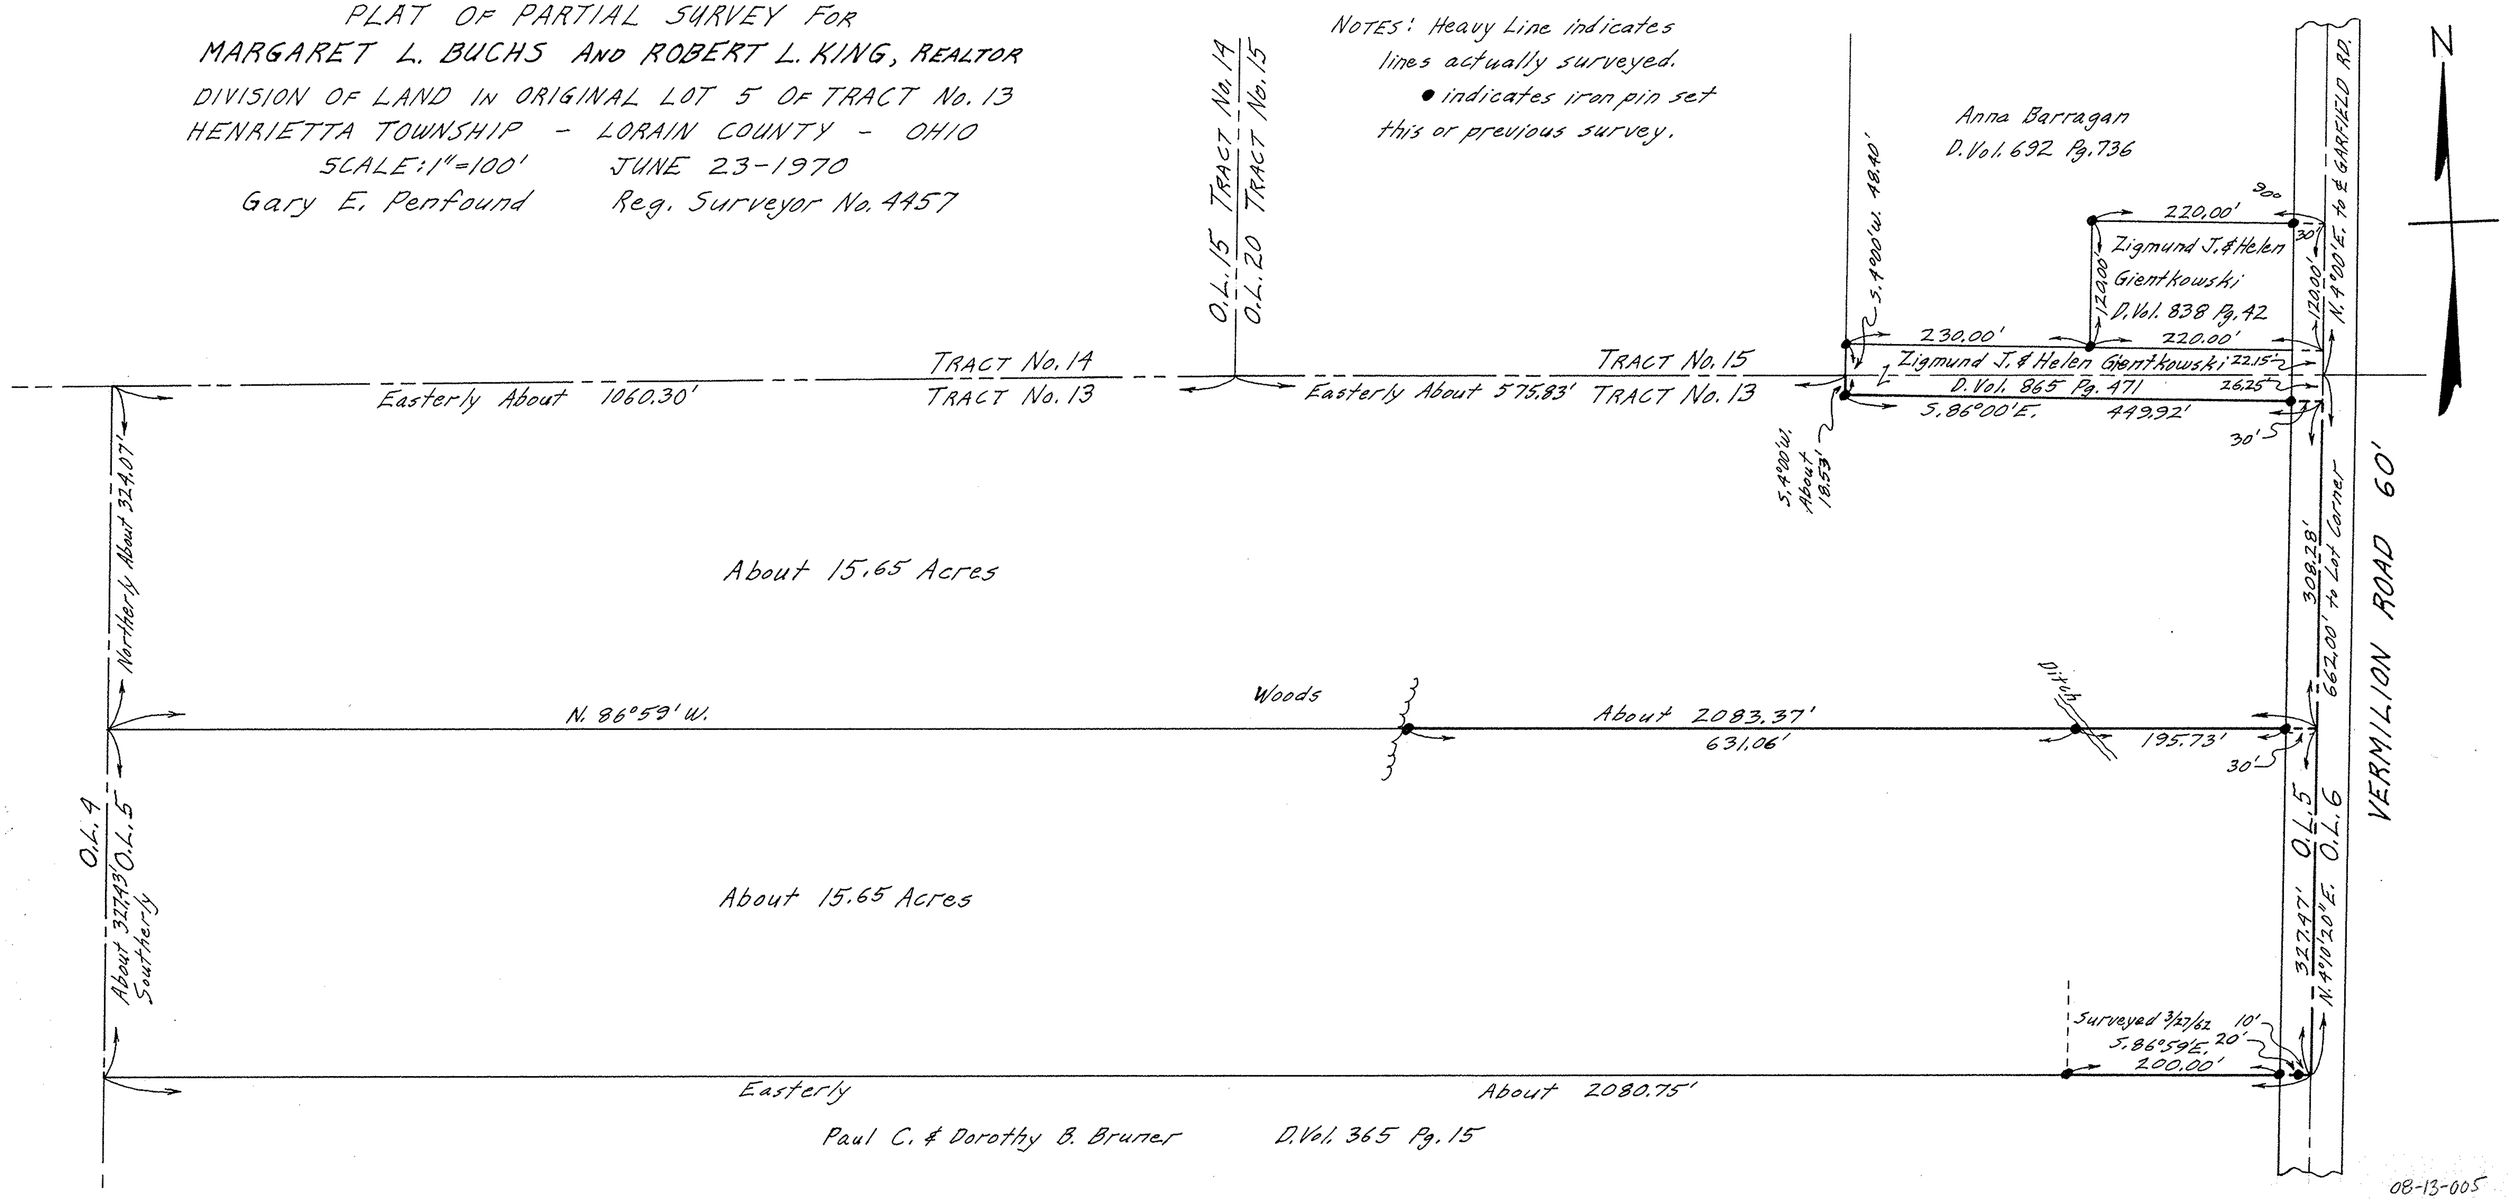


08-13-005