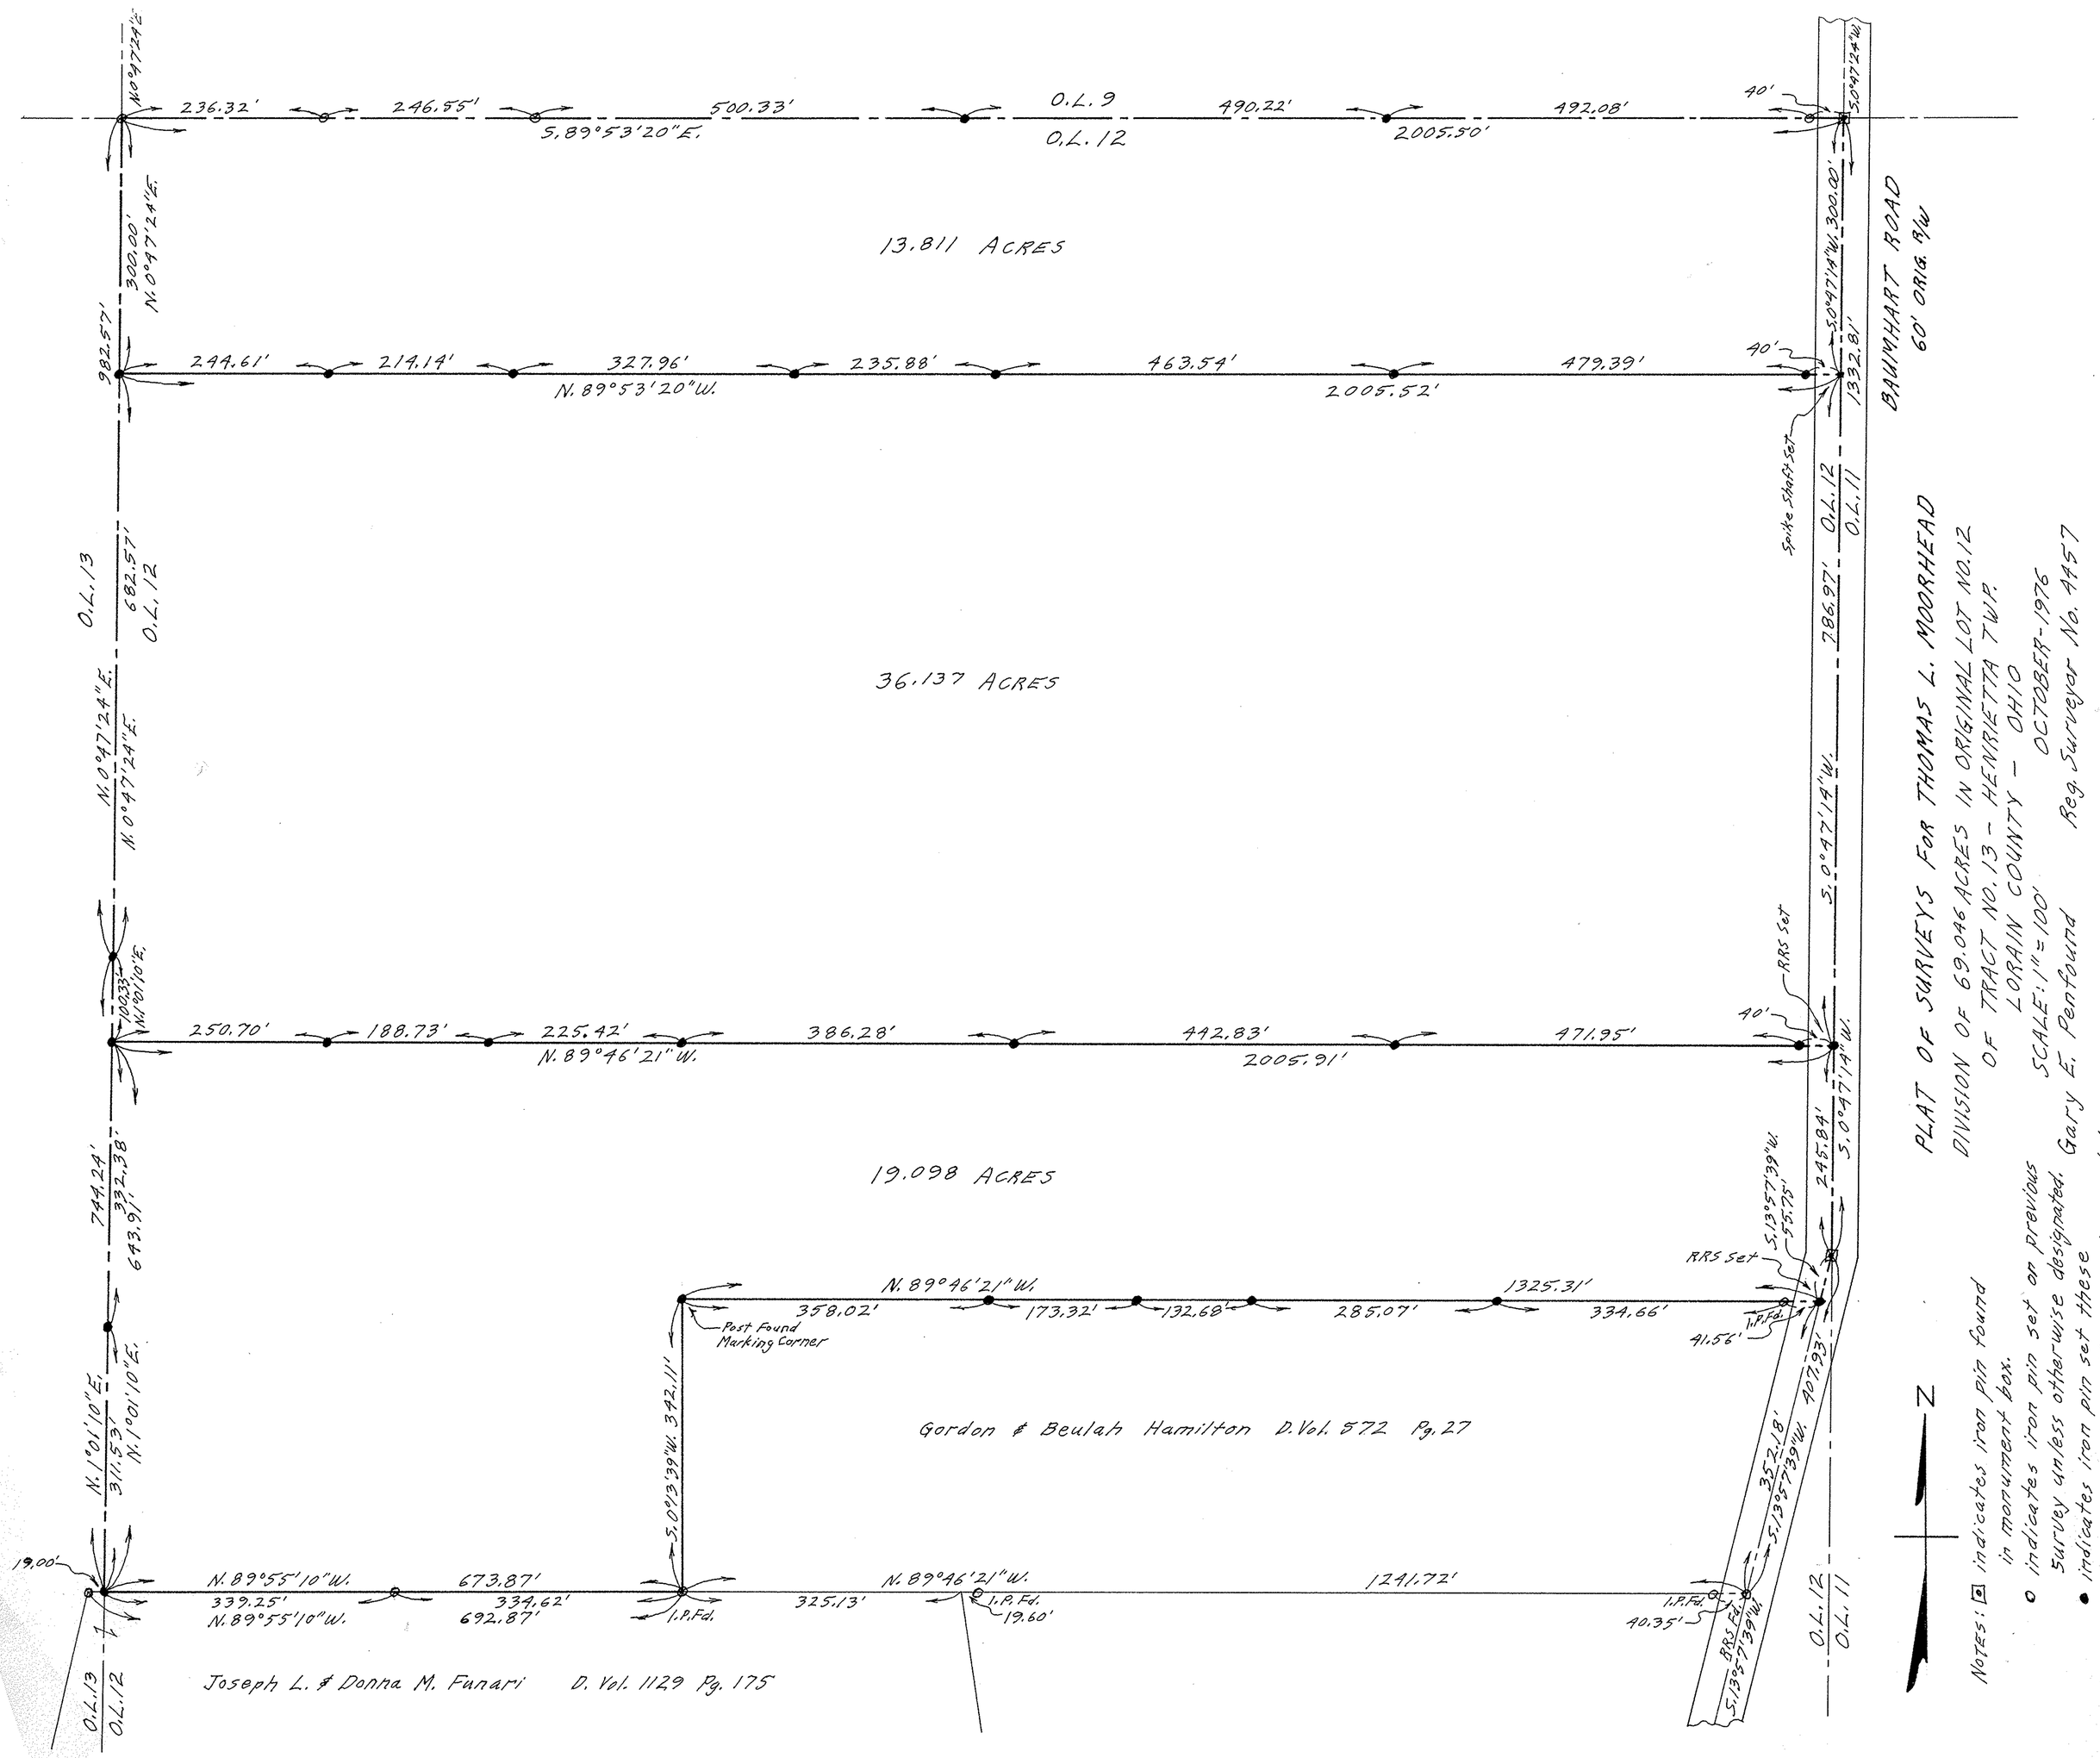

PLAT OF SURVEYS FOR THOMAS L. MOORHEAD
DIVISION OF 69.046 ACRES IN ORIGINAL LOT NO. 12
OF TRACT NO. 13 - HENRIETTA TWP.
LORAIN COUNTY - OHIO
SCALE: 1" = 100'
OCTOBER-1976
Gary E. Penfound
Reg. Surveyor No. 4457

NOTES: ▣ indicates iron pin found in monument box.
○ indicates iron pin set on previous survey unless otherwise designated.
● indicates iron pin set these surveys unless otherwise designated.

08-13-012