08-13-020

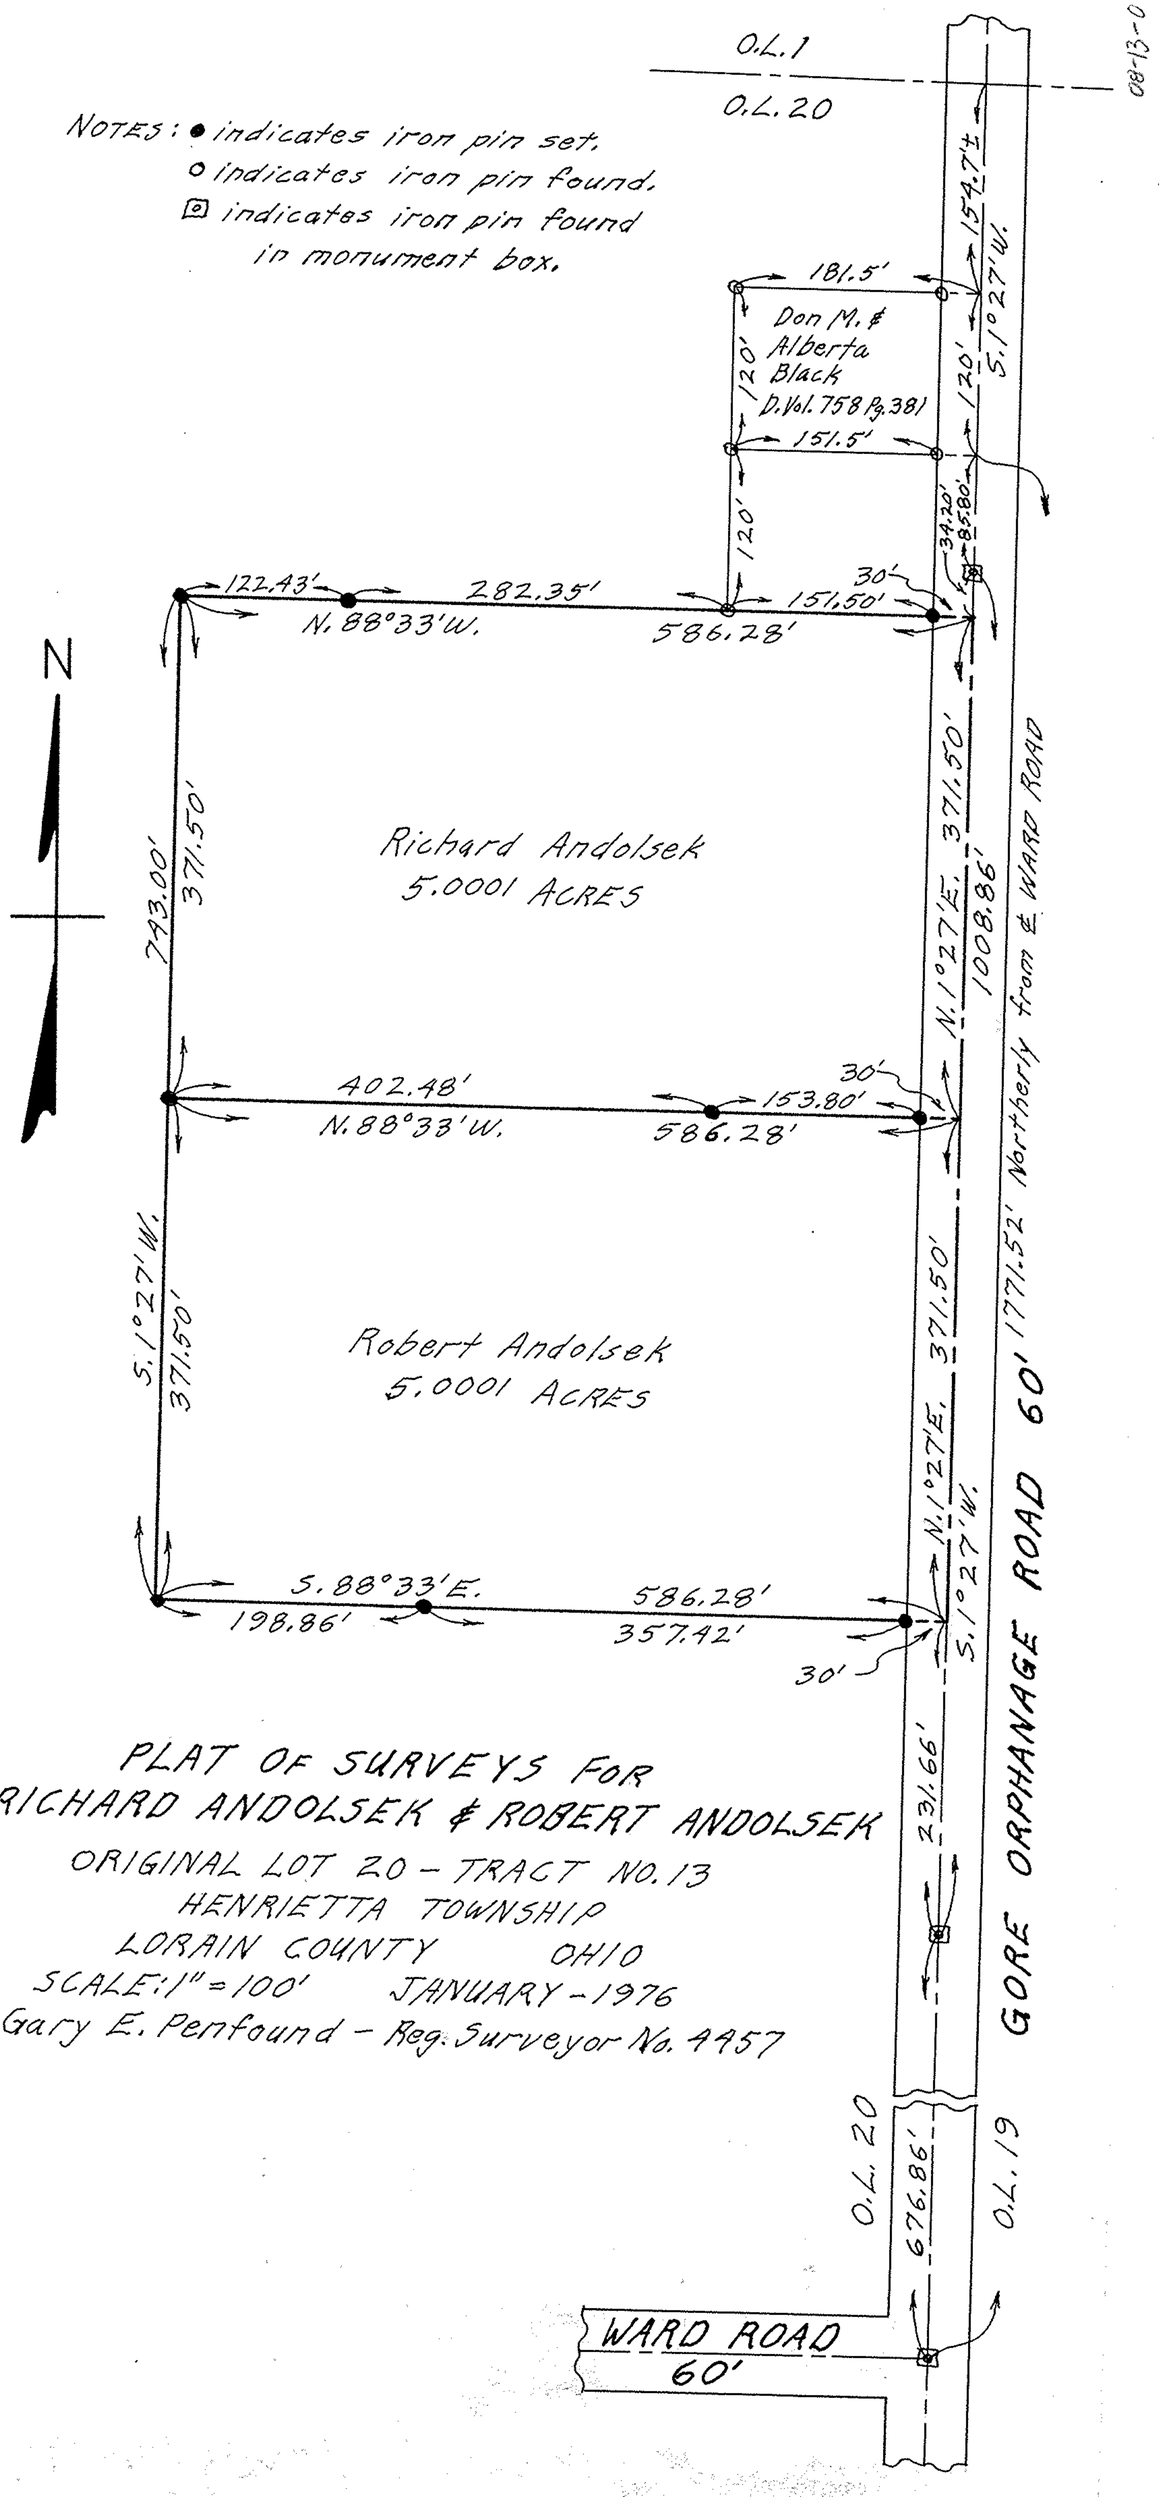

PLAT OF SURVEYS FOR RICHARD ANDOLSEK & ROBERT ANDOLSEK

ORIGINAL LOT 20 – TRACT NO. 13
HENRIETTA TOWNSHIP
LORAIN COUNTY OHIO
SCALE: 1" = 100' JANUARY – 1976
Gary E. Penfound – Reg. Surveyor No. 4457