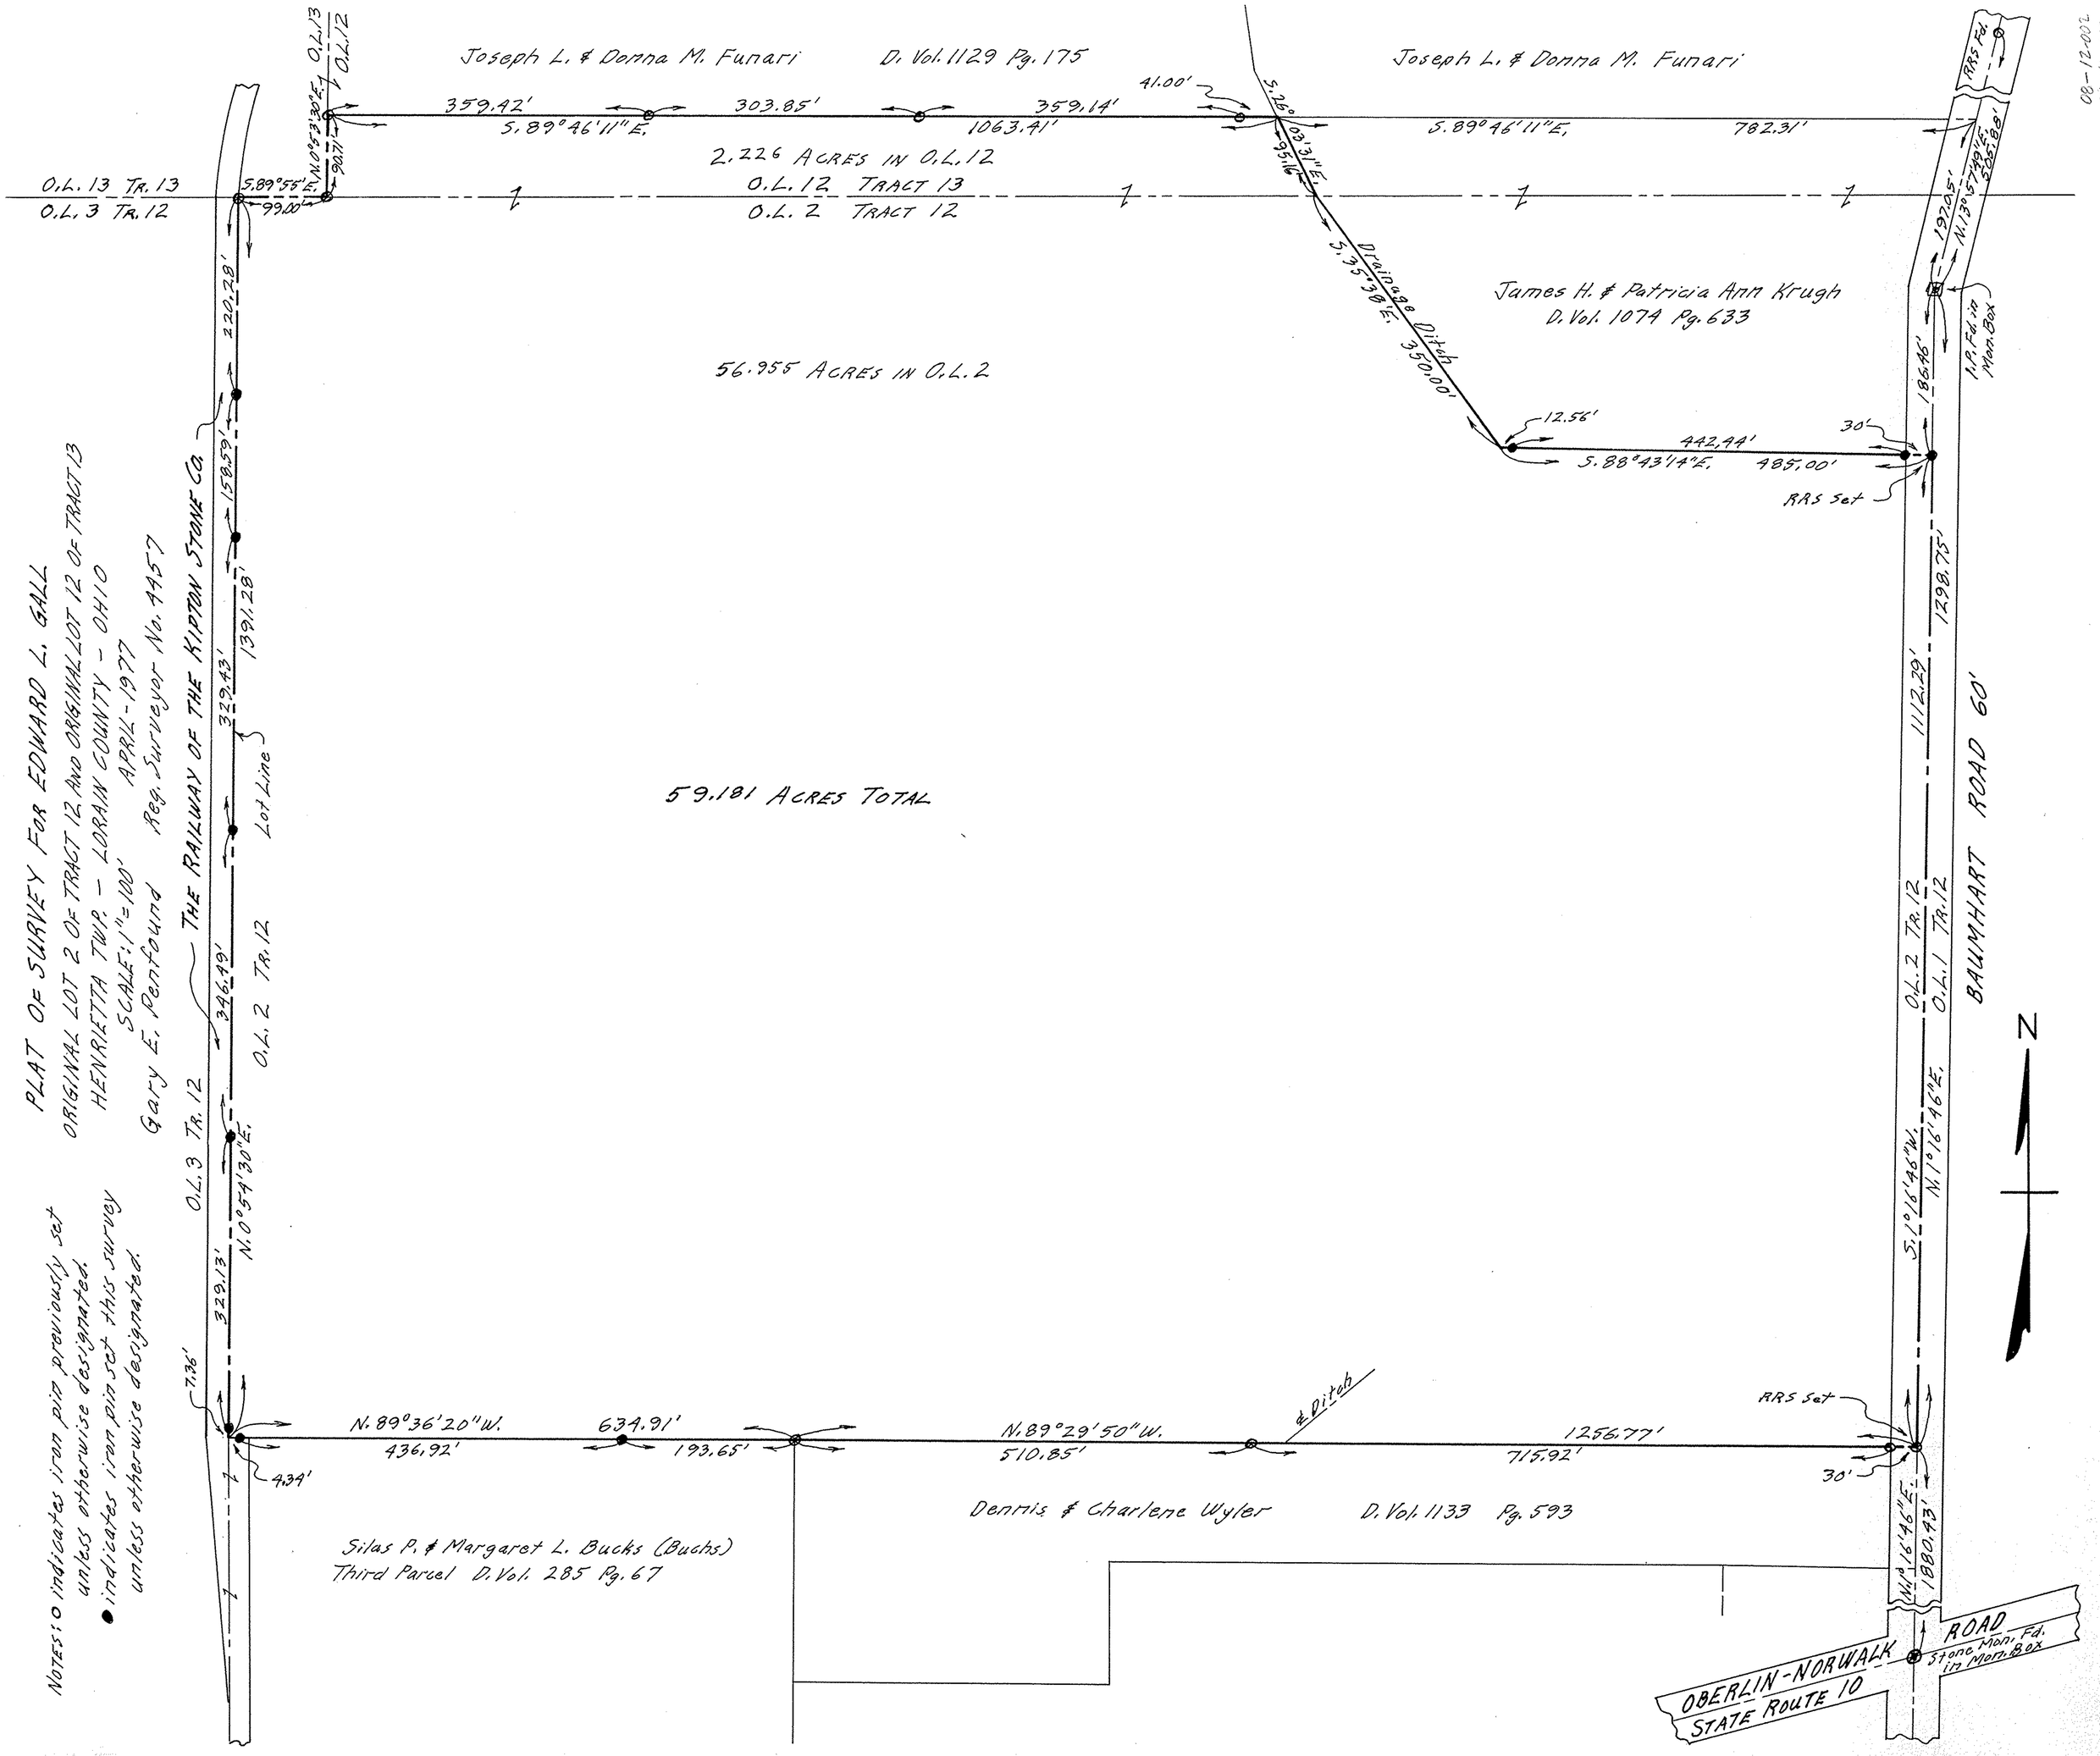
PLAT OF SURVEY FOR EDWARD L. GALL
ORIGINAL LOT 2 OF TRACT 12 AND ORIGINAL LOT 12 OF TRACT 13
HENRIETTA TWP. - LORAIN COUNTY - OHIO
SCALE: 1"=100'
APRIL-1977
Gary E. Renfound Reg. Surveyor No. 4457
NOTES: o indicates iron pin previously set unless otherwise designated.
● indicates iron pin set this survey unless otherwise designated.
Joseph L. & Donna M. Funari D. Vol. 1129 Pg. 175
Joseph L. & Donna M. Funari
2.226 ACRES IN O.L. 12
O.L. 12 TRACT 13
O.L. 2 TRACT 12
O.L. 13 TR. 13
O.L. 3 TR. 12
56.955 ACRES IN O.L. 2
59.181 ACRES TOTAL
James H. & Patricia Ann Krugh
D. Vol. 1074 Pg. 633
Drainage Ditch
THE RAILWAY OF THE KIPTON STONE CO.
Lot Line
O.L. 3 TR. 12
O.L. 2 TR. 12
O.L. 2 TR. 12
O.L. 1 TR. 12
BAUMHART ROAD 60'
RRS Set
Silas P. & Margaret L. Bucks (Buchs)
Third Parcel D. Vol. 285 Pg. 67
Dennis & Charlene Wyler D. Vol. 1133 Pg. 593
OBERLIN-NORWALK ROAD
STATE ROUTE 10
Stone Mon. Fd. in Mon. Box
N