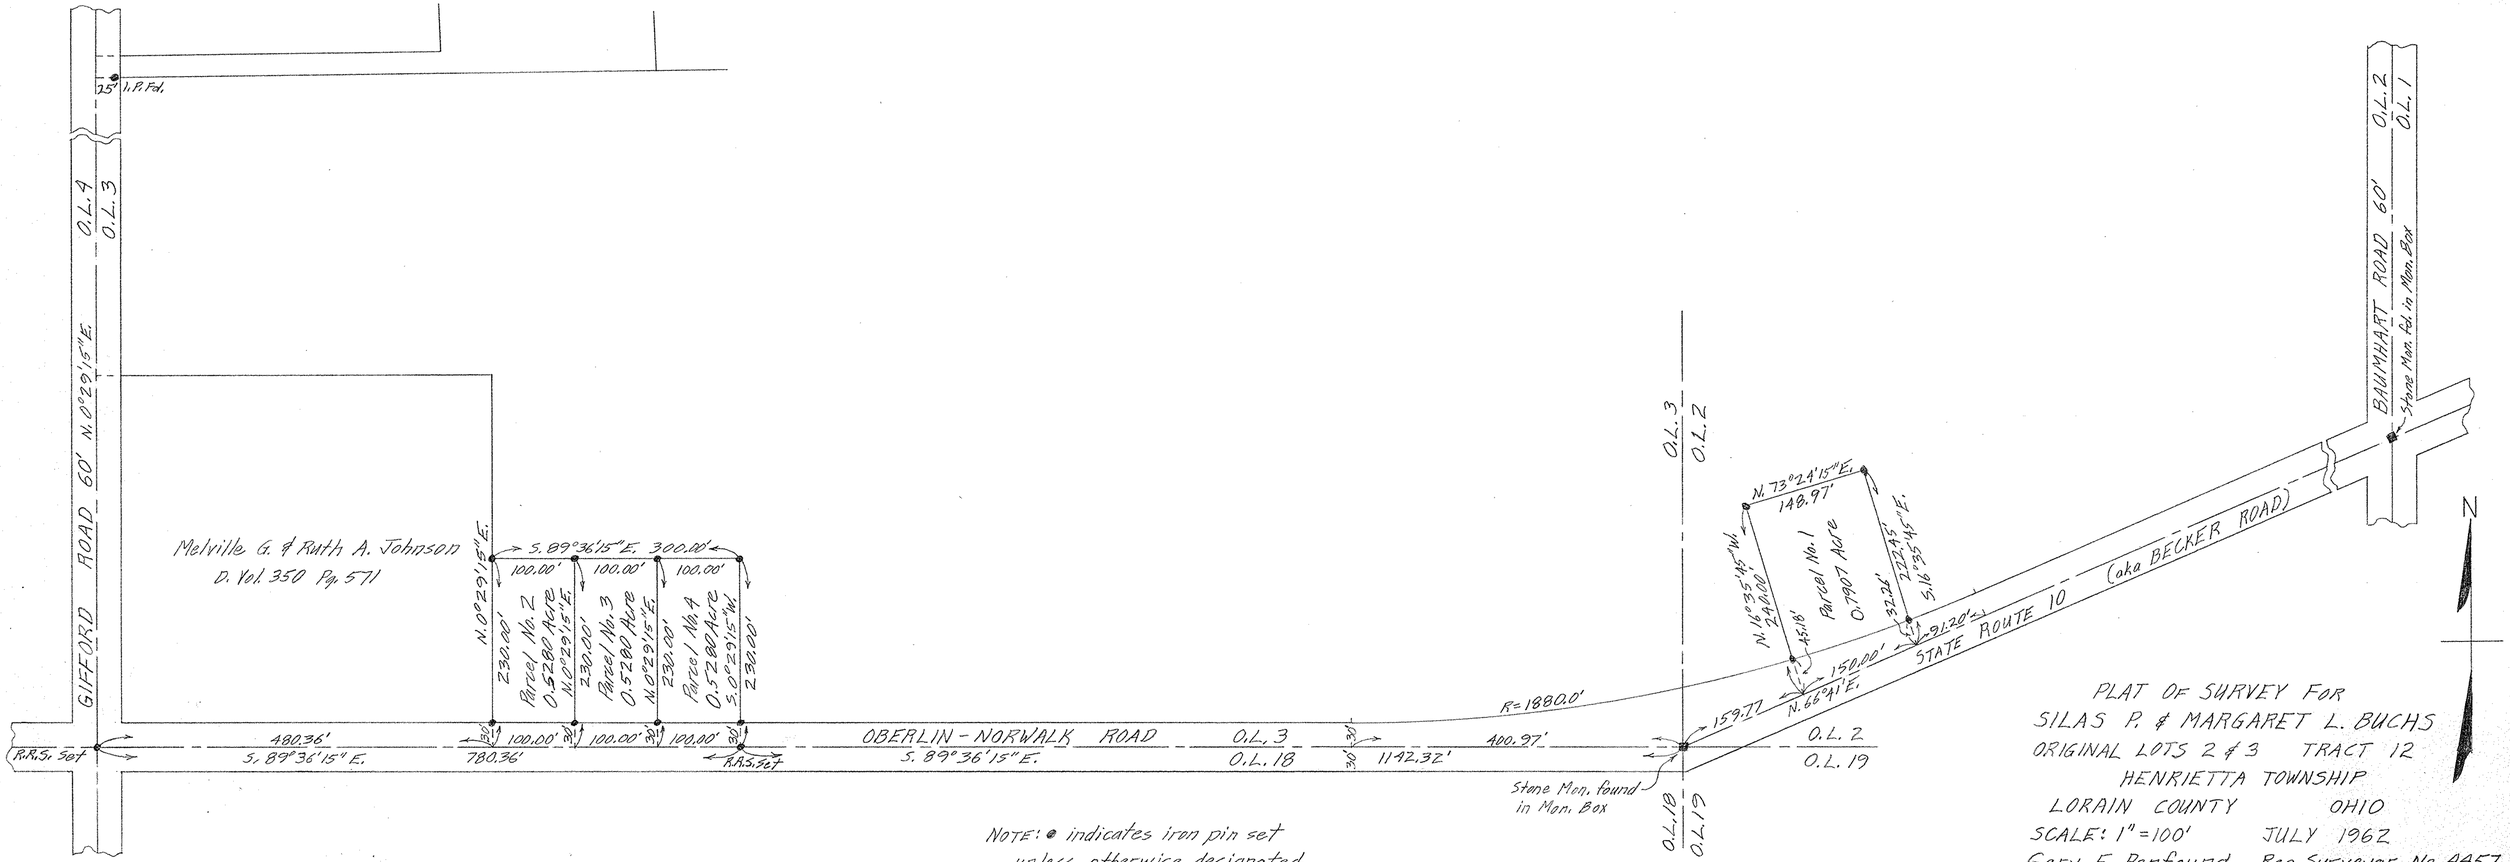

NOTE: ● indicates iron pin set
unless otherwise designated.

PLAT OF SURVEY FOR
SILAS P. & MARGARET L. BUCHS
ORIGINAL LOTS 2 & 3 TRACT 12
HENRIETTA TOWNSHIP
LORAIN COUNTY OHIO
SCALE: 1" = 100' JULY 1962
Gary E. Penfound Reg. Surveyor No. 4457

08-12-002,003