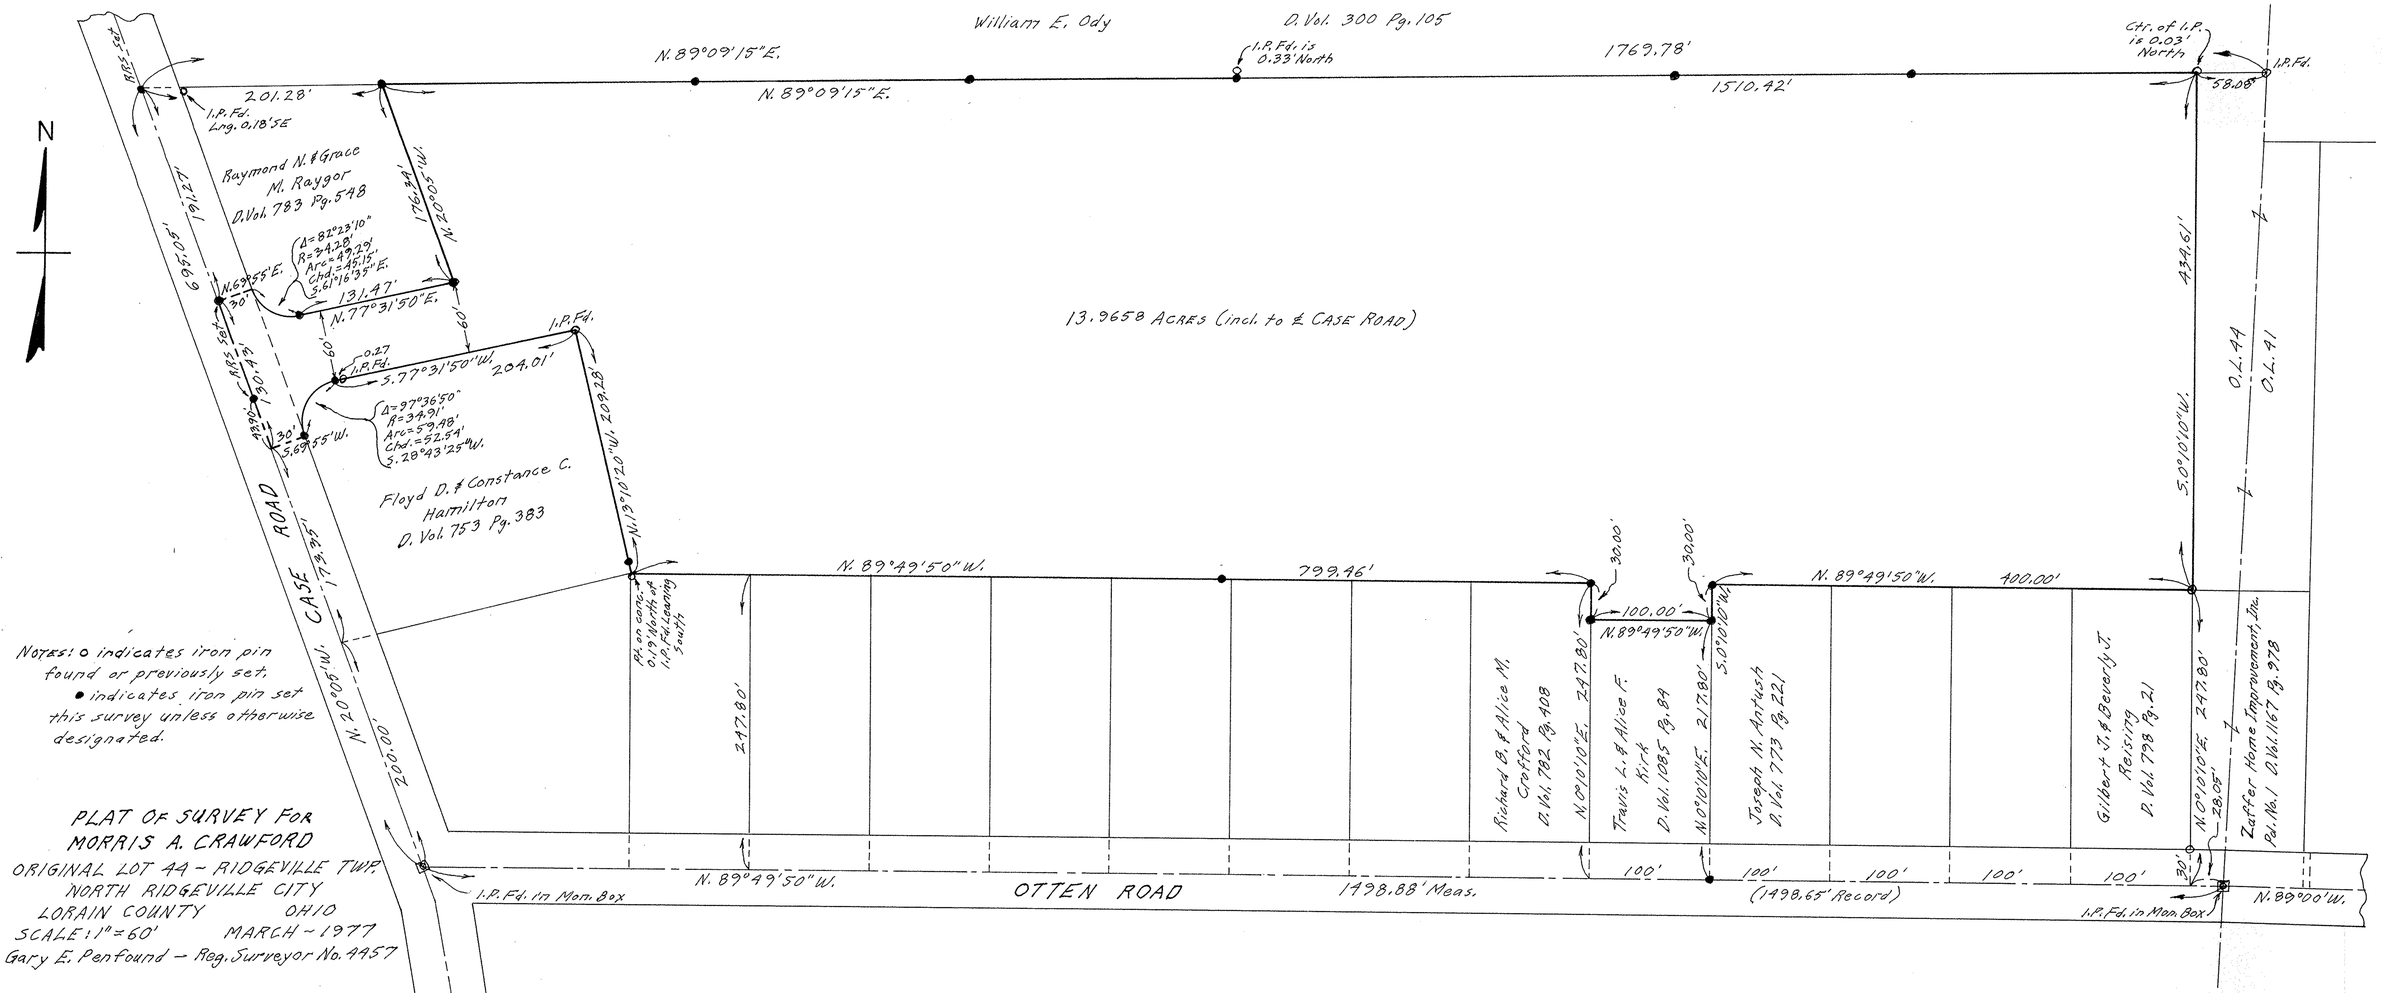

Notes: ○ indicates iron pin found or previously set.
● indicates iron pin set this survey unless otherwise designated.

PLAT OF SURVEY FOR MORRIS A. CRAWFORD

ORIGINAL LOT 44 – RIDGEVILLE TWP.
NORTH RIDGEVILLE CITY
LORAIN COUNTY OHIO
SCALE: 1" = 60' MARCH – 1977
Gary E. Penfound – Reg. Surveyor No. 4957