PLAT OF SURVEY FOR
CLARENCE F. & CATHERINE E. HAMKER
ORIGINAL LOTS NOS. 13-14 & 23 RIDGEVILLE TOWNSHIP
NORTH RIDGEVILLE CITY
LORAIN COUNTY OHIO
SCALE: 1" = 60' MAY-1974
Gary E. Pentound Reg. Surveyor No. 4457
REVISED JUNE 11-1974 FOR ACREAGE INCREASE

NOTE: ● indicates iron pin set on this or prior Surveys unless otherwise designated.

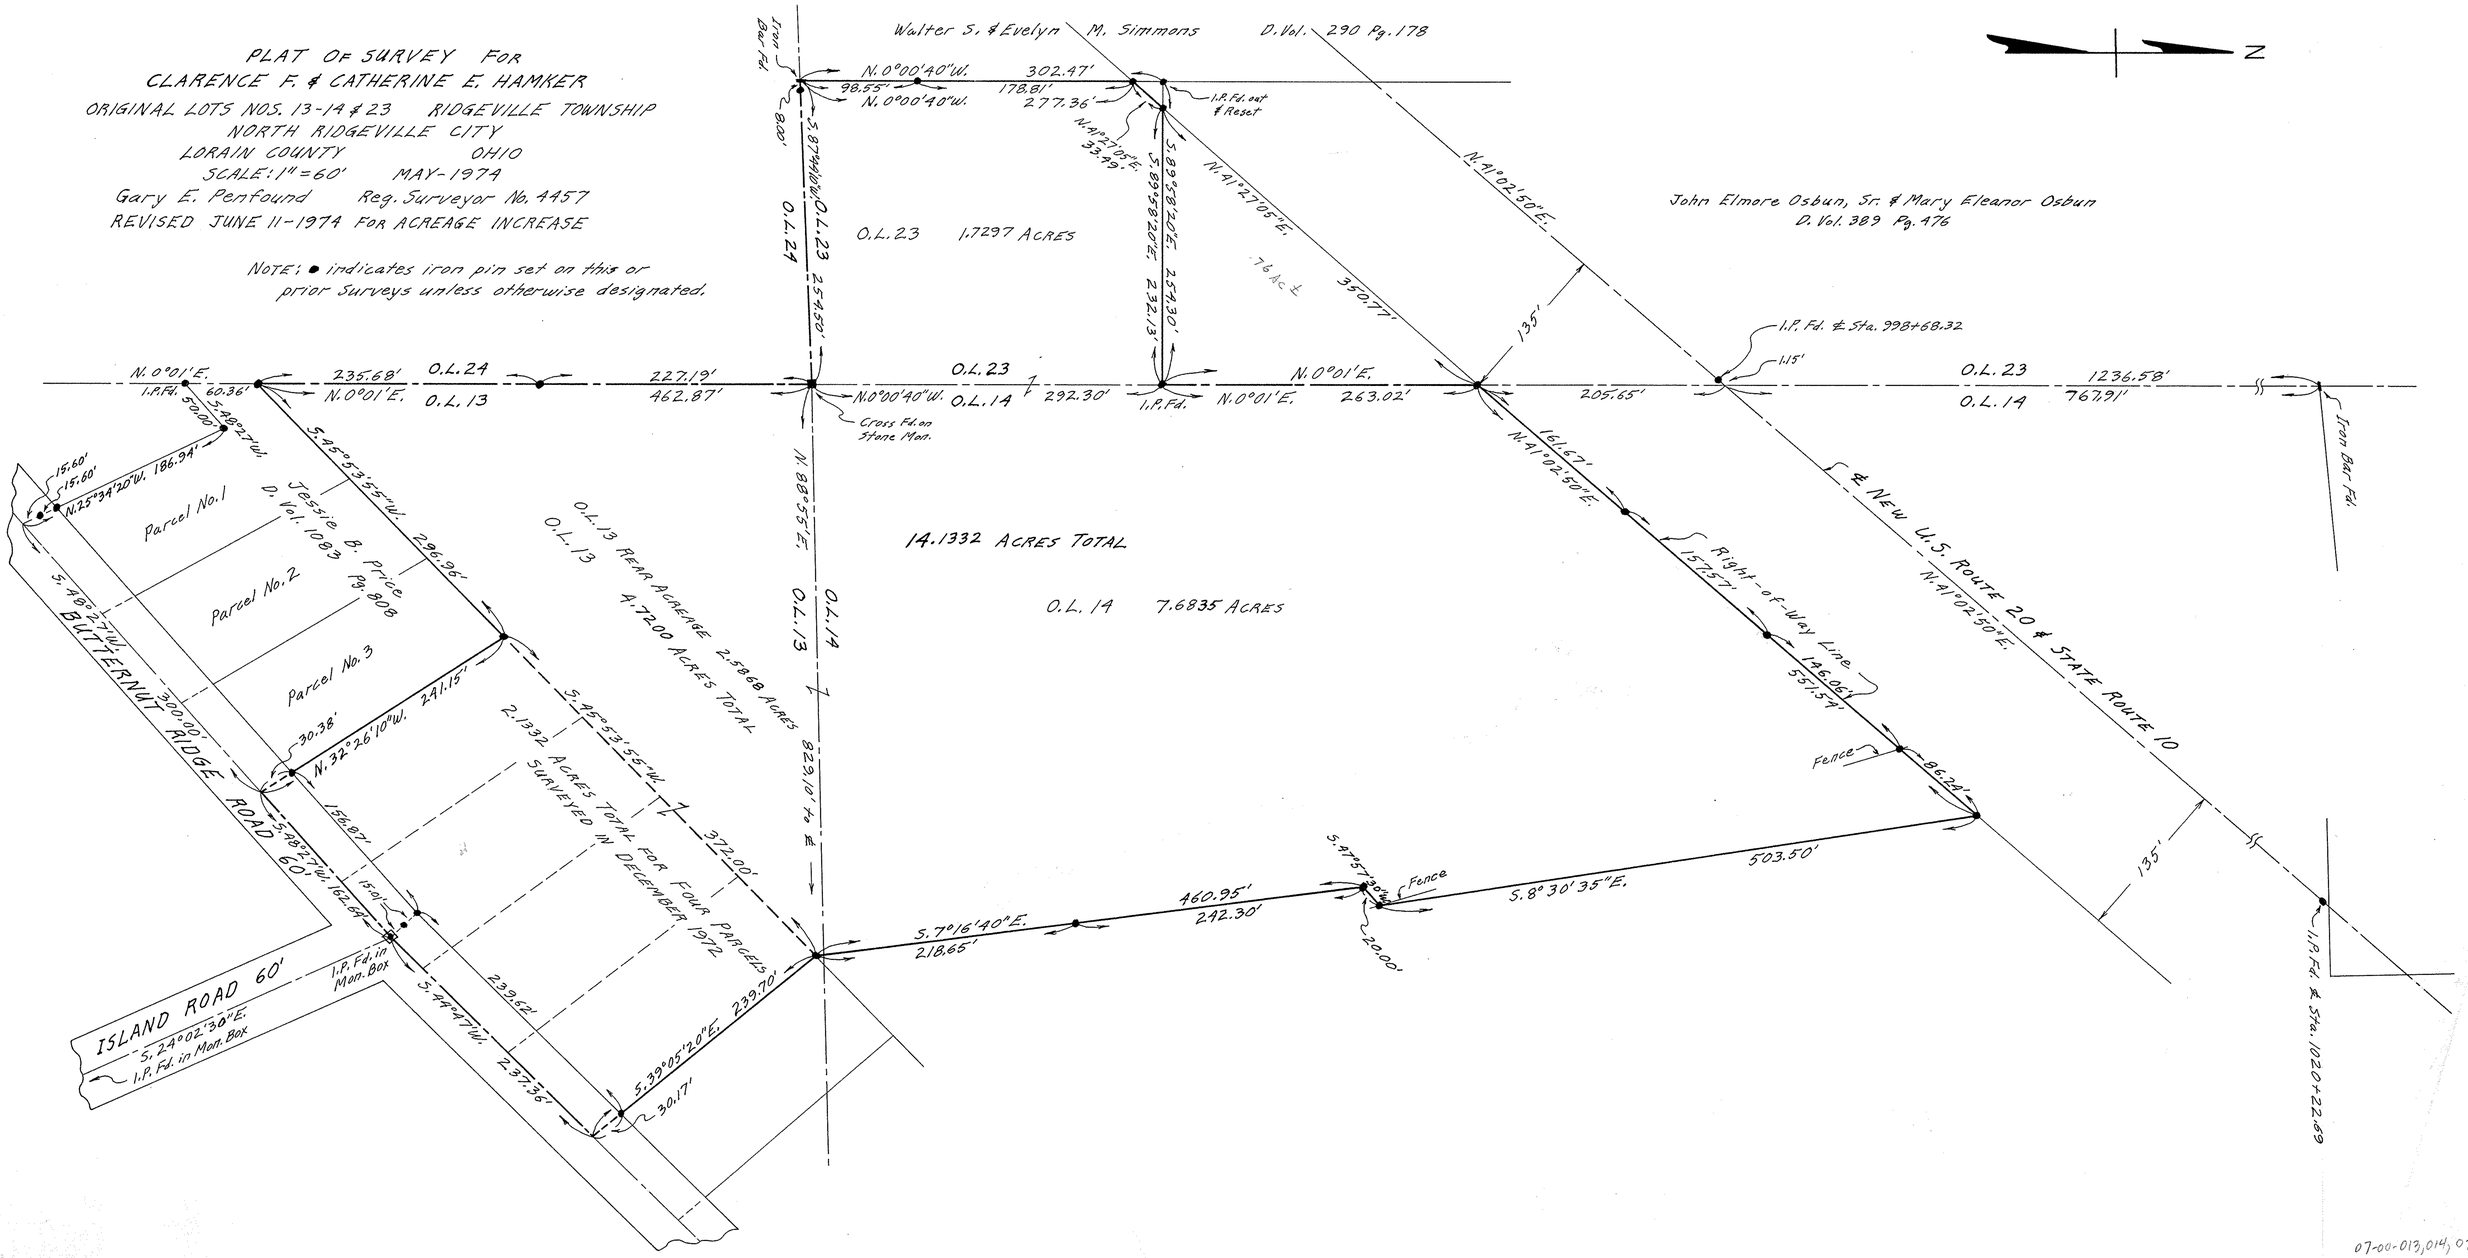

07-00-013,014, 023