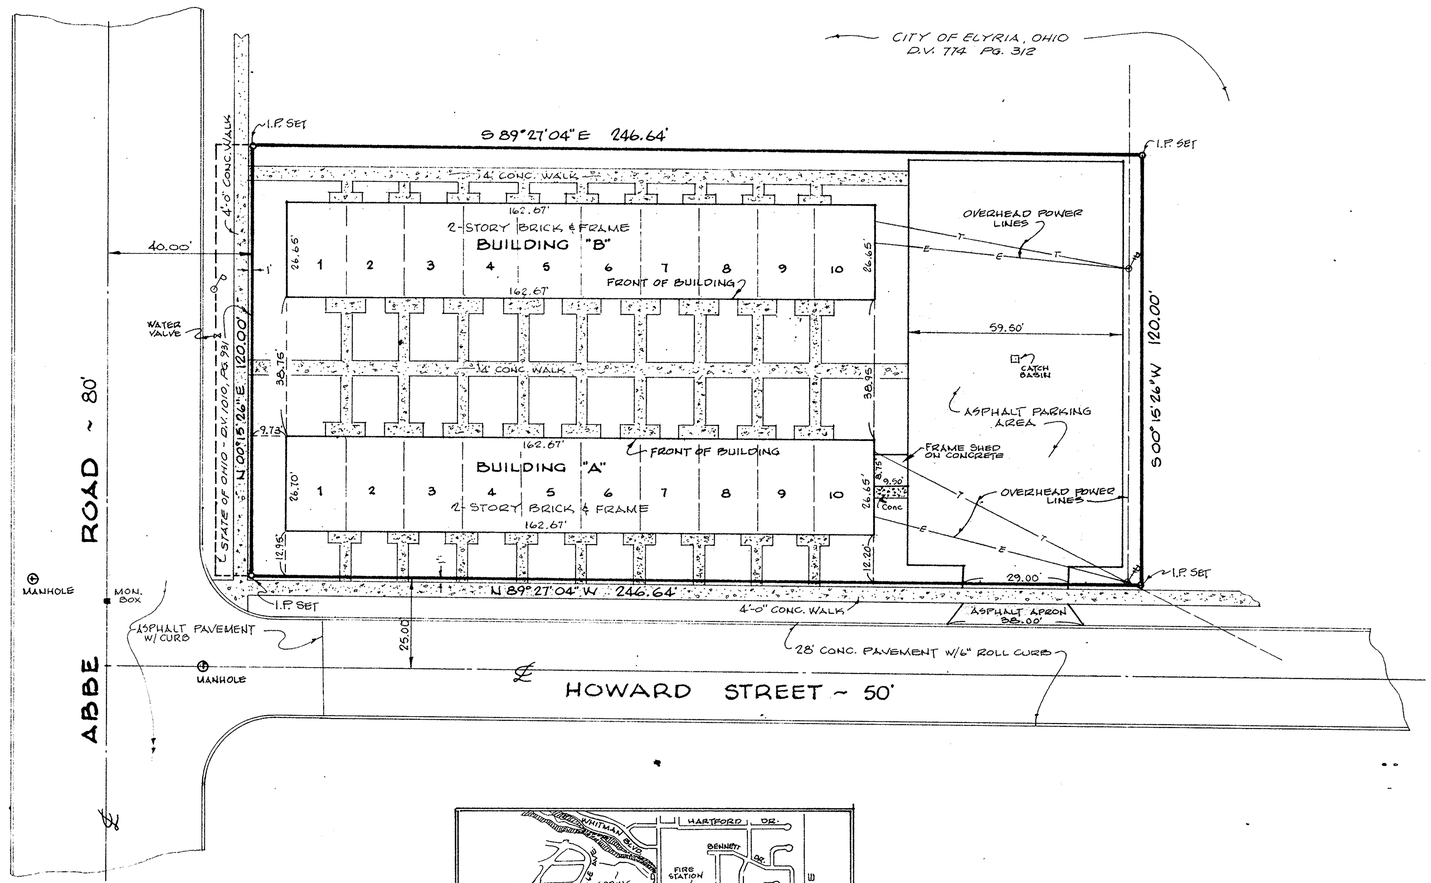

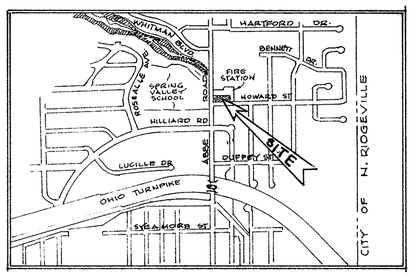

LOCATION PLAN
SCALE: NONE

NORTH

NORTH

• NOTE THAT THE FRONTS OF BUILDINGS "A" and "B" FACE EACH OTHER. BUILDING "B" IS CONSTRUCTED THE SAME AS BUILDING "A"

STATEMENT OF CERTIFICATION

I DO HEREBY CERTIFY THAT THE WITHIN DRAWINGS ACCURATELY REPRESENT THE DIMENSIONS OF THE BUILDINGS AS CONSTRUCTED AND THAT THERE ARE NO ENCROACHMENTS ONTO ANY ABUTTING PREMISES.

Lawrence V. McGlinchy
LAWRENCE V. McGLINCHY
REGISTERED SURVEYOR No. 4970

PREPARED FOR: WESTWOOD PROPERTIES Co.
ELYRIA OHIO

PREPARED BY: McGLINCHY and ASSOCIATES INC.
REGISTERED ENGINEER & SURVEYORS
ELYRIA OHIO

PLAT OF SURVEY and LOCATION PLAN
OF

ABBE COURT CONDOMINIUMS

PART OF ORIGINAL ELYRIA TOWNSHIP LOT NO. 26 EAST OF BLACK RIVER
CITY OF ELYRIA LORAIN COUNTY OHIO
FEBRUARY, 1980 SCALE: 1"=20'

LORAIN COUNTY AUDITOR	LORAIN COUNTY RECORDER