PLAT OF SURVEY FOR MYLES KNECHTGES
3.8693 ACRES OF LAND IN ORIGINAL LOT NO. 79
RUSSIA TOWNSHIP LORAIN COUNTY OHIO
SCALE: 1" = 20' NOVEMBER 24, 1958
GARY E. PENFOUND REGISTERED SURVEYOR NO. 4457

NOTE: ● indicates iron pin set.

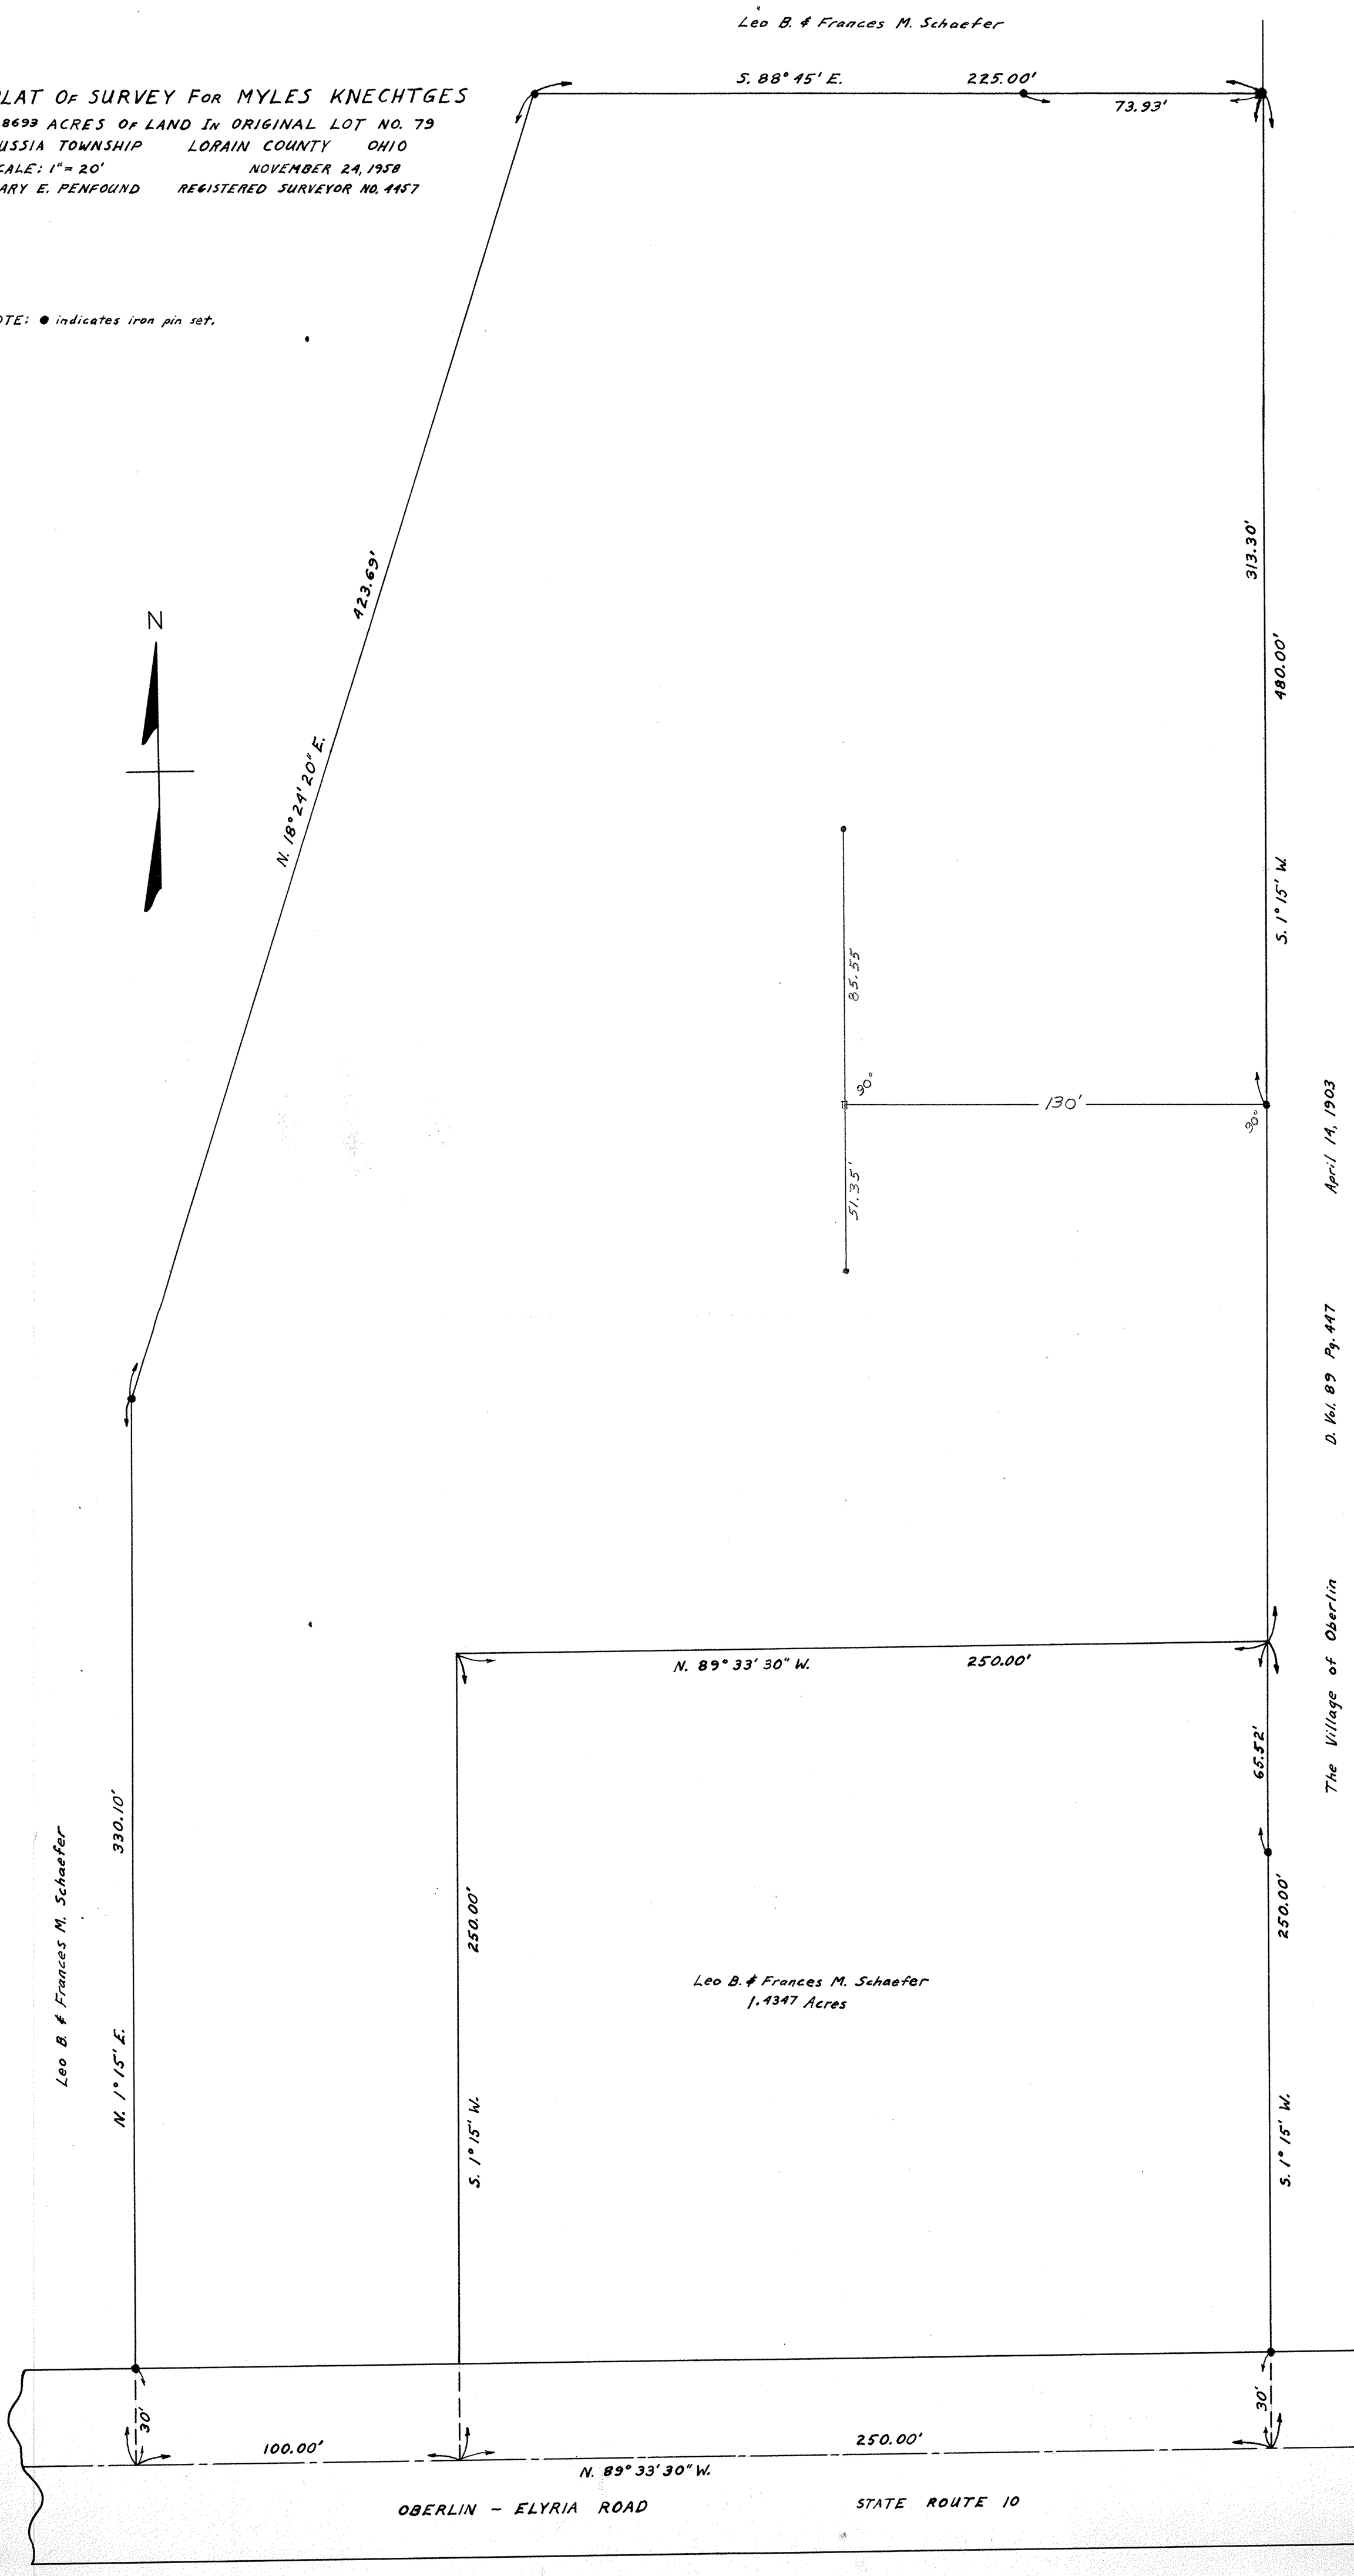


09-00-079