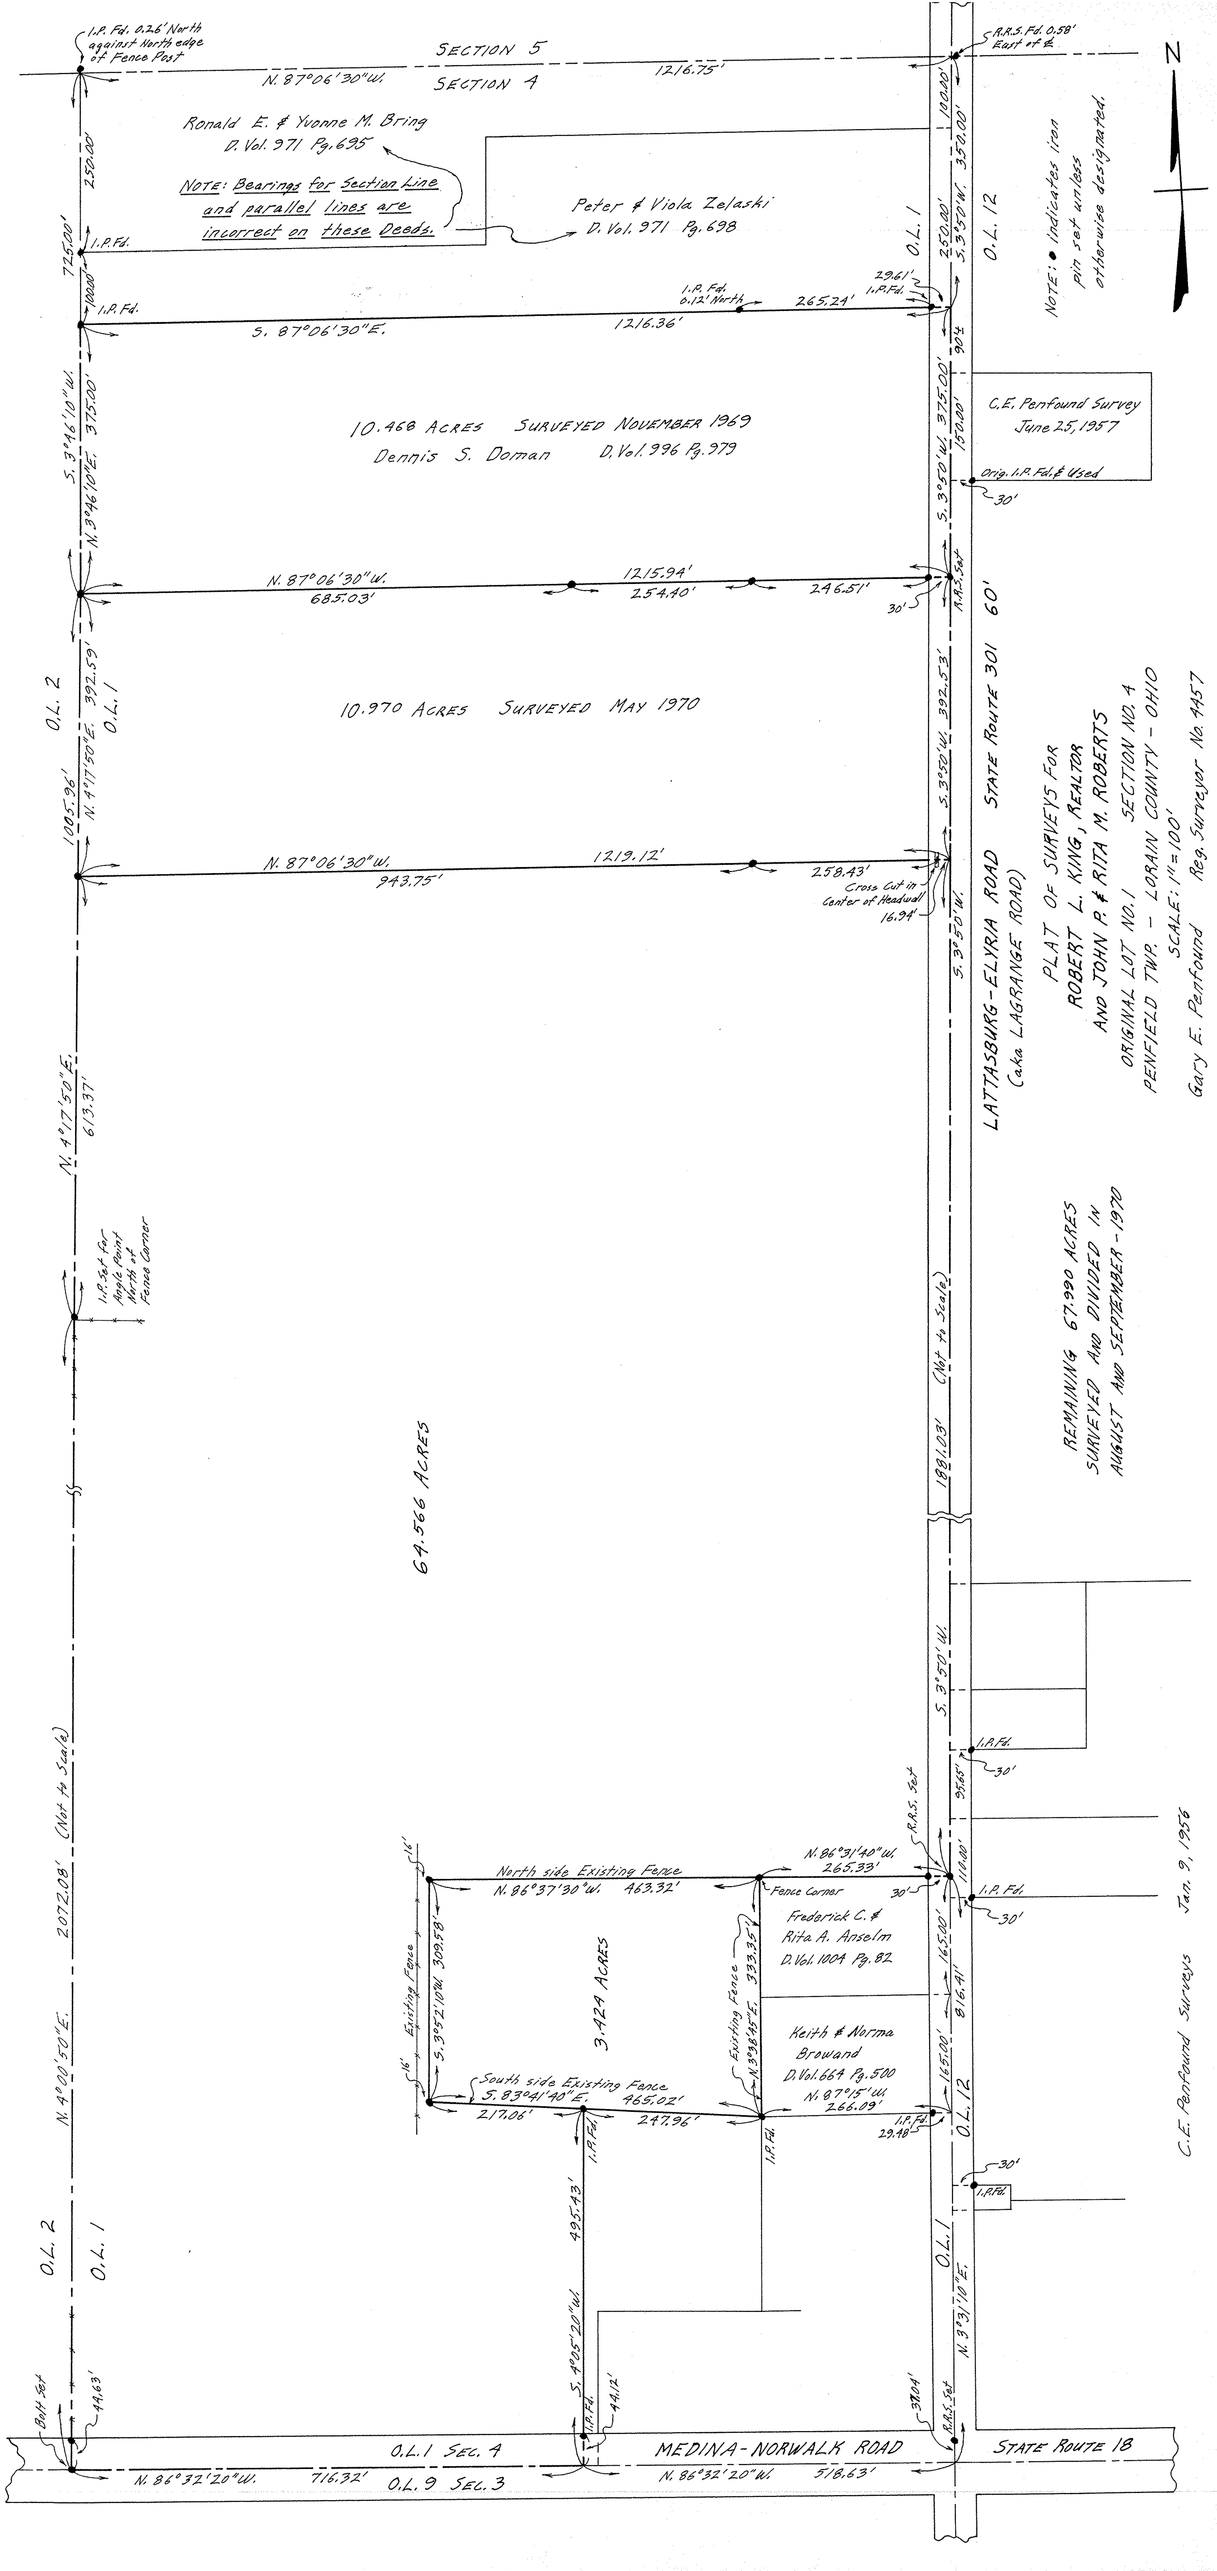
19-04-001
N
SECTION 5
SECTION 4
I.P. Fd. 0.26' North against North edge of Fence Post
N. 87°06'30"W.
1216.75'
R.R.S. Fd. 0.58' East of ℄
Ronald E. & Yvonne M. Bring
D. Vol. 971 Pg. 695
NOTE: Bearings for Section Line and parallel lines are incorrect on these Deeds.
Peter & Viola Zelaski
D. Vol. 971 Pg. 698
O.L. 1
O.L. 12
NOTE: ● indicates iron pin set unless otherwise designated.
I.P. Fd.
I.P. Fd. 0.12' North
265.24'
S. 87°06'30"E.
1216.36'
10.468 ACRES SURVEYED NOVEMBER 1969
Dennis S. Doman D. Vol. 996 Pg. 979
C.E. Penfound Survey June 25, 1957
Orig. I.P. Fd. & Used
S. 3°46'10"W.
N. 3°46'10"E.
N. 87°06'30"W.
1215.94'
685.03'
254.40'
246.51'
R.R.S. Set
10.970 ACRES SURVEYED MAY 1970
O.L. 2
O.L. 1
N. 4°17'50"E.
1005.96'
392.59'
N. 87°06'30"W.
1219.12'
943.75'
258.43'
Cross Cut in Center of Headwall
16.94'
S. 3°50'W.
LATTASBURG-ELYRIA ROAD (aka LAGRANGE ROAD)
STATE ROUTE 301
60'
PLAT OF SURVEYS FOR
ROBERT L. KING, REALTOR
AND JOHN P. & RITA M. ROBERTS
ORIGINAL LOT NO. 1 SECTION NO. 4
PENFIELD TWP. - LORAIN COUNTY - OHIO
SCALE: 1" = 100'
Gary E. Penfound Reg. Surveyor No. 4457
N. 4°17'50"E.
613.37'
I.P. Set for Angle Point North of Fence Corner
(Not to Scale)
188.03'
REMAINING 67.990 ACRES
SURVEYED AND DIVIDED IN
AUGUST AND SEPTEMBER - 1970
64.566 ACRES
S. 3°50'W.
I.P. Fd.
30'
R.R.S. Set
N. 86°31'40"W.
265.33'
North side Existing Fence
N. 86°37'30"W. 463.32'
Fence Corner
Frederick C. & Rita A. Anselm
D. Vol. 1004 Pg. 82
3.424 ACRES
Existing Fence
S. 3°52'10"W. 309.58'
N. 3°38'45"E. 333.35'
Keith & Norma Broward
D. Vol. 664 Pg. 500
N. 87°15'W.
266.09'
South side Existing Fence
S. 83°41'40"E. 465.02'
217.06'
247.96'
29.48'
N. 4°00'50"E.
2072.08'
(Not to Scale)
O.L. 2
O.L. 1
O.L. 12
O.L. 1
N. 3°31'10"E.
495.43'
S. 4°05'20"W.
44.12'
44.63'
Bolt Set
R.R.S. Set
37.04'
O.L. 1 SEC. 4
MEDINA-NORWALK ROAD
STATE ROUTE 18
N. 86°32'20"W.
716.32'
O.L. 9 SEC. 3
N. 86°32'20"W.
518.63'
C.E. Penfound Surveys Jan. 9, 1956