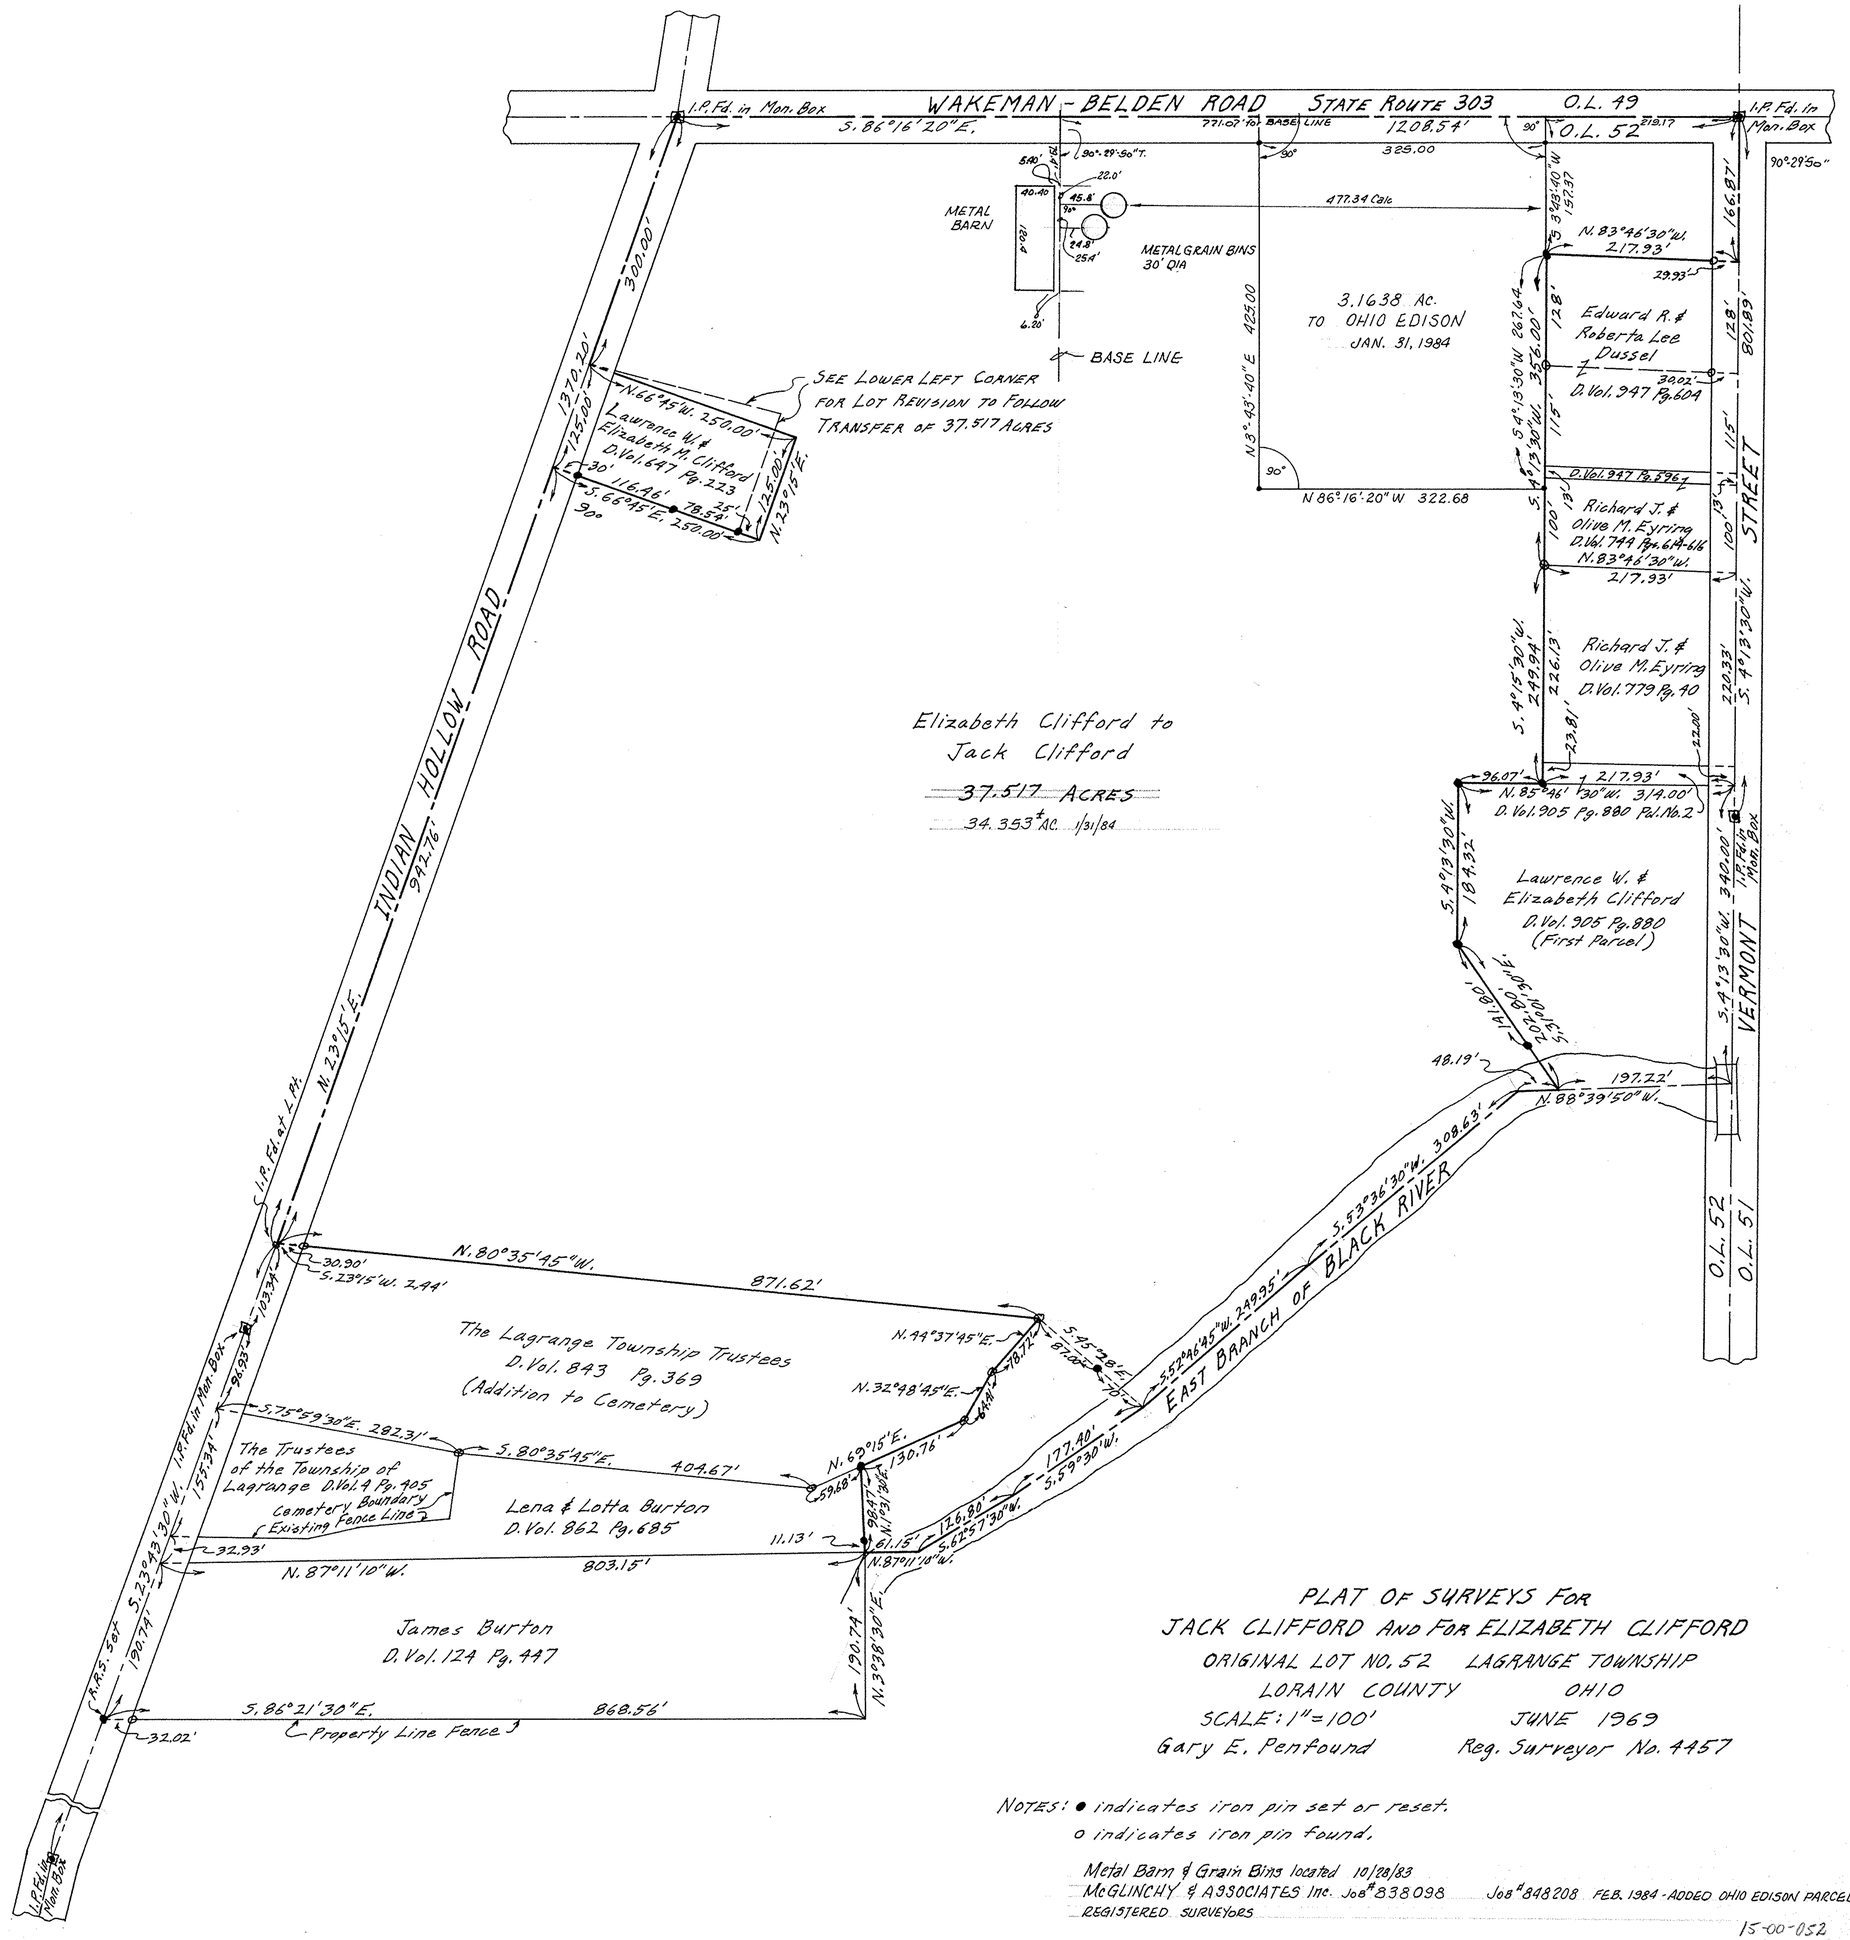

PLAT OF SURVEYS FOR
JACK CLIFFORD AND FOR ELIZABETH CLIFFORD
ORIGINAL LOT NO. 52 LAGRANGE TOWNSHIP
LORAIN COUNTY OHIO
SCALE: 1" = 100' JUNE 1969
Gary E. Penfound Reg. Surveyor No. 4457

NOTES: ● indicates iron pin set or reset.
o indicates iron pin found.

Metal Barn & Grain Bins located 10/28/83
McGLINCHY & ASSOCIATES Inc. Job #838098 Job #848208 FEB. 1984 - ADDED OHIO EDISON PARCEL
REGISTERED SURVEYORS

15-00-052