PLAT OF SURVEY FOR THE TRUSTEES OF LAGRANGE TOWNSHIP

PART OF LAND OF LESLIE KNOWLES

ORIGINAL LOT No. 52 — LAGRANGE TOWNSHIP

LORAIN COUNTY — OHIO

SCALE: 1" = 30' — JULY 25-1962

Gary E. Penfound — Reg. Surveyor No. 4457

NOTE: • indicates iron pin set unless otherwise designated.

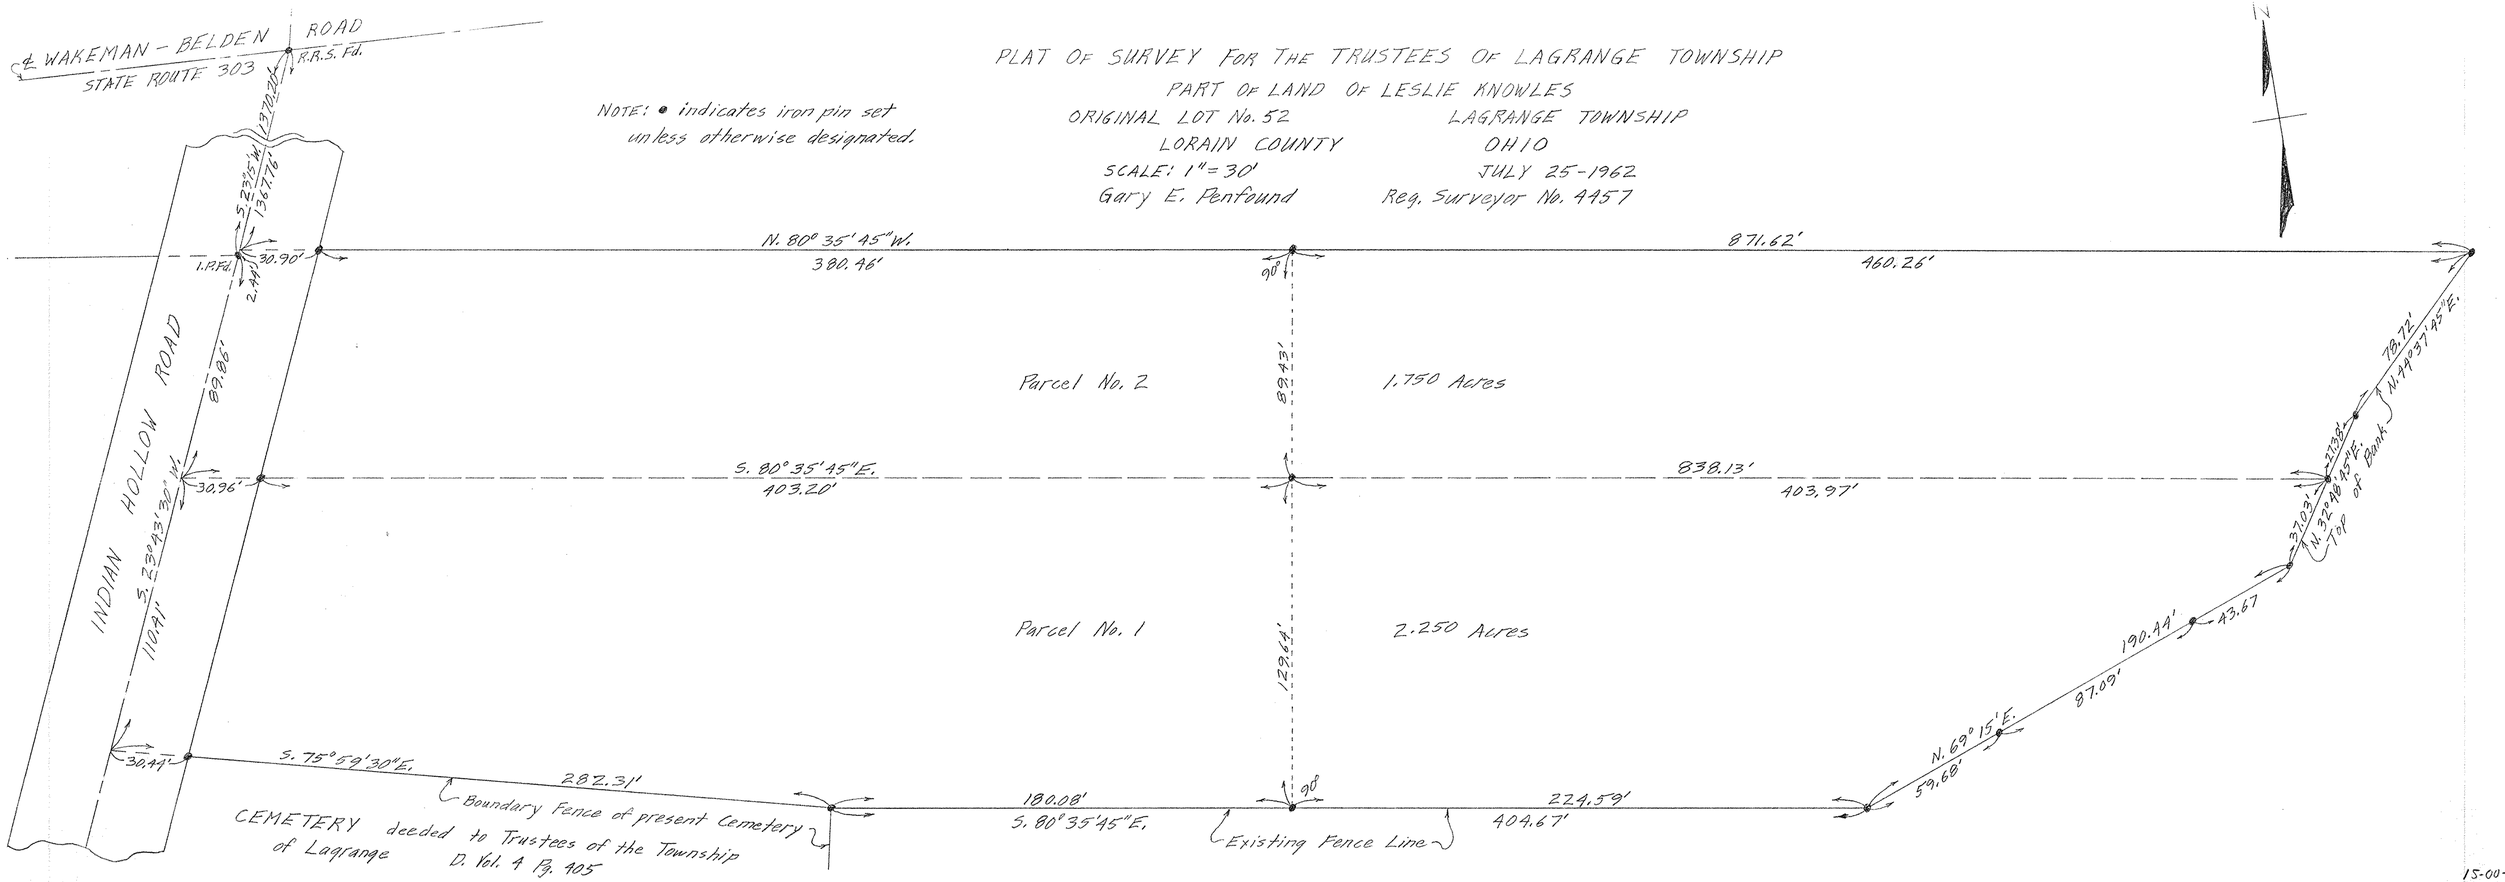

15-00-052