PLAT OF RE-SURVEYING OF EASEMENTS FOR BUCKEYE PIPE LINE COMPANY

AND FIVE PROPERTY PINS RESET ON LINE BETWEEN GRAFTON VILLAGE DISPOSAL PLANT AND McALPIN IN ORIGINAL LOT 100 OF EATON TWP. AND A CORNER OF ORIGINAL LOT 1 OF GRAFTON TWP. — BOTH IN GRAFTON VILLAGE – LORAIN COUNTY – OHIO

SCALE: 1" = 60' OCTOBER & NOVEMBER - 1975

Gary E. Renfound Reg. Surveyor No. 4457

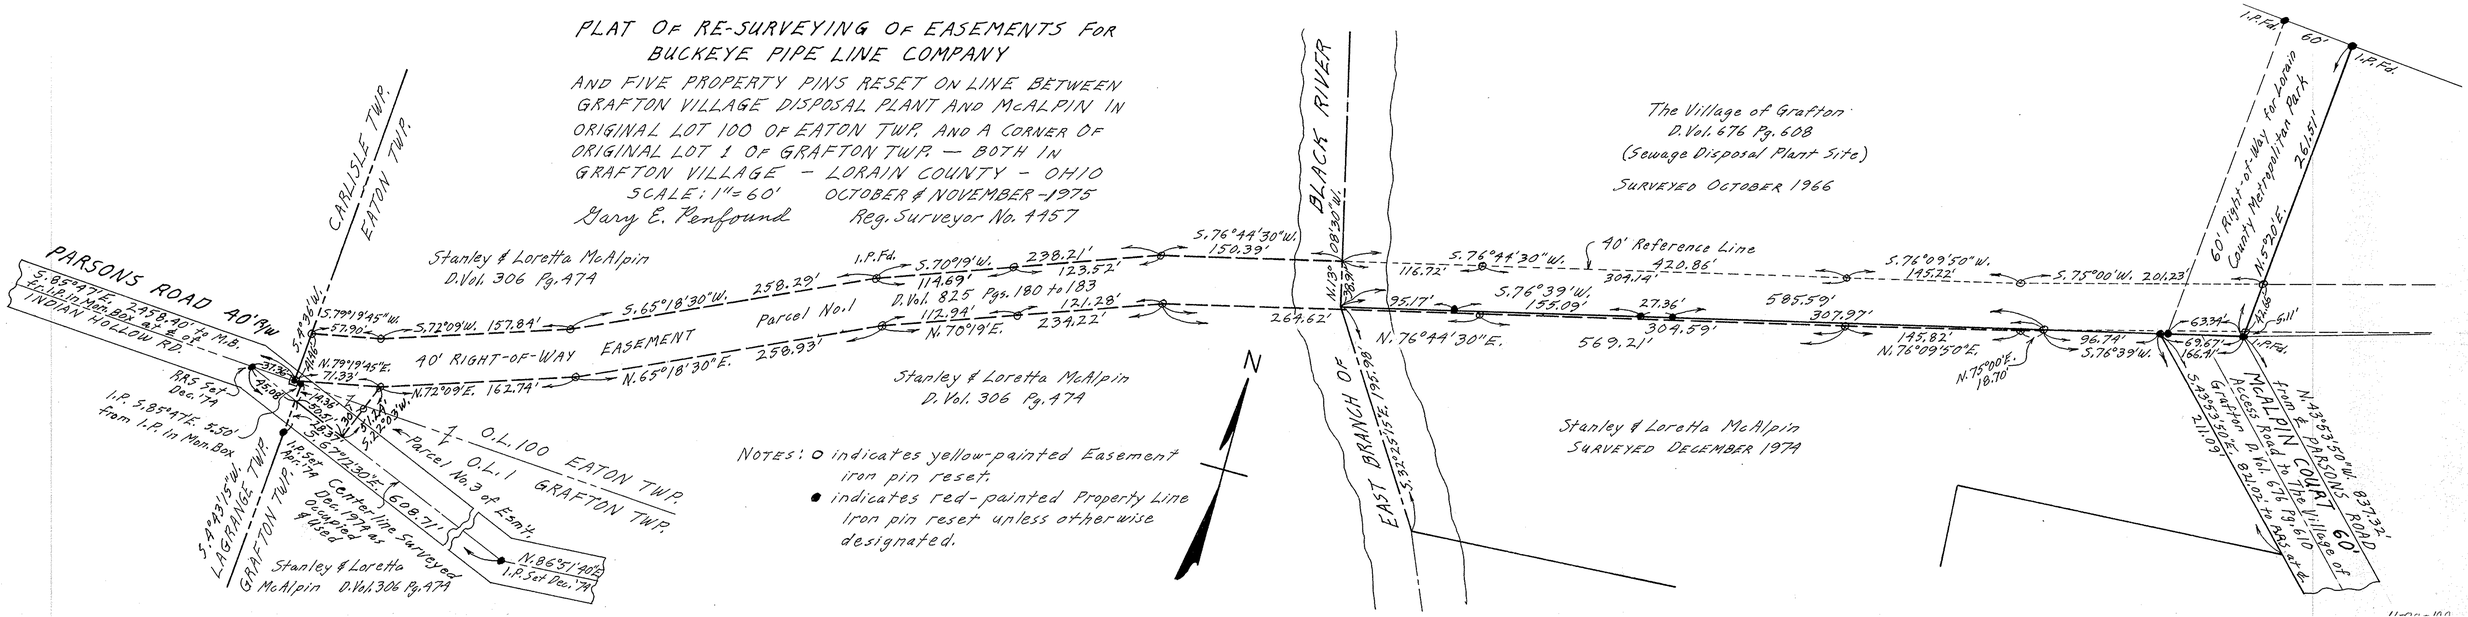

NOTES: ○ indicates yellow-painted Easement iron pin reset.

● indicates red-painted Property Line iron pin reset unless otherwise designated.