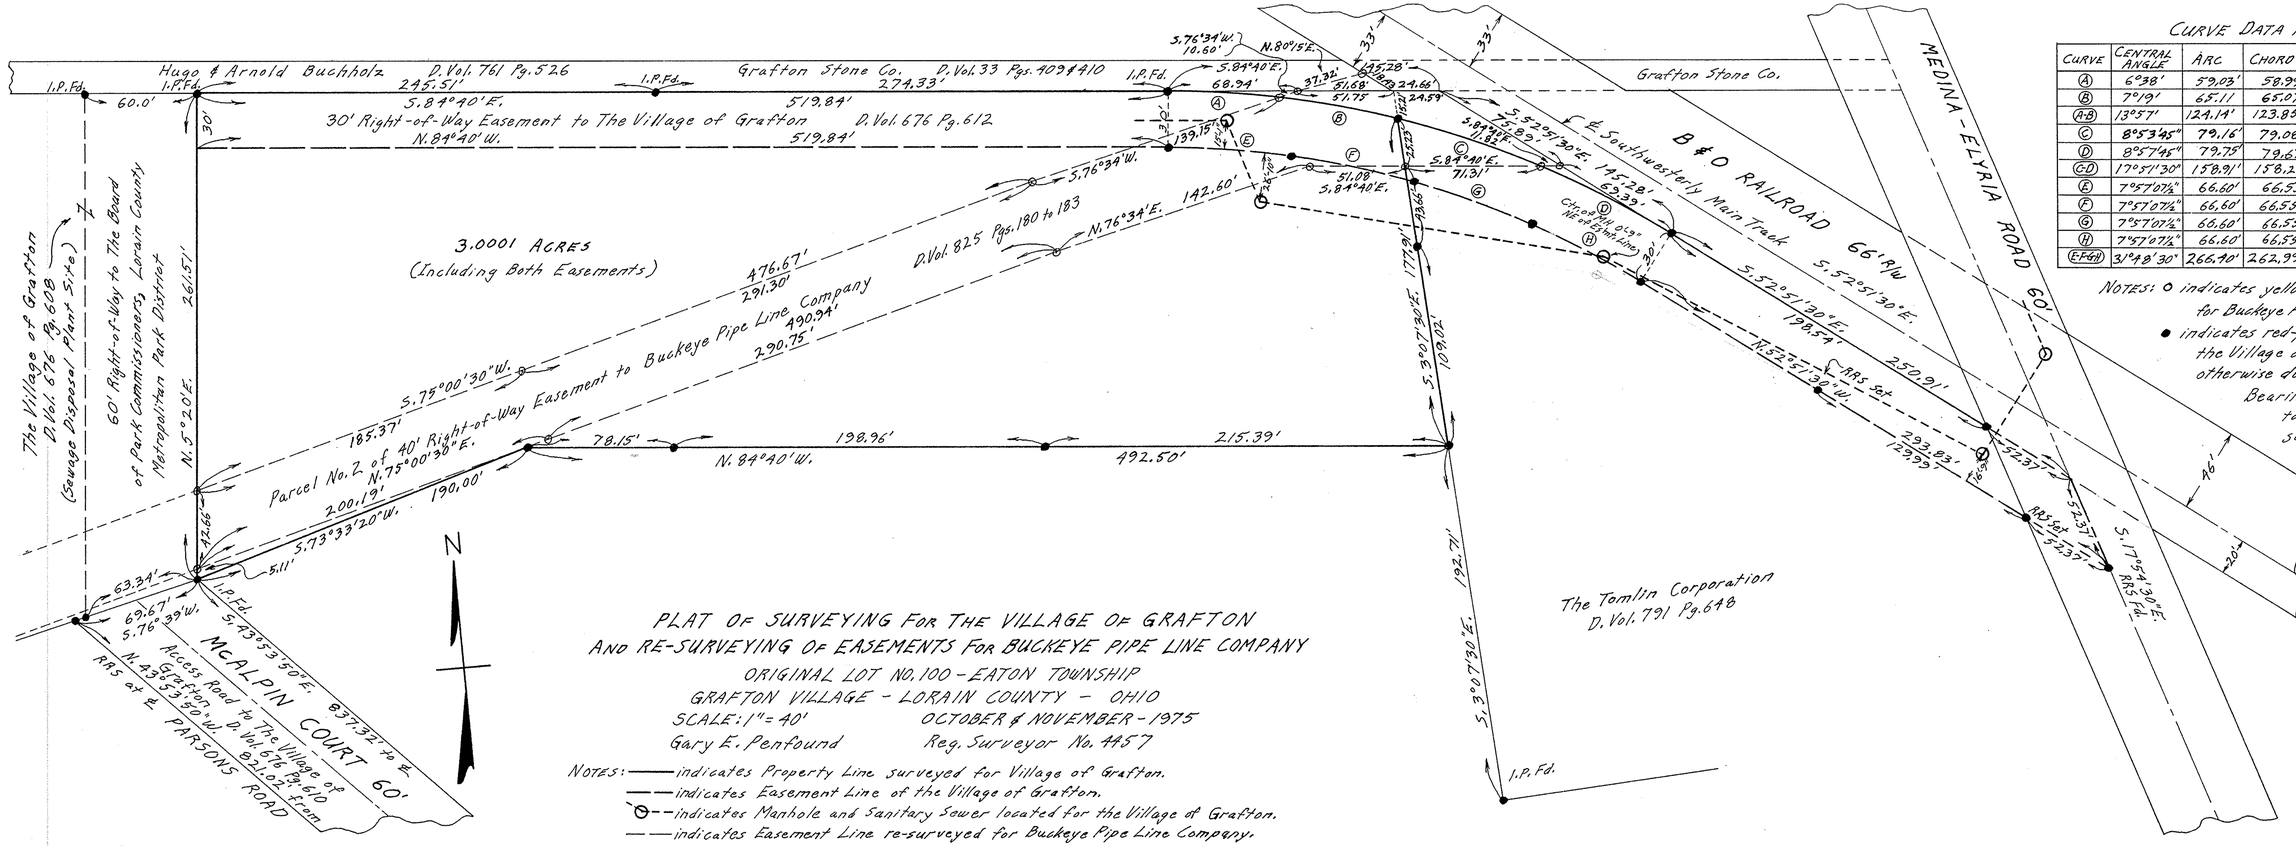

CURVE DATA TABLE

CURVE	CENTRAL ANGLE	ARC	CHORD	CHORD BEARING	RADIUS
A	6°38'	59.03'	58.99'	S.81°21'E.	509.86'
B	7°19'	65.11	65.07	S.74°22'30"E.	509.86'
A-B	13°57'	124.14'	123.85'	S.77°41'30"E.	509.86'
C	8°53'45"	79.16'	79.08'	S.66°16'08"E.	509.86'
D	8°57'45"	79.75'	79.67'	S.57°20'23"E.	509.86'
C-D	17°51'30"	158.91'	158.27'	S.61°47'15"E.	509.86'
E	7°57'07½"	66.60'	66.55'	N.80°41'26"W.	479.86'
F	7°57'07½"	66.60'	66.55'	N.72°44'19"W.	479.86'
G	7°57'07½"	66.60'	66.55'	N.64°47'11"W.	479.86'
H	7°57'07½"	66.60'	66.55'	N.56°50'04"W.	479.86'
E-F-G-H	31°48'30"	266.40'	262.99'	N.68°45'45"W.	479.86'

NOTES: O indicates yellow-painted iron pin reset for Buckeye Pipe Line Company.

● indicates red-painted iron pin set for the Village of Grafton unless otherwise designated.

Bearings for these surveys used to correspond to previous surveys for Mullpin and BPL Co. (Basic measurements found to be about .02' per 100' longer than shown on earlier surveys by GEP.)

PLAT OF SURVEYING FOR THE VILLAGE OF GRAFTON AND RE-SURVEYING OF EASEMENTS FOR BUCKEYE PIPE LINE COMPANY

ORIGINAL LOT NO. 100 - EATON TOWNSHIP

GRAFTON VILLAGE - LORAIN COUNTY - OHIO

SCALE: 1" = 40' OCTOBER & NOVEMBER - 1975

Gary E. Penfound Reg. Surveyor No. 4457

NOTES: ——— indicates Property Line surveyed for Village of Grafton.

— — indicates Easement Line of the Village of Grafton.

-O- - indicates Manhole and Sanitary Sewer located for the Village of Grafton.

— — indicates Easement Line re-surveyed for Buckeye Pipe Line Company.

11-00-100