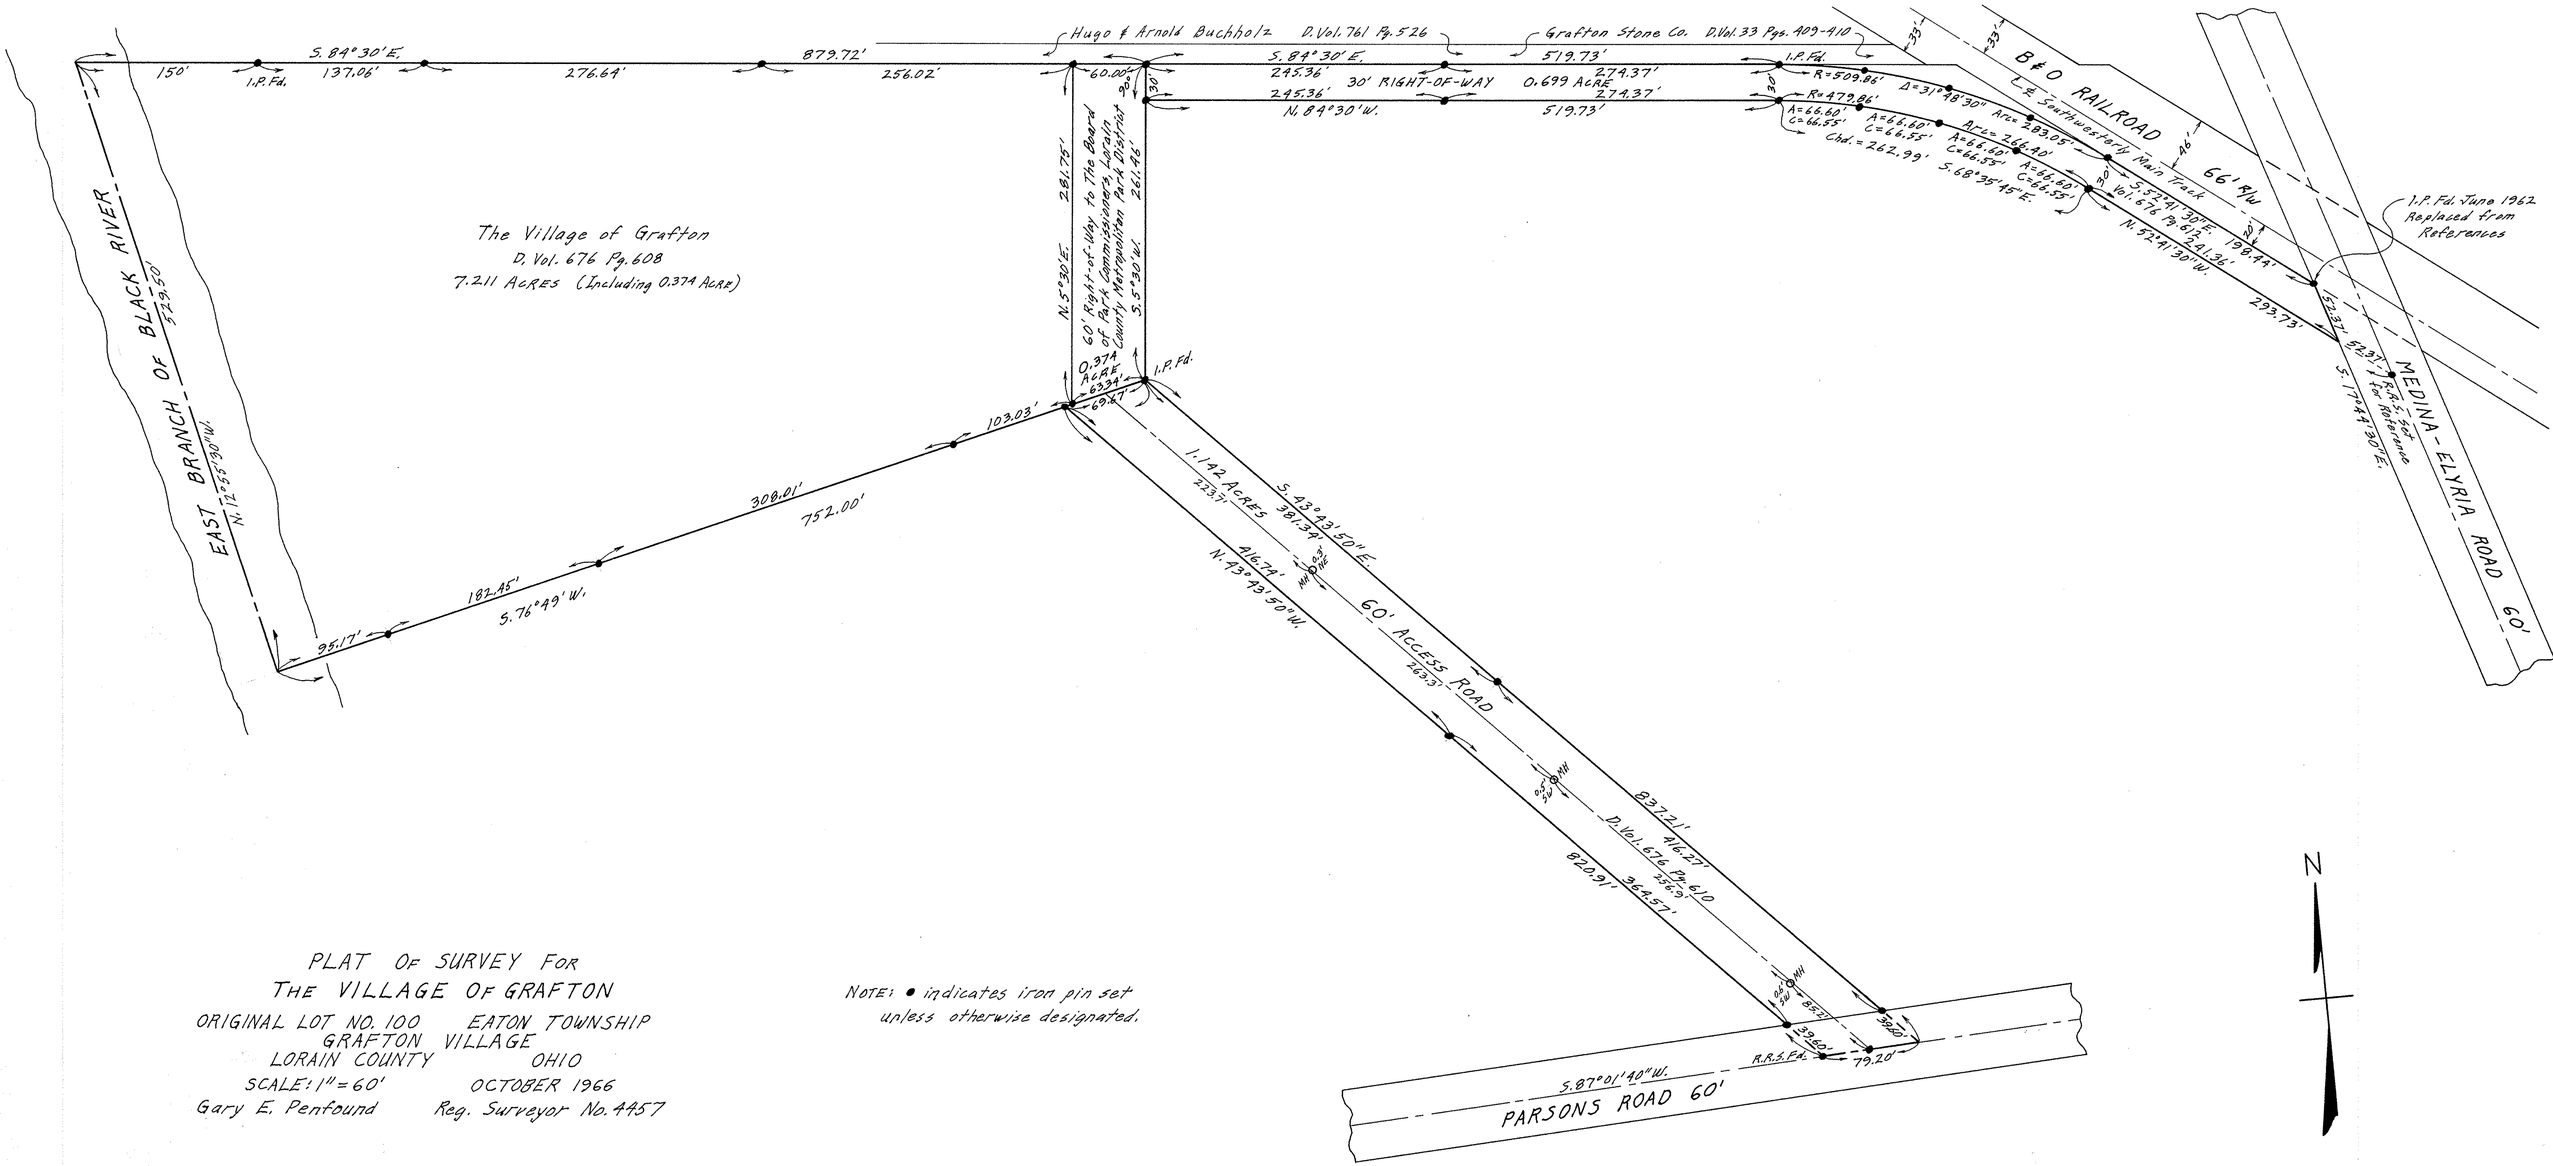

PLAT OF SURVEY FOR
THE VILLAGE OF GRAFTON

ORIGINAL LOT NO. 100 EATON TOWNSHIP
GRAFTON VILLAGE
LORAIN COUNTY OHIO
SCALE: 1" = 60' OCTOBER 1966
Gary E. Penfound Reg. Surveyor No. 4457

NOTE: ● indicates iron pin set unless otherwise designated.