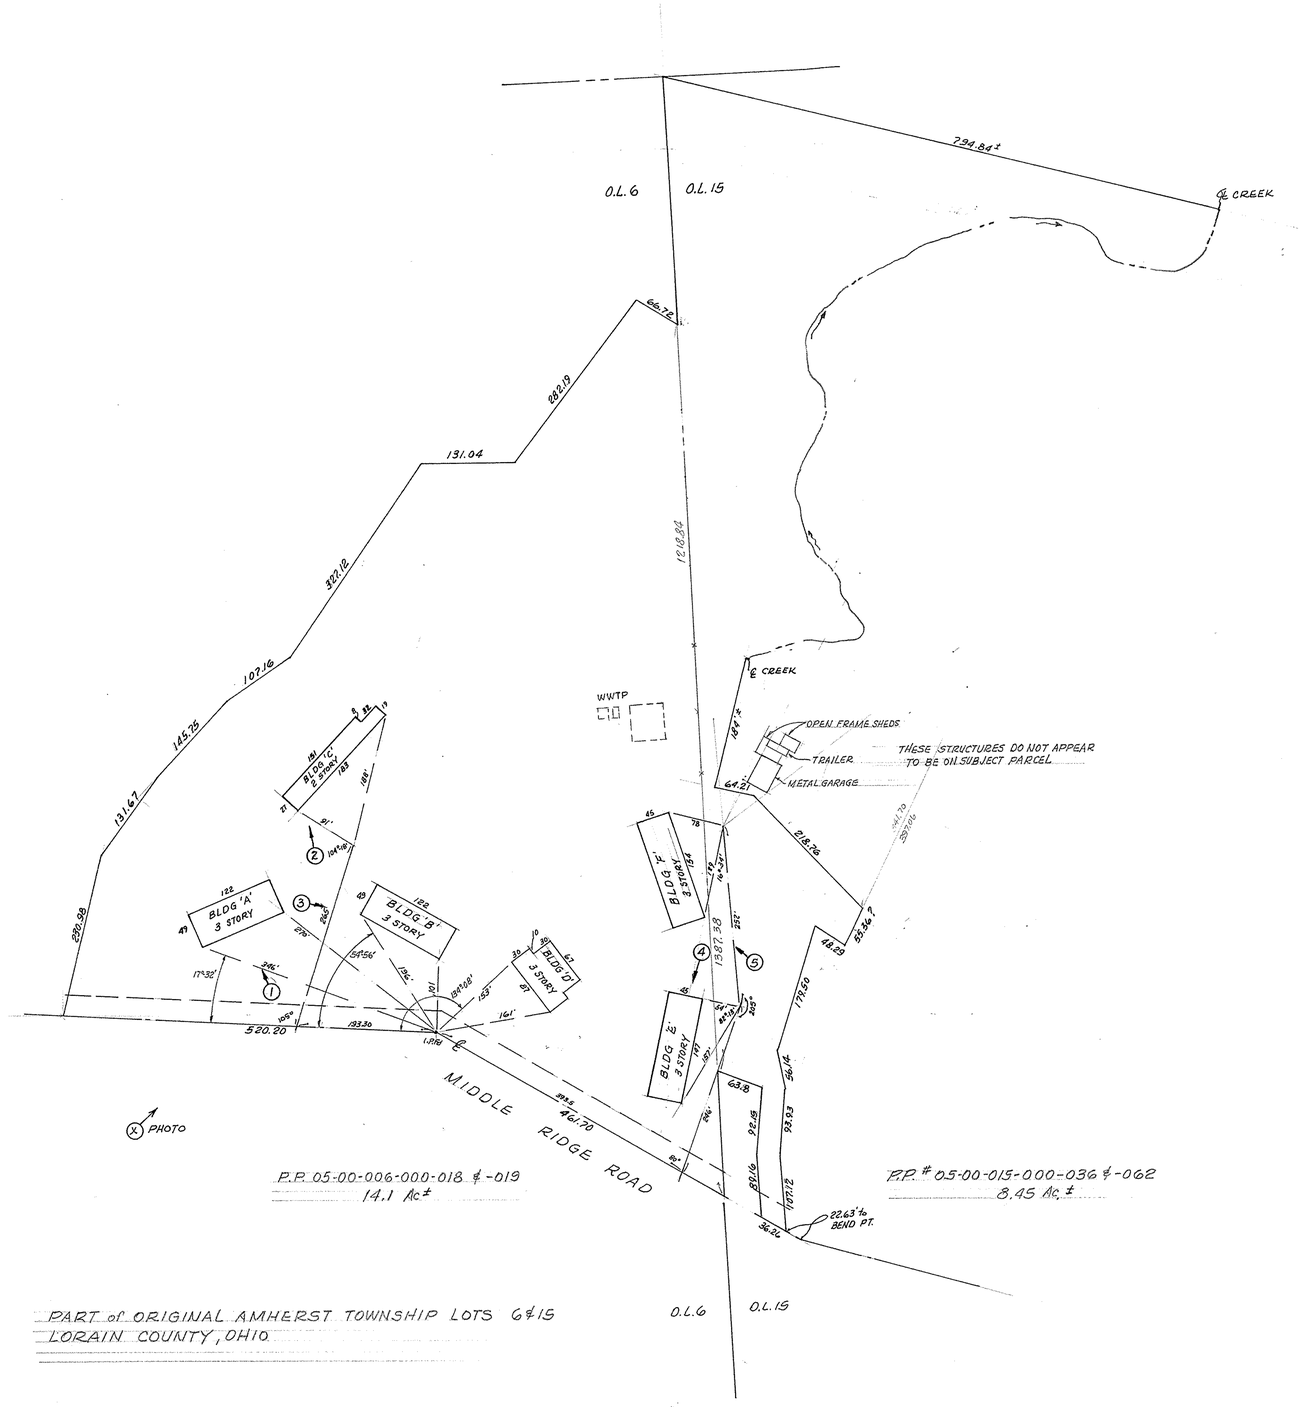

PROPERTY PLAN PREPARED FROM DESCRIPTIONS FURNISHED BY CHICAGO TITLE INSURANCE CO.

NOT A PLAT OF SURVEY
FOR MORTGAGE LOAN PURPOSES ONLY.

PART of ORIGINAL AMHERST TOWNSHIP LOTS 6 & 15
LORAIN COUNTY, OHIO

McGLINCHY AND ASSOCIATES
PROFESSIONAL ENGINEERS AND SURVEYORS
110½ MIDDLE AVENUE ELYRIA, OHIO

SCALE: AS NOTED DRAWN BY: DON
DATE: OCT. 1983 JOB NO: 838083
C.T.I.C. E 185-260