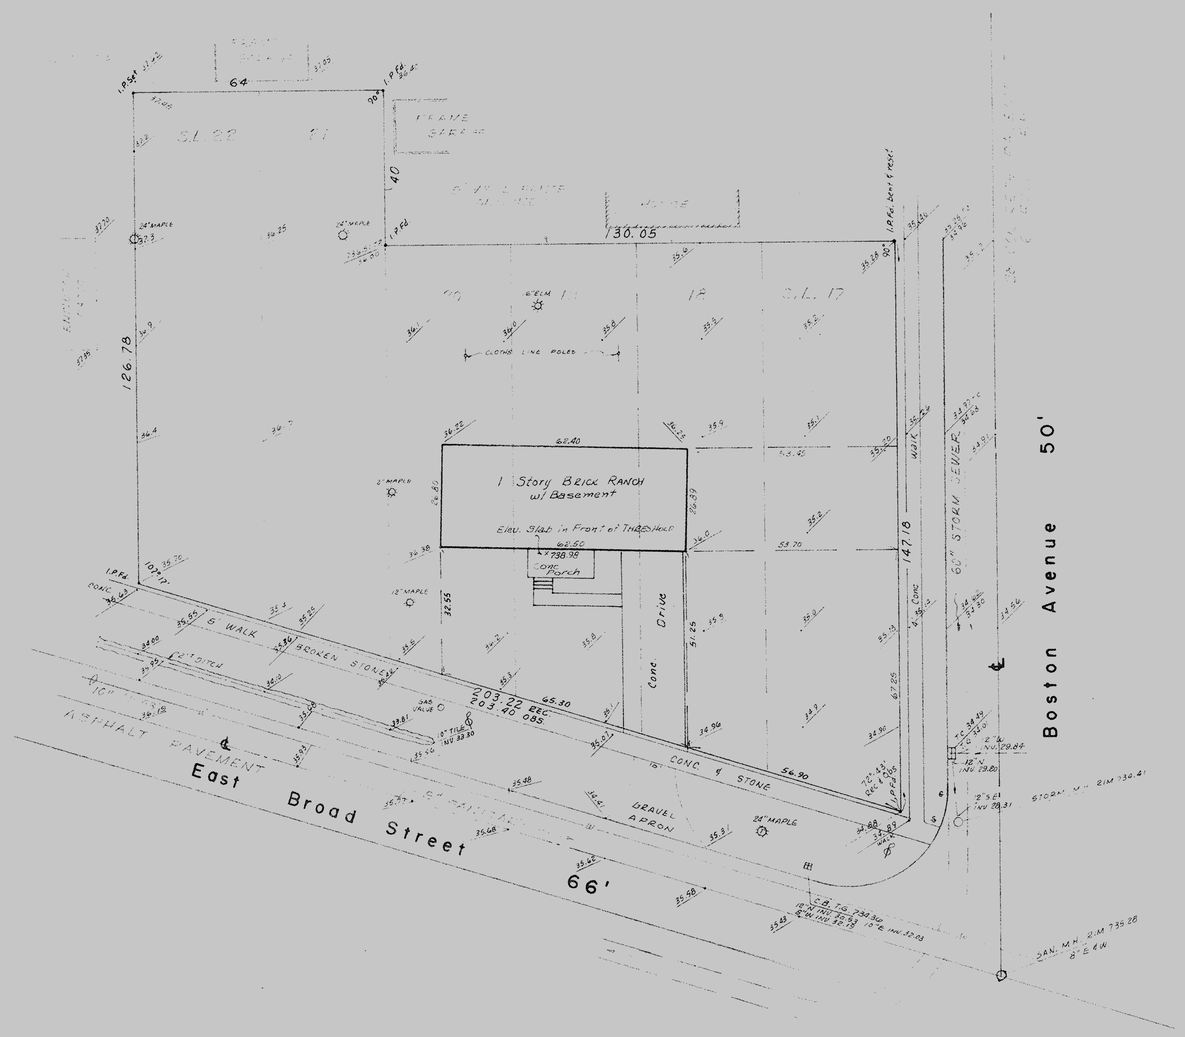
1" = 20'
N
64
40
30.05
126.78
147.18
S.L. 22
S.L. 17
1 Story Brick Ranch
w/ Basement
Elev. Slab in Front of Threshold
Conc. Porch
Drive
Conc.
Boston Avenue 50'
East Broad Street 66'
6' WALK
BROKEN STONE
ASPHALT PAVEMENT
CONC. & STONE
GRAVEL APRON
60" STORM SEWER
24" MAPLE
12" MAPLE
6" ELM
CLOTHES LINE POLES
203.22 BEARS
203.40 OBS
65.30
56.90
BENCH MARK = 737.64
TOP OF ARROW - HYDRANT @
S. LOGAN ST. & BROAD ST.
6" GAS LINE - EAST SIDE BOSTON AVE.
4" GAS LINE - SOUTH SIDE E. BROAD ST.
SANITARY TAP FOR H.N. 833 11/2/55
NOT LOCATED ON CITY RECORDS
SUBLOT NOS. 17-22 of OVERLAND GARDENS ALLOT
PLAT VOLUME 9 PAGE 32
PART of ORIG. ELYRIA TWP LOT 6 - EAST of BLACK RIVER
NOW in CITY of ELYRIA, OHIO
P.P. # 02-25-036-111-001 thru -005
PLAN of BOUNDARY & TOPOGRAPHIC SURVEY
833 EAST BROAD STREET ELYRIA, OHIO
BY
McGLINCHY & ASSOCIATES, INC.
REG. STERED SURVEYORS & ENGINEERS
AUGUST 1984 848473
ORIGINAL TRACING TO
LANDIG 8/15/84