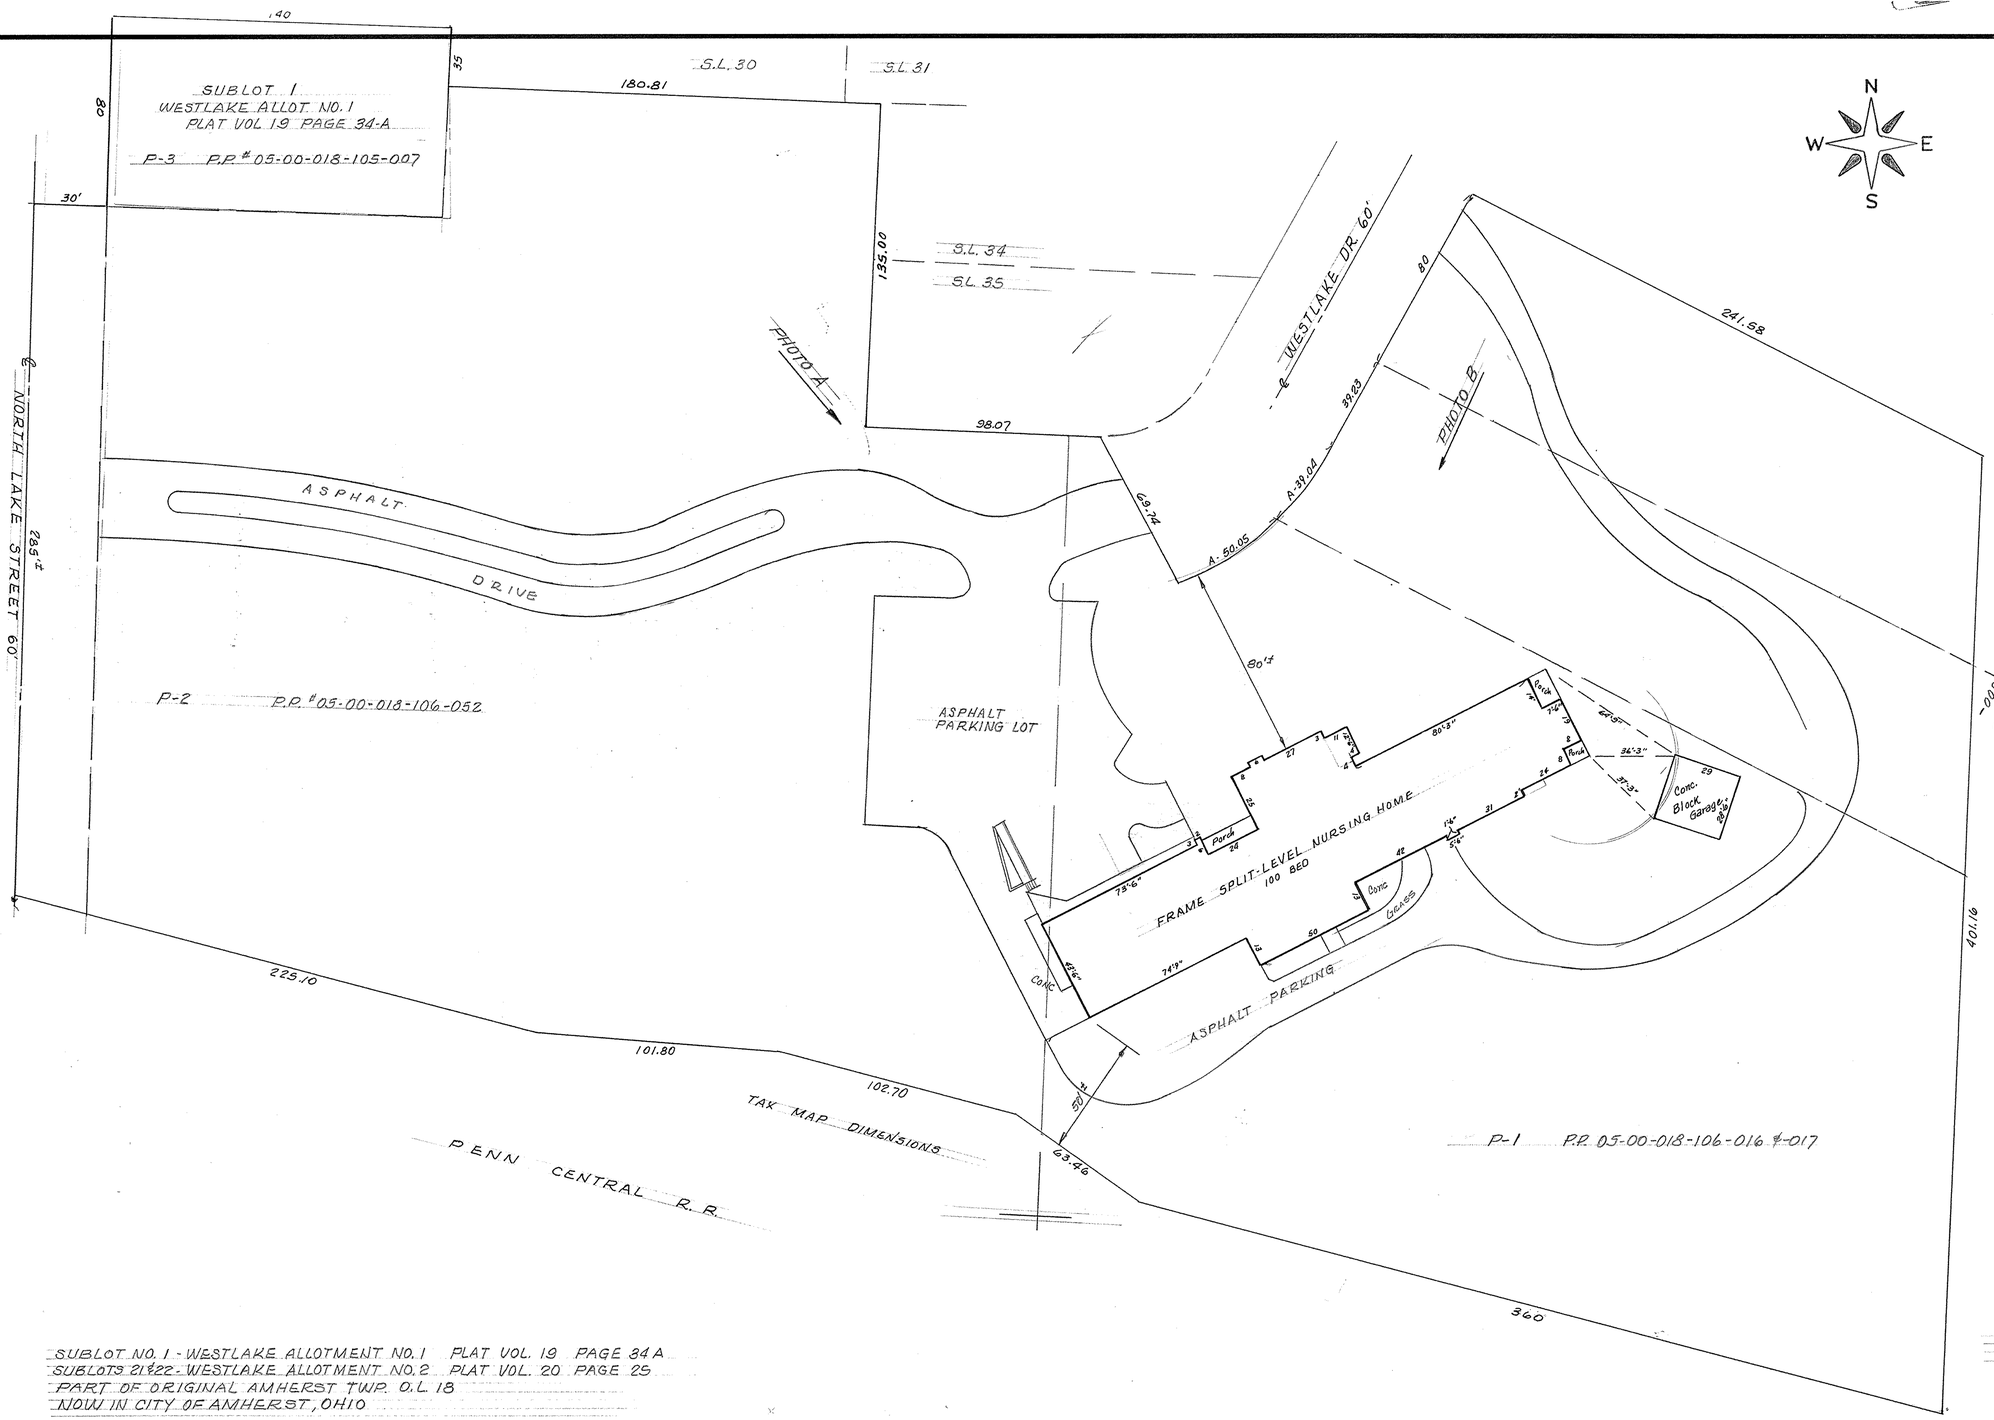

SUBLOT NO. 1 - WESTLAKE ALLOTMENT NO. 1 PLAT VOL. 19 PAGE 34 A
SUBLOTS 21 & 22 - WESTLAKE ALLOTMENT NO. 2 PLAT VOL. 20 PAGE 25
PART OF ORIGINAL AMHERST TWP. O.L. 18
NOW IN CITY OF AMHERST, OHIO

THIS IS NOT A PLAT OF SURVEY

SEE DEED VOL 942 PG 803 FOR DRIVE EASEMENT REF: S.L. 21 & S.L. 20 ADJACENT NO DIMENSIONS (REF. PARCEL 4)

McGLINCHY AND ASSOCIATES
PROFESSIONAL ENGINEERS AND SURVEYORS
110½ MIDDLE AVENUE ELYRIA, OHIO

SCALE: 1" = 30' DRAWN BY: D
DATE: JUNE 84 JOB NO: 848397 PART I
COOK & BATISTA