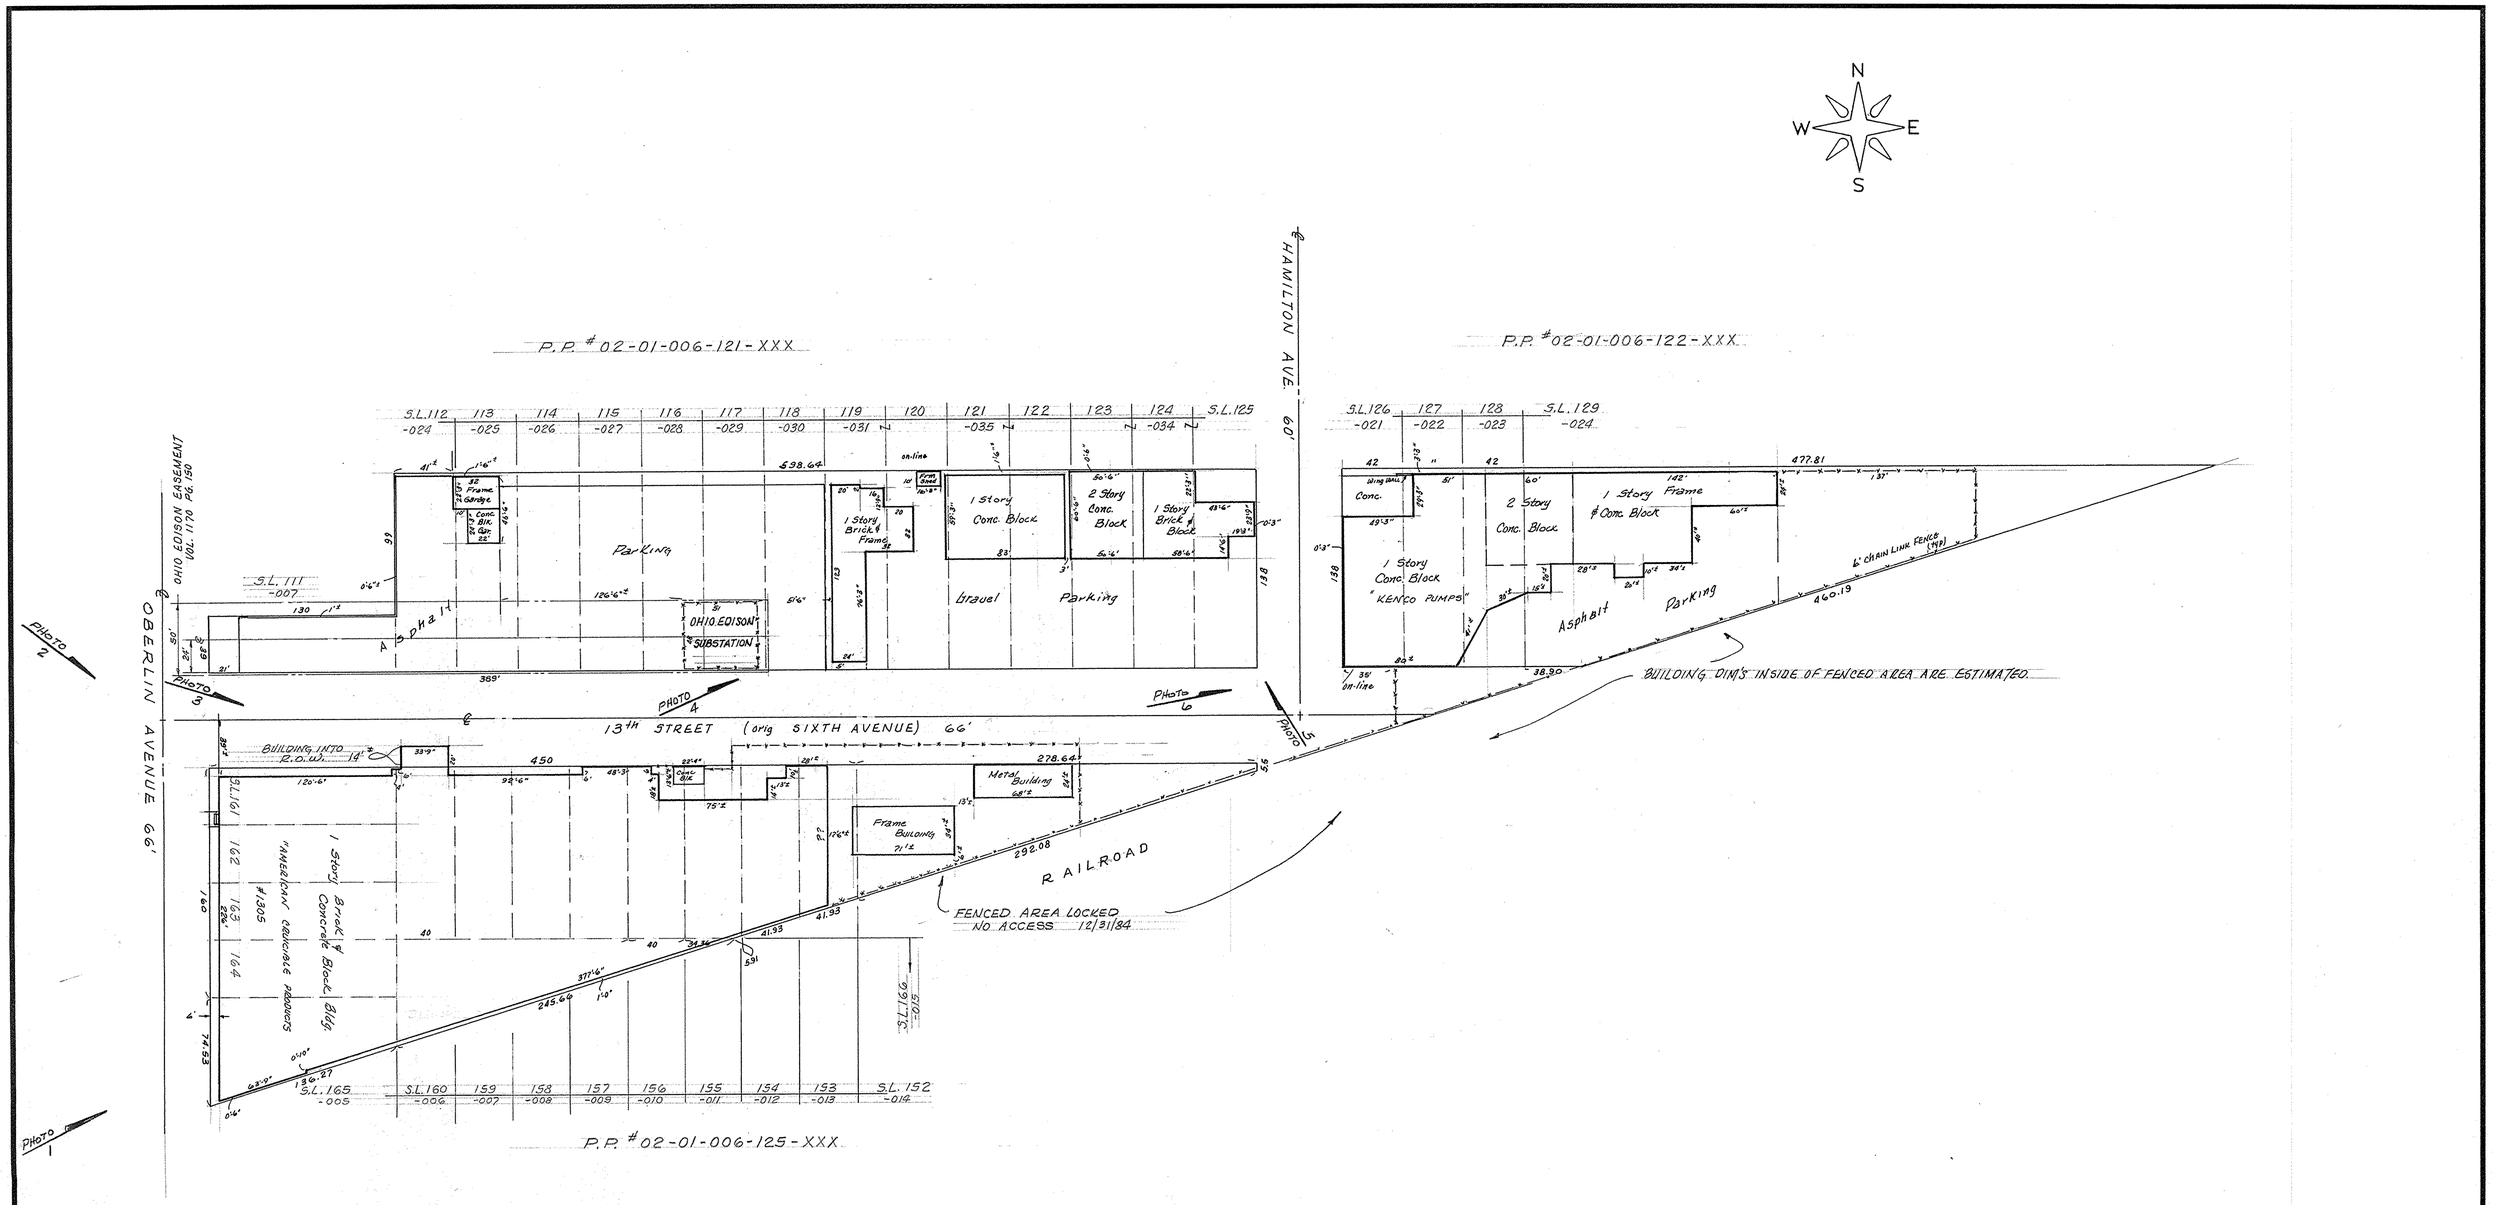

SUBLOT NOS. 111 thru 129 & 152 thru 166 INCLUSIVE of
E.R. PERKINS TRUSTEE ADDITION
PLAT VOLUME 7 PAGE 41
PART OF ORIGINAL BLACK RIVER TOWNSHIP LOT 6-TRACT 1
NOW IN CITY OF LORAIN, OHIO

THIS IS NOT A PLAT OF SURVEY:
FOR MORTGAGE LOAN PURPOSES ONLY

McGLINCHY AND ASSOCIATES
PROFESSIONAL ENGINEERS AND SURVEYORS
110½ MIDDLE AVENUE ELYRIA, OHIO

SCALE: 1" = 50' DRAWN BY: DON
DATE: 1-2-85 JOB NO: 848610