MAP of TOPOGRAPHICAL SURVEY

PREPARED FOR WYCOFF-LANDIG & ASSOC. INC.

PARTS of ORIGINAL ELYRIA TOWNSHIP LOT Nos. 24 & 25

BETWEEN THE BRANCHES OF BLACK RIVER

CITY of ELYRIA LORAIN COUNTY OHIO

NOTE: LOCATION OF RIVER AS SHOWN, DERIVED FROM TAX MAP AERIAL RECORDS – NOT FROM ACTUAL FIELD SURVEY.

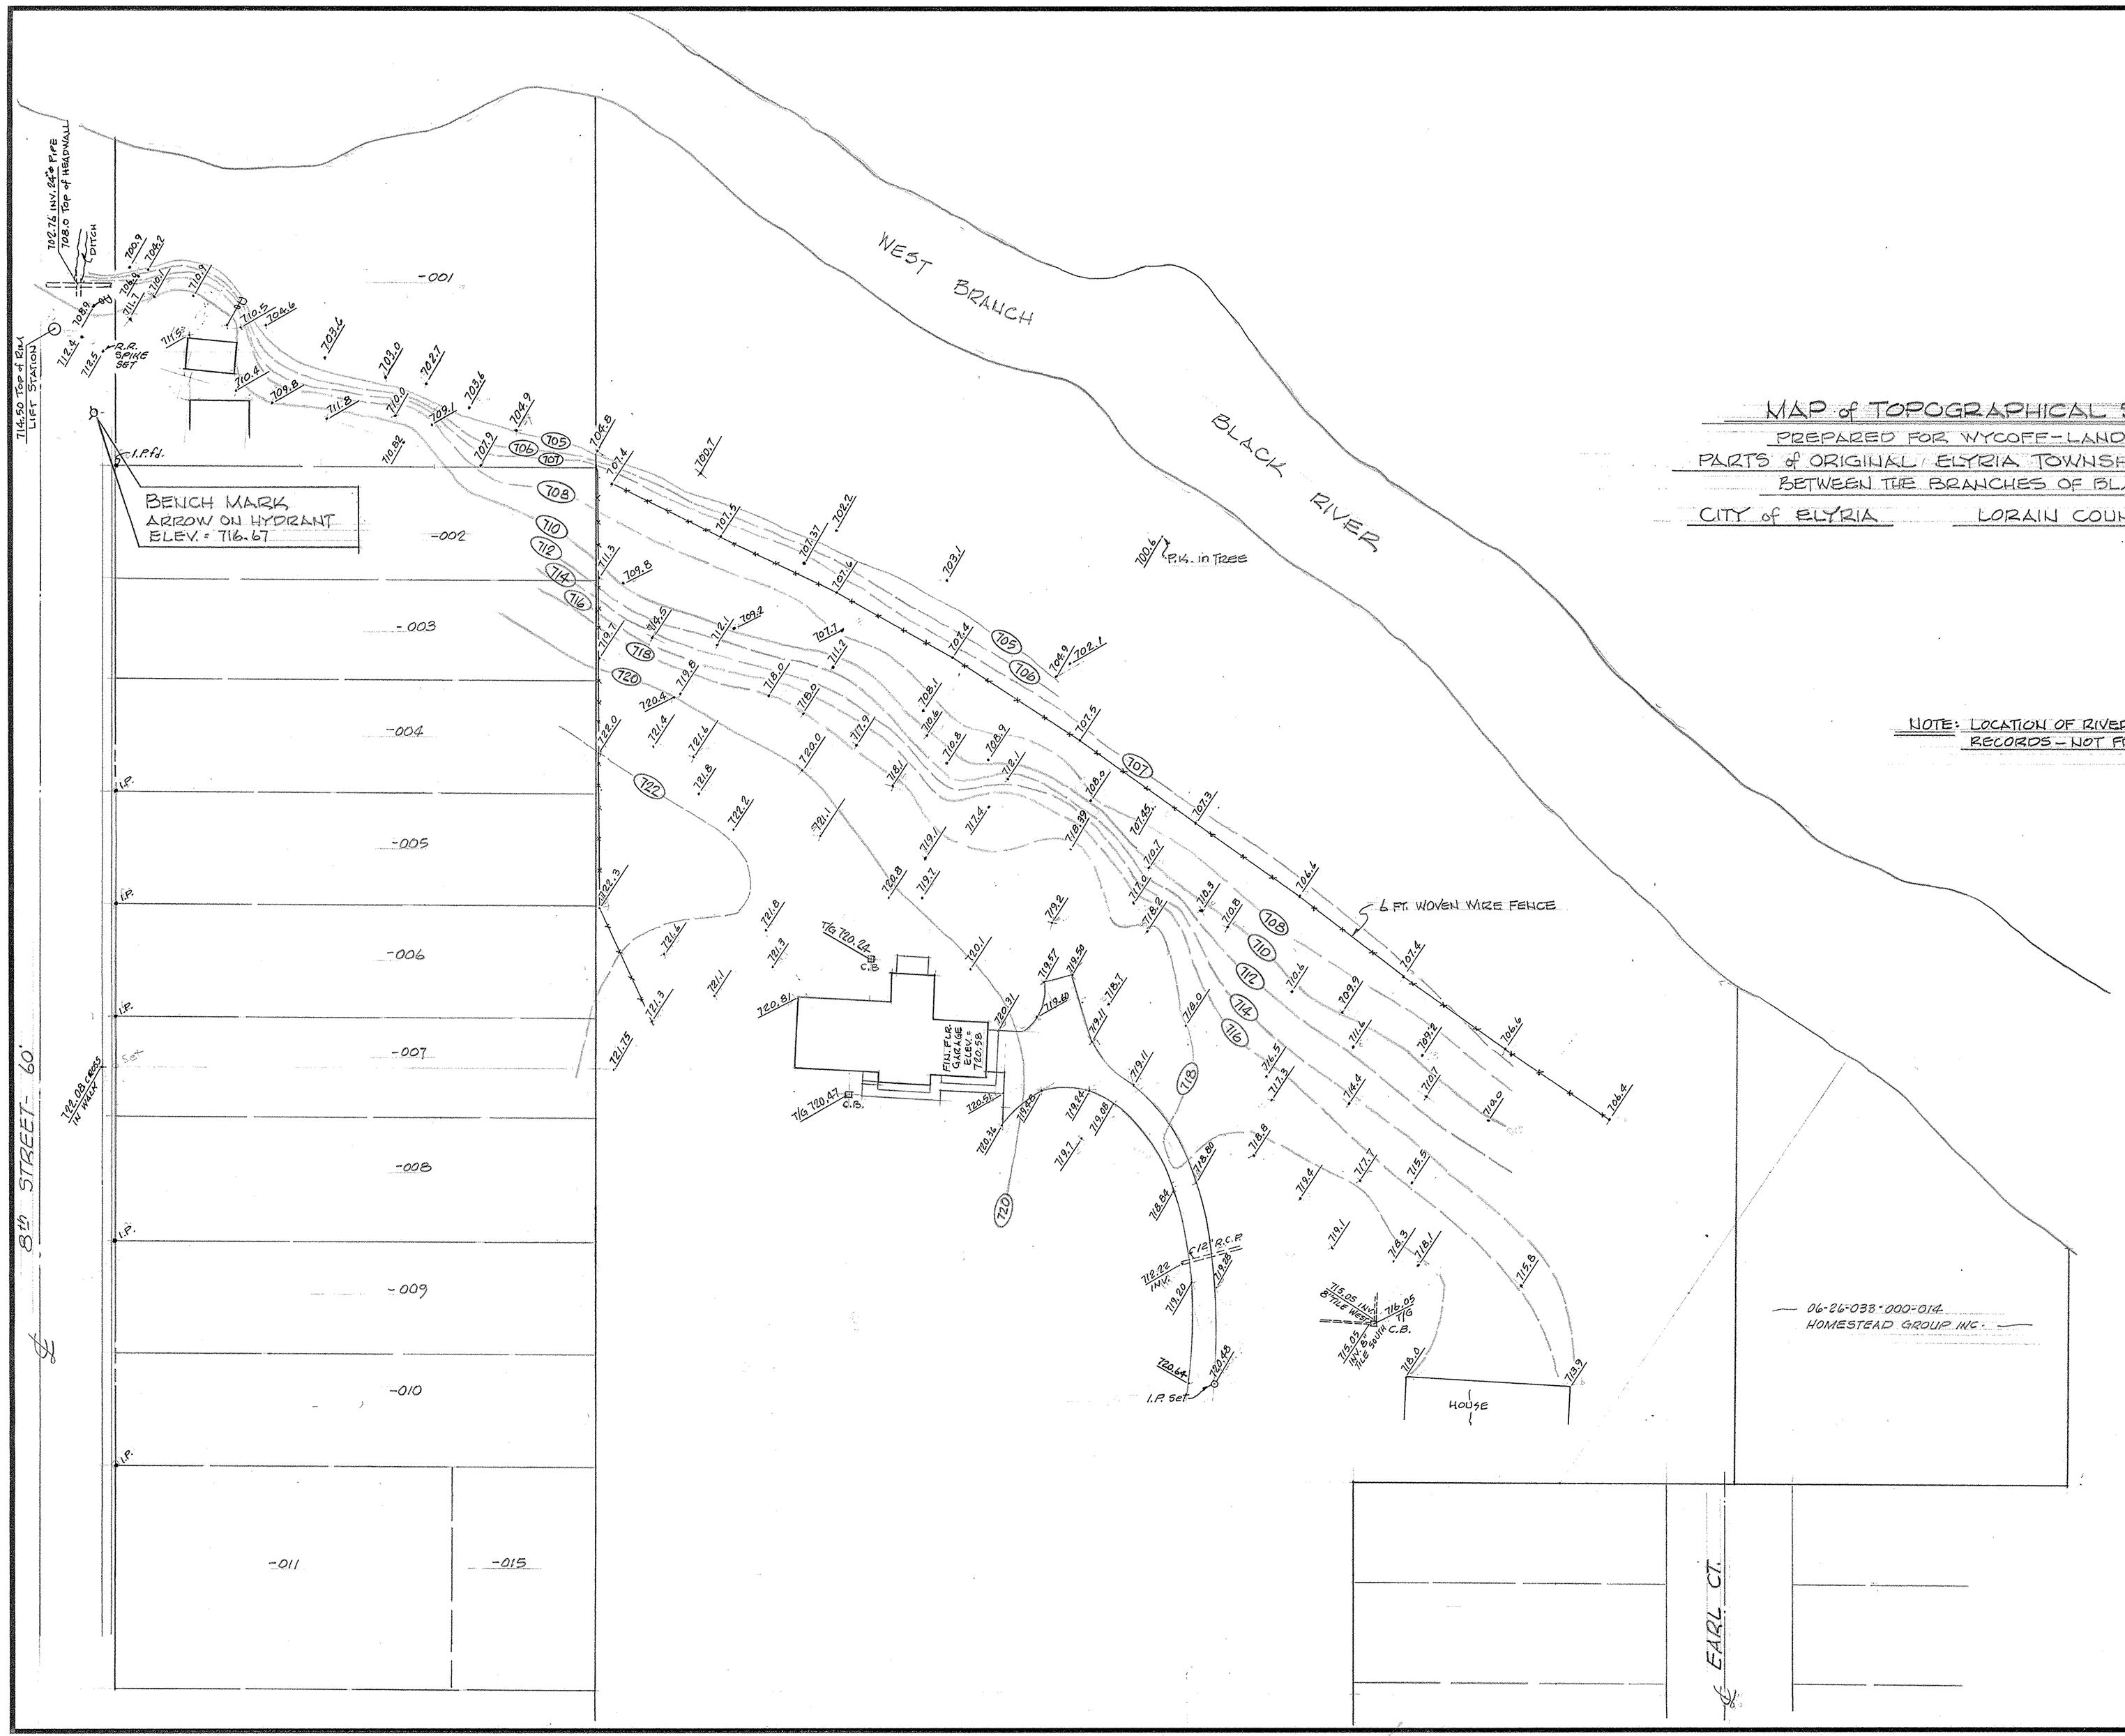

McGLINCHY AND ASSOCIATES
PROFESSIONAL ENGINEERS AND SURVEYORS
ELYRIA, OHIO

SCALE: 1" = 30' DRAWN BY: B. THOMAS

DATE: OCT. 1980 JOB NO: 806385