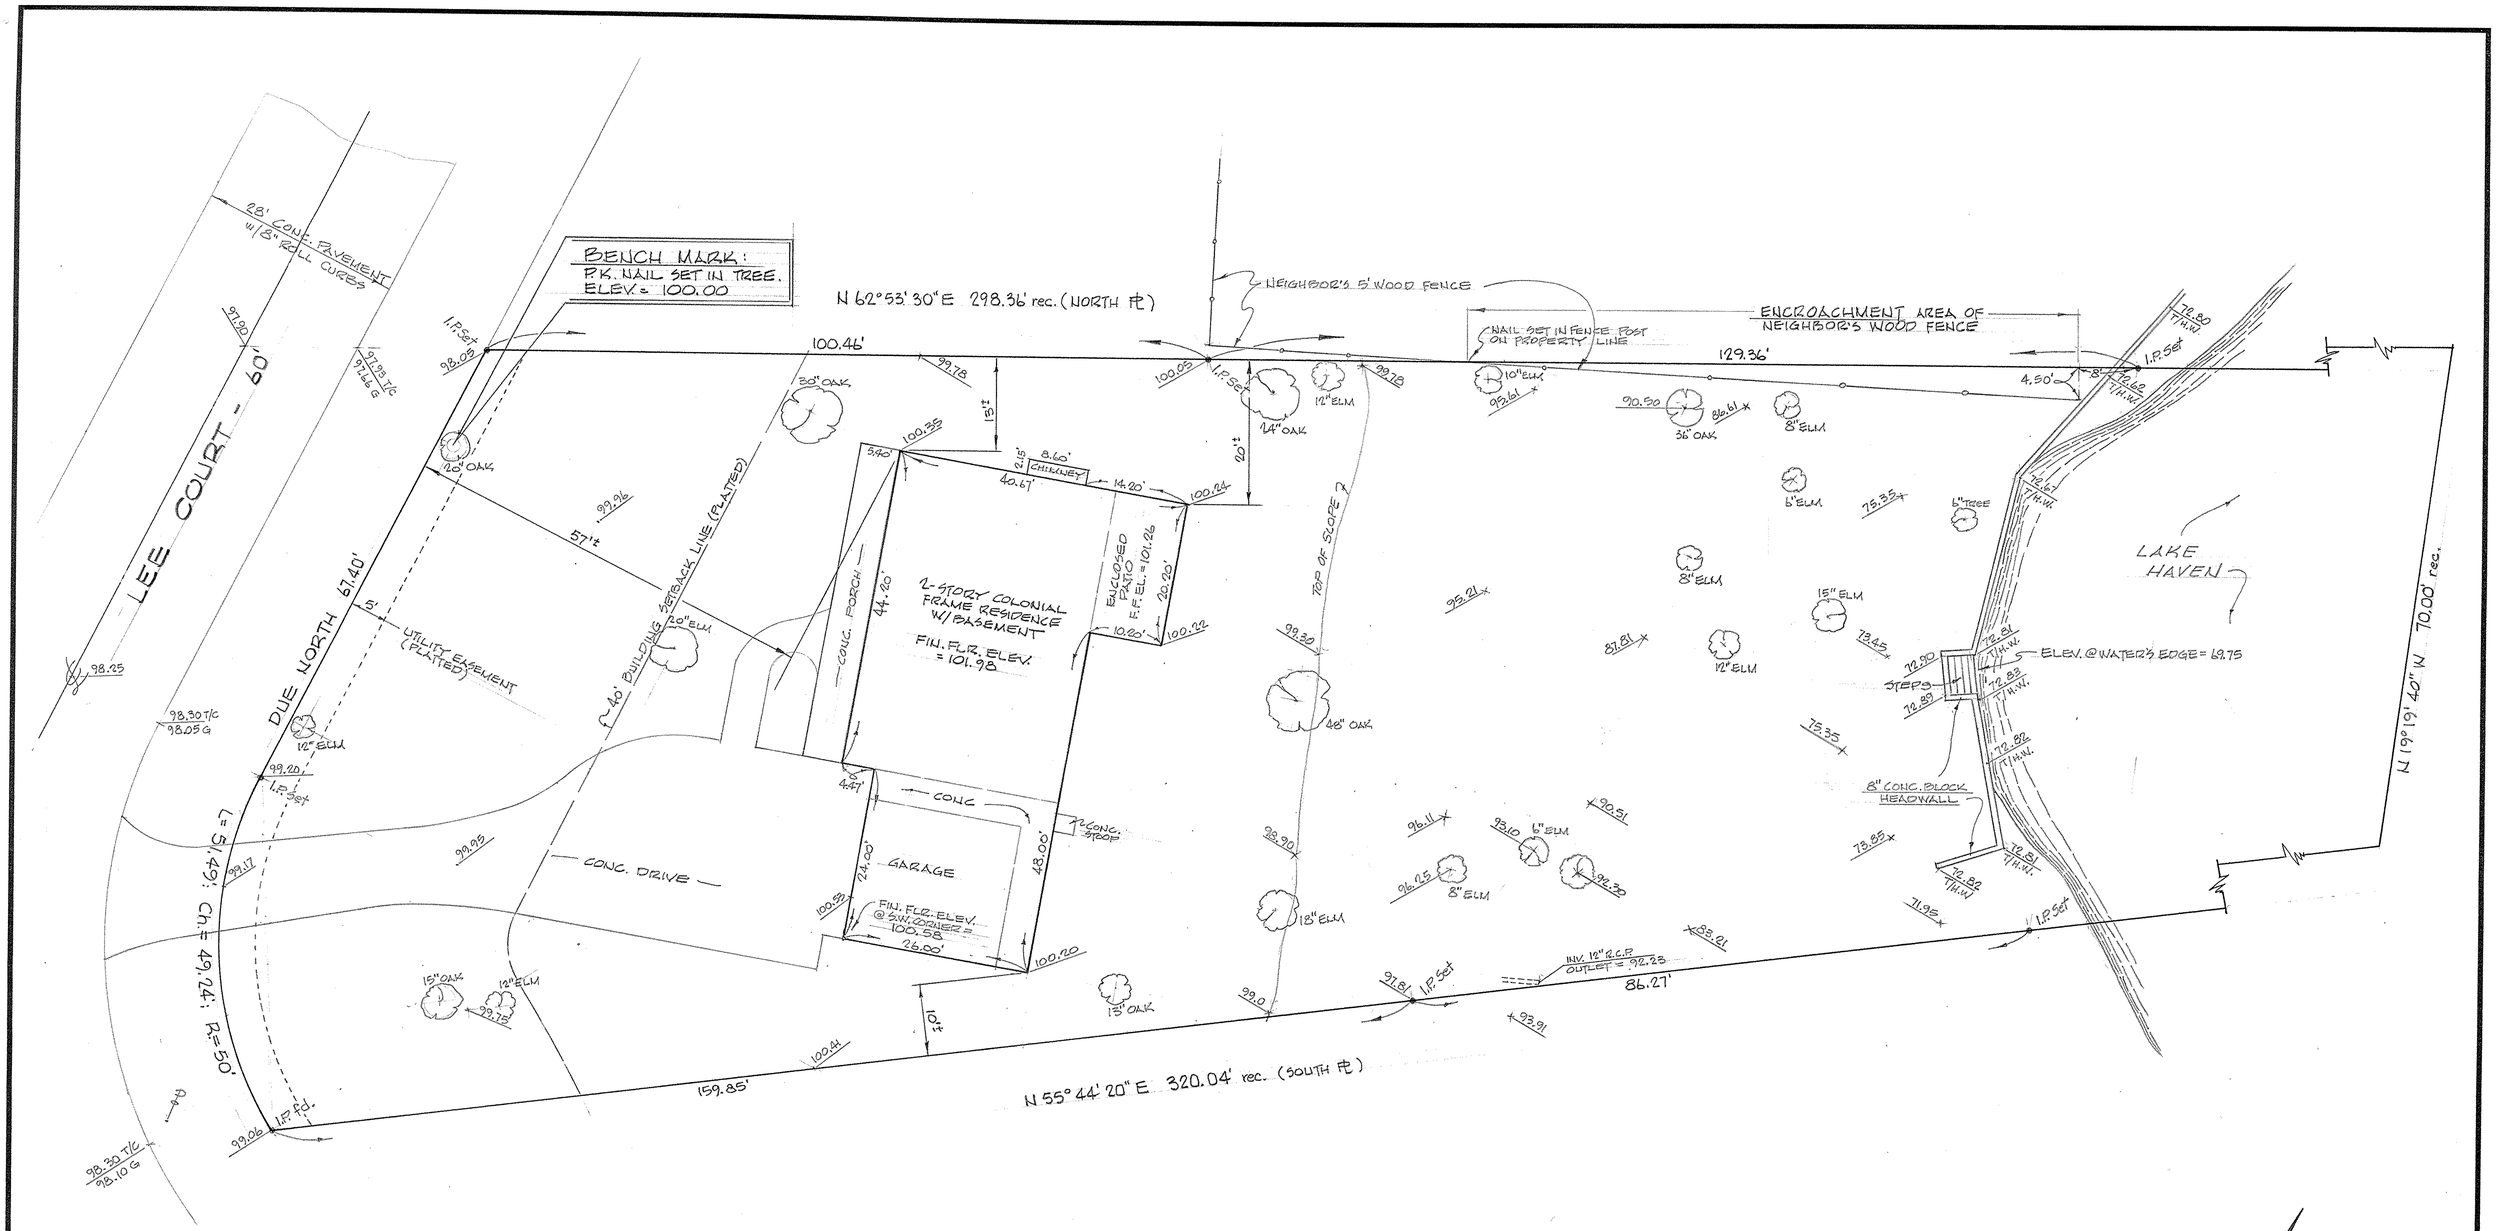

MAP of BOUNDARY and TOPOGRAPHIC SURVEY

PREPARED FOR: DR. DONALD BLANFORD AT THE INSTANCE OF RONALD LANDIG - ARCHITECT

SUBLOT 30 of LAKE HAVEN ESTATES No. 1, PLAT VOL. 24, PAGE 49
PART of BROWNHELM TOWNSHIP ORIGINAL LOT No. 5
CITY of VERMILION, LORAIN COUNTY, OHIO

McGLINCHY AND ASSOCIATES
PROFESSIONAL ENGINEERS AND SURVEYORS
ELYRIA, OHIO

SCALE: 1" = 10' DRAWN BY: B. THOMAS
DATE: JUNE 1980 JOB NO: 806323