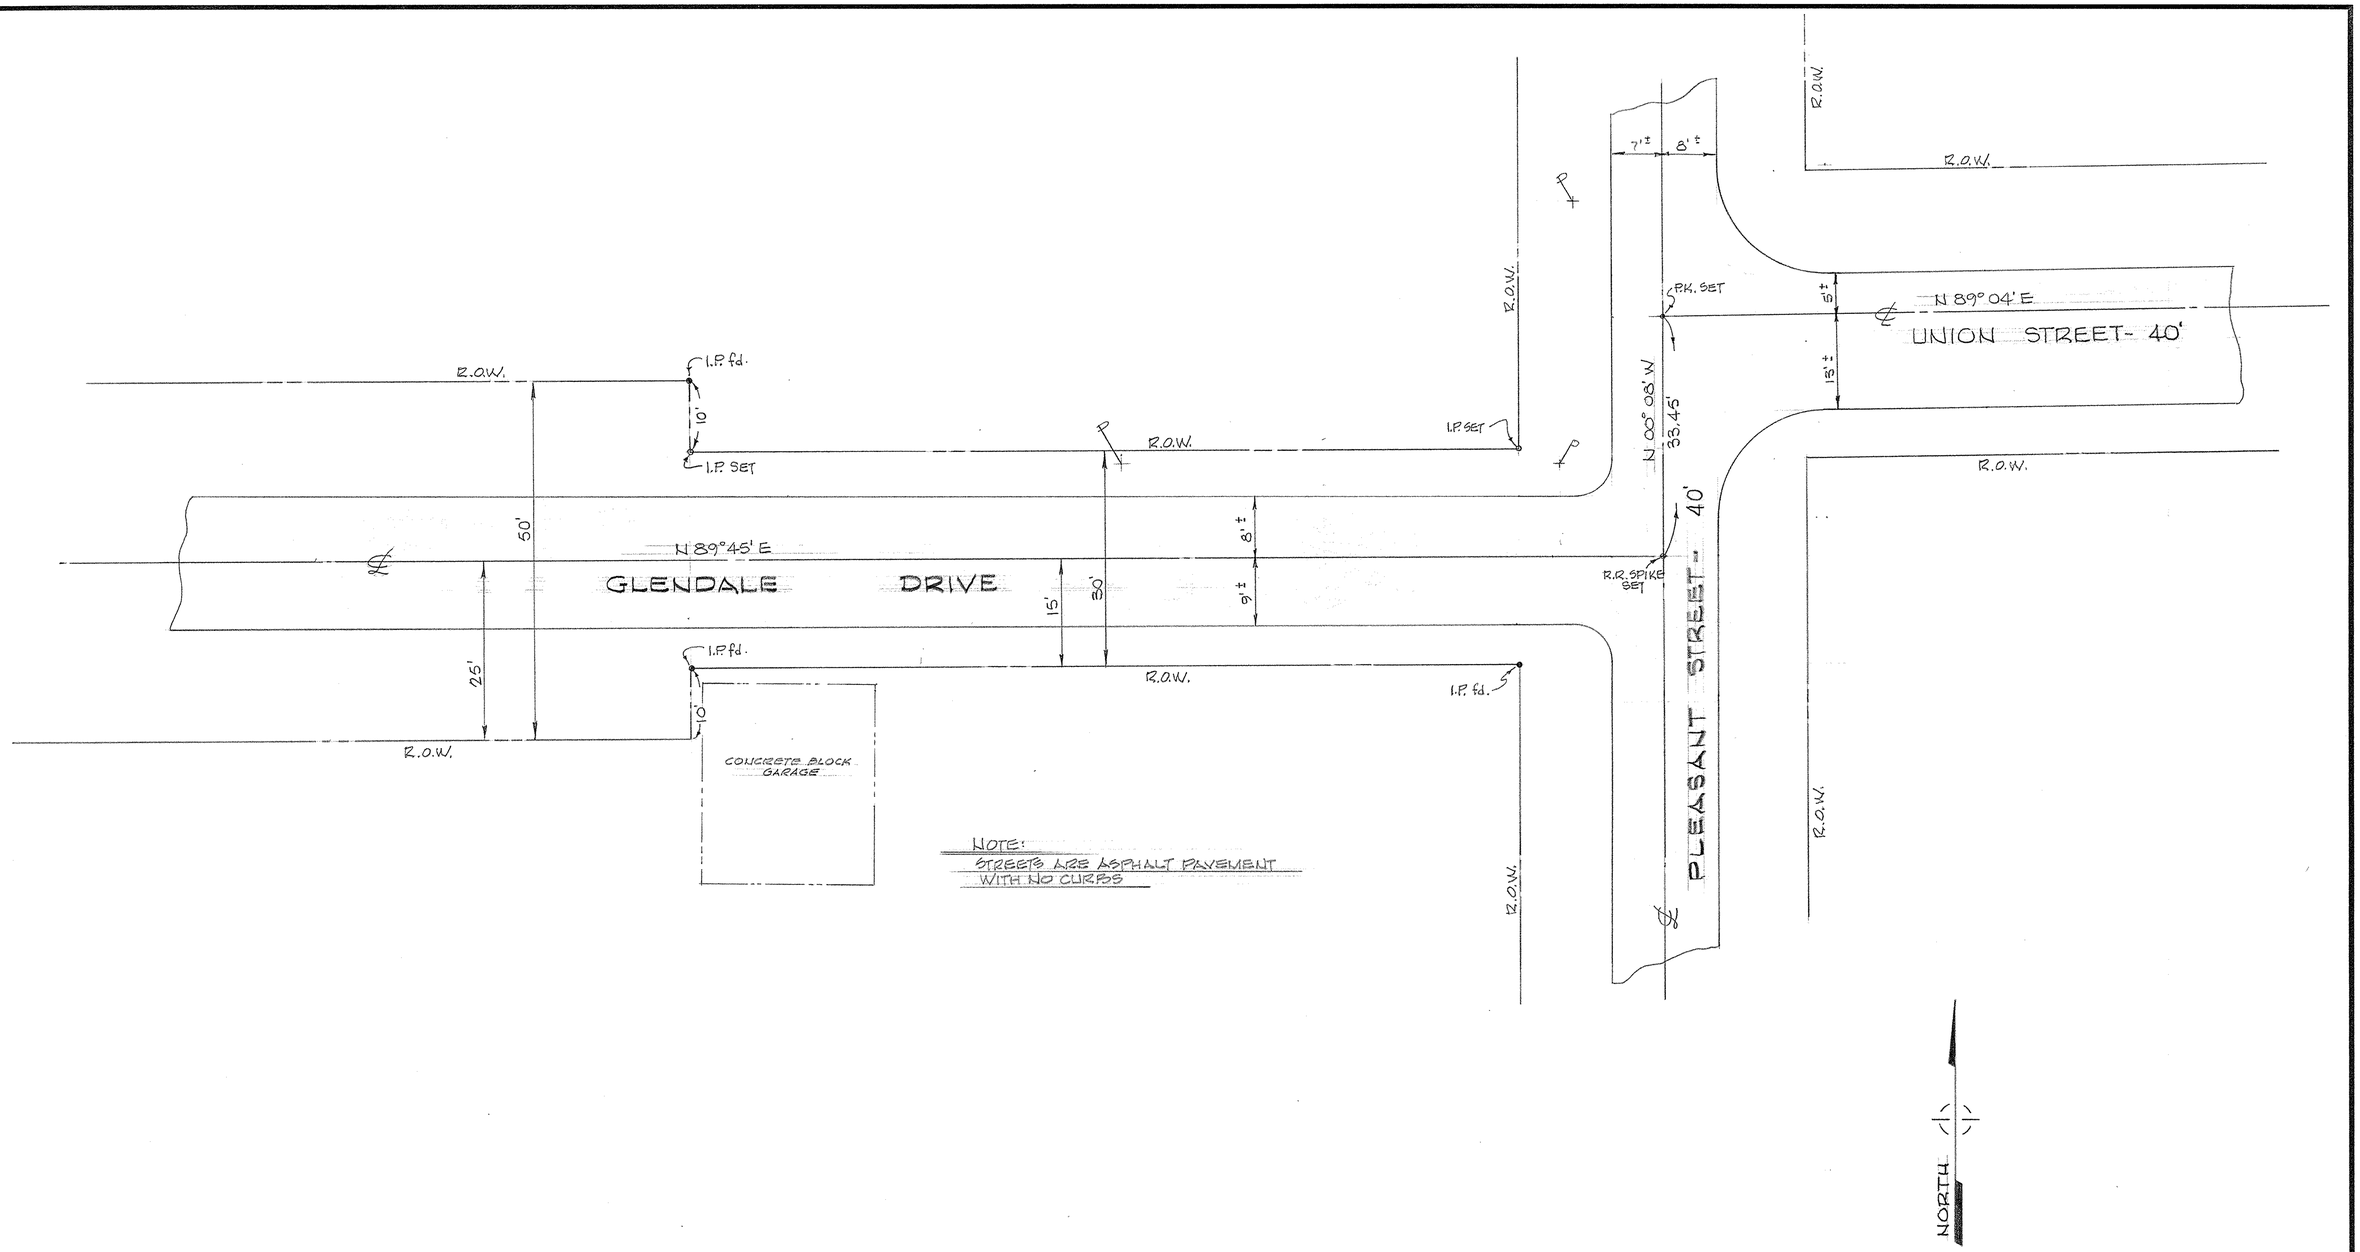

MAP of SURVEY

GLENDALE DRIVE and PLEASANT STREET INTERSECTION

PART of ORIGINAL LAGRANGE TOWNSHIP LOT No. 56

VILLAGE of LAGRANGE, LORAIN COUNTY, OHIO

McGLINCHY AND ASSOCIATES
PROFESSIONAL ENGINEERS AND SURVEYORS
ELYRIA, OHIO

SCALE: 1" = 10' DRAWN BY:

DATE: APRIL 1980 JOB NO: 806281