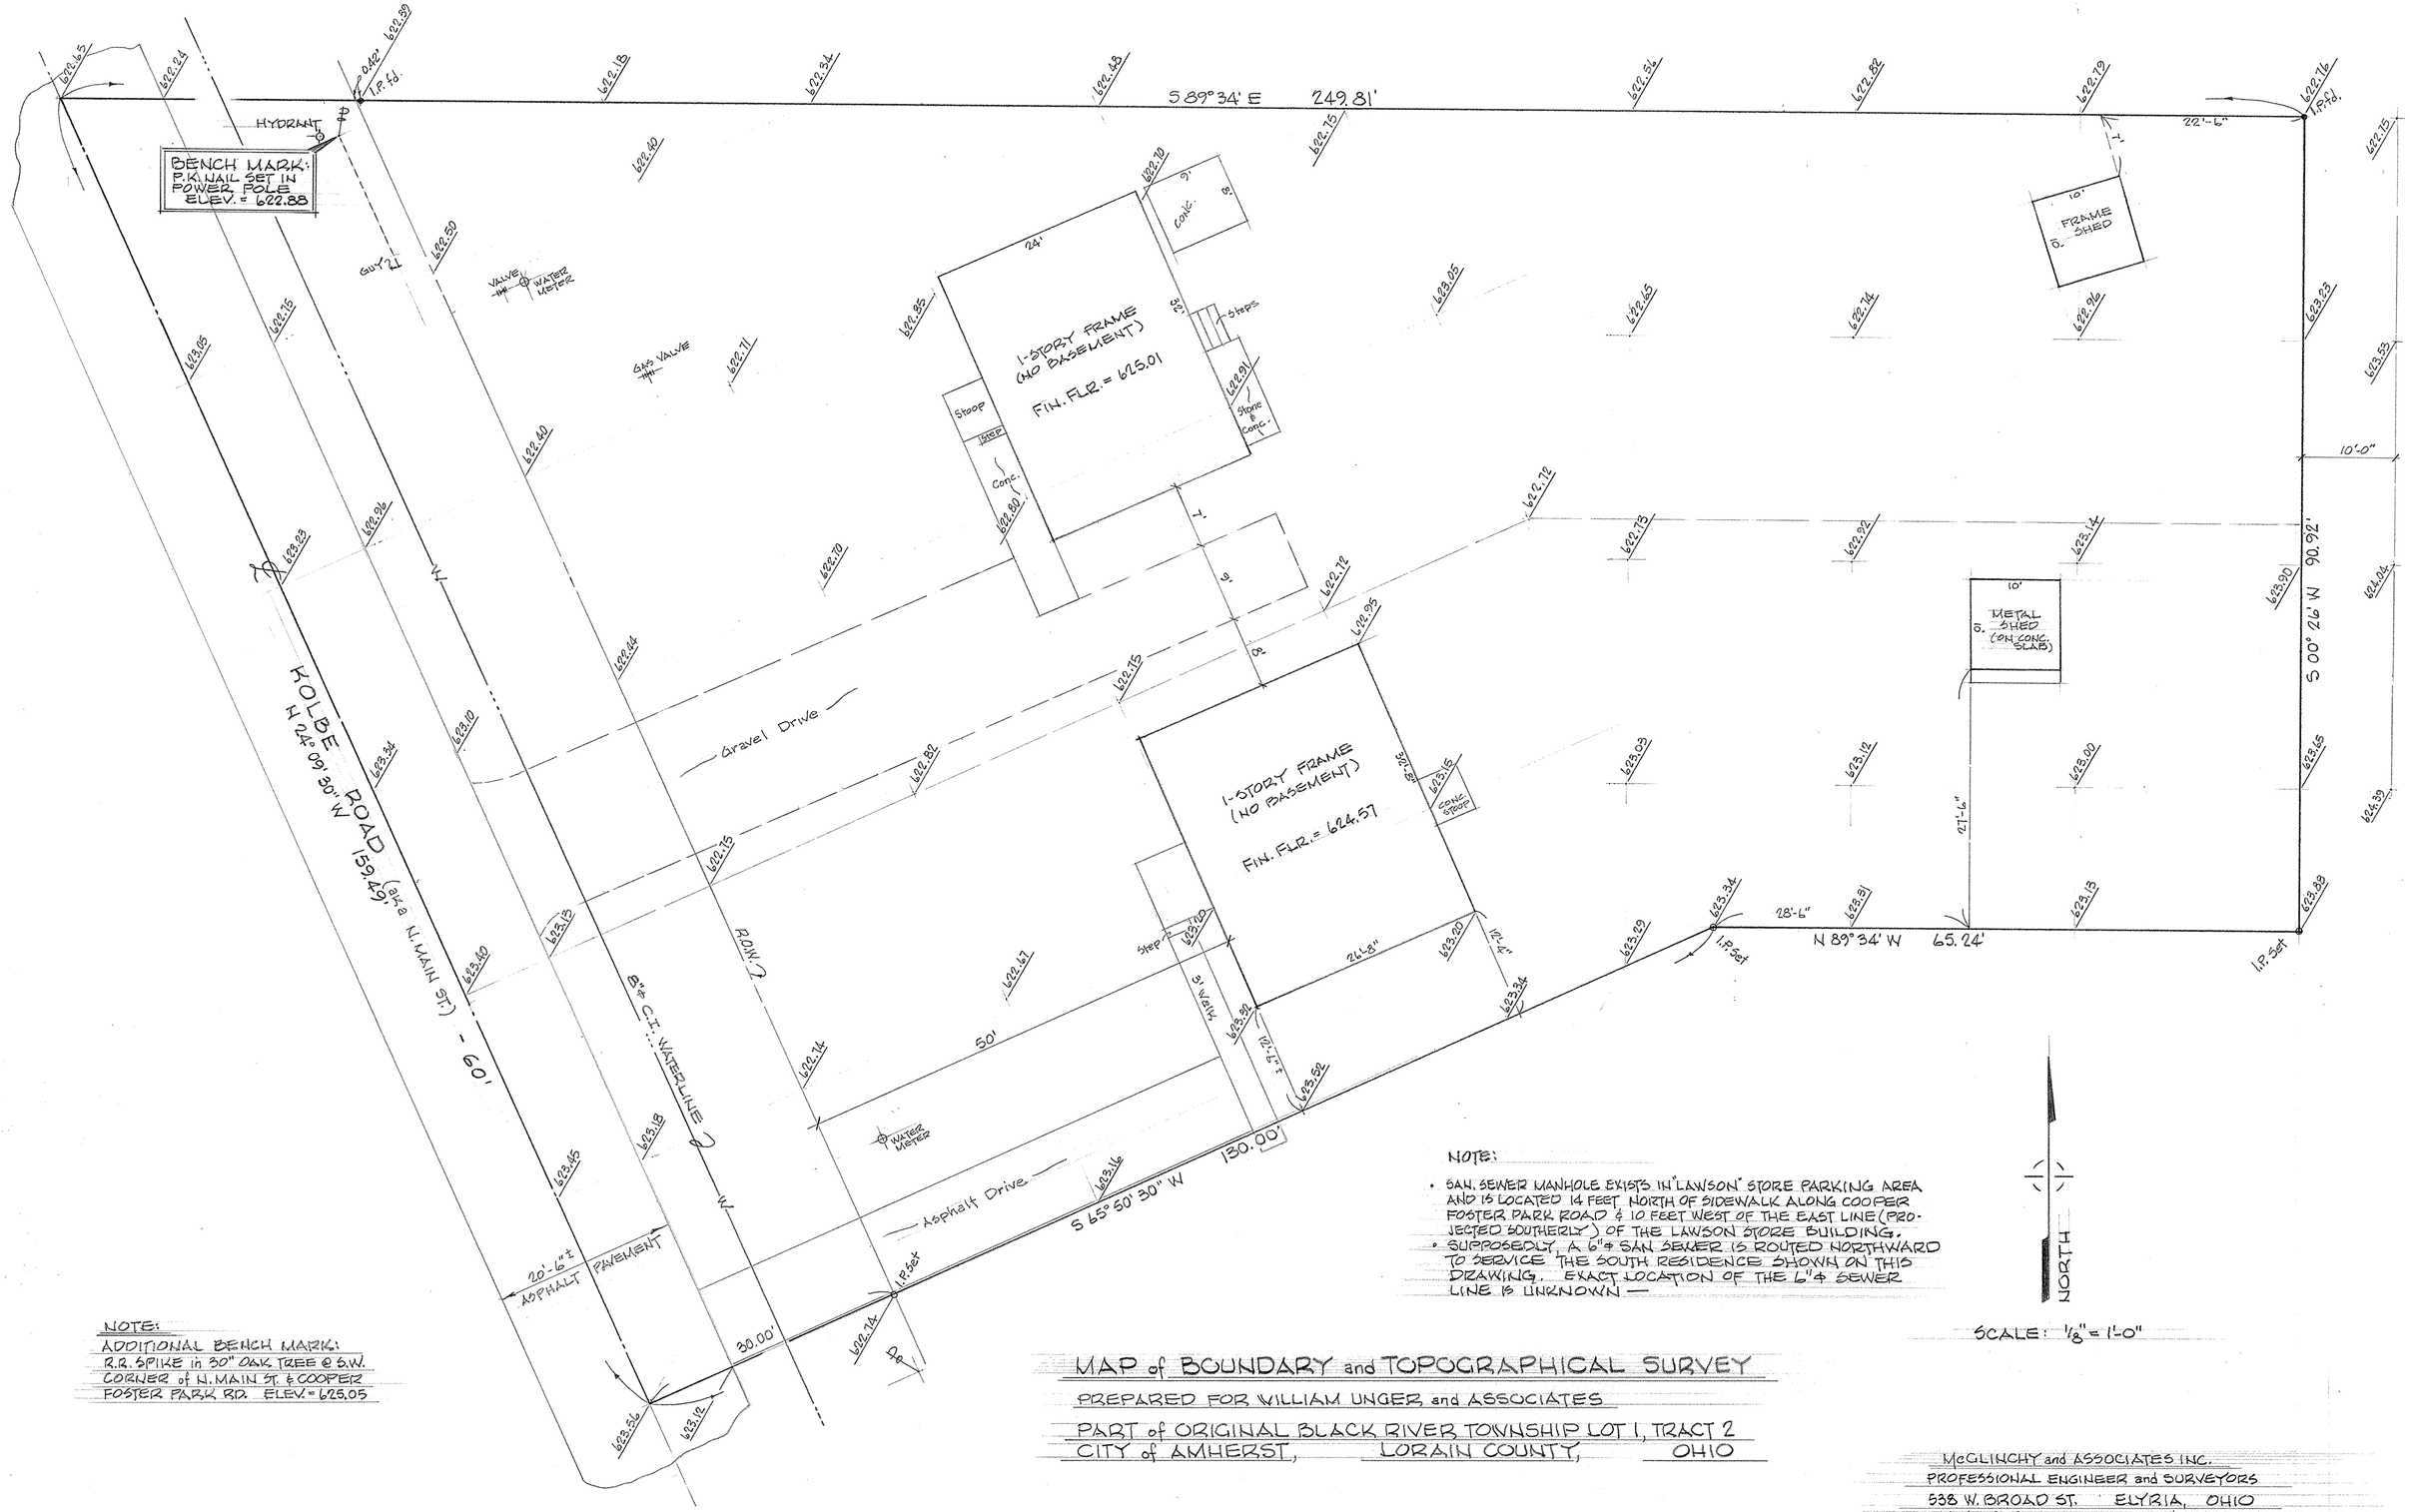

NOTE:

- SAN. SEWER MANHOLE EXISTS IN "LAWSON" STORE PARKING AREA AND IS LOCATED 14 FEET NORTH OF SIDEWALK ALONG COOPER FOSTER PARK ROAD & 10 FEET WEST OF THE EAST LINE (PROJECTED SOUTHERLY) OF THE LAWSON STORE BUILDING.
- SUPPOSEDLY, A 6"ϕ SAN. SEWER IS ROUTED NORTHWARD TO SERVICE THE SOUTH RESIDENCE SHOWN ON THIS DRAWING. EXACT LOCATION OF THE 6"ϕ SEWER LINE IS UNKNOWN —

SCALE: 1/8" = 1'-0"

NOTE:
ADDITIONAL BENCH MARK:
R.R. SPIKE in 30" OAK TREE @ S.W. CORNER of N. MAIN ST. & COOPER FOSTER PARK RD. ELEV. = 625.05

MAP of BOUNDARY and TOPOGRAPHICAL SURVEY

PREPARED FOR WILLIAM UNGER and ASSOCIATES

PART of ORIGINAL BLACK RIVER TOWNSHIP LOT 1, TRACT 2
CITY of AMHERST, LORAIN COUNTY, OHIO

McGLINCHY and ASSOCIATES INC.
PROFESSIONAL ENGINEER and SURVEYORS
538 W. BROAD ST. ELYRIA, OHIO
MAY, 1979 #795133