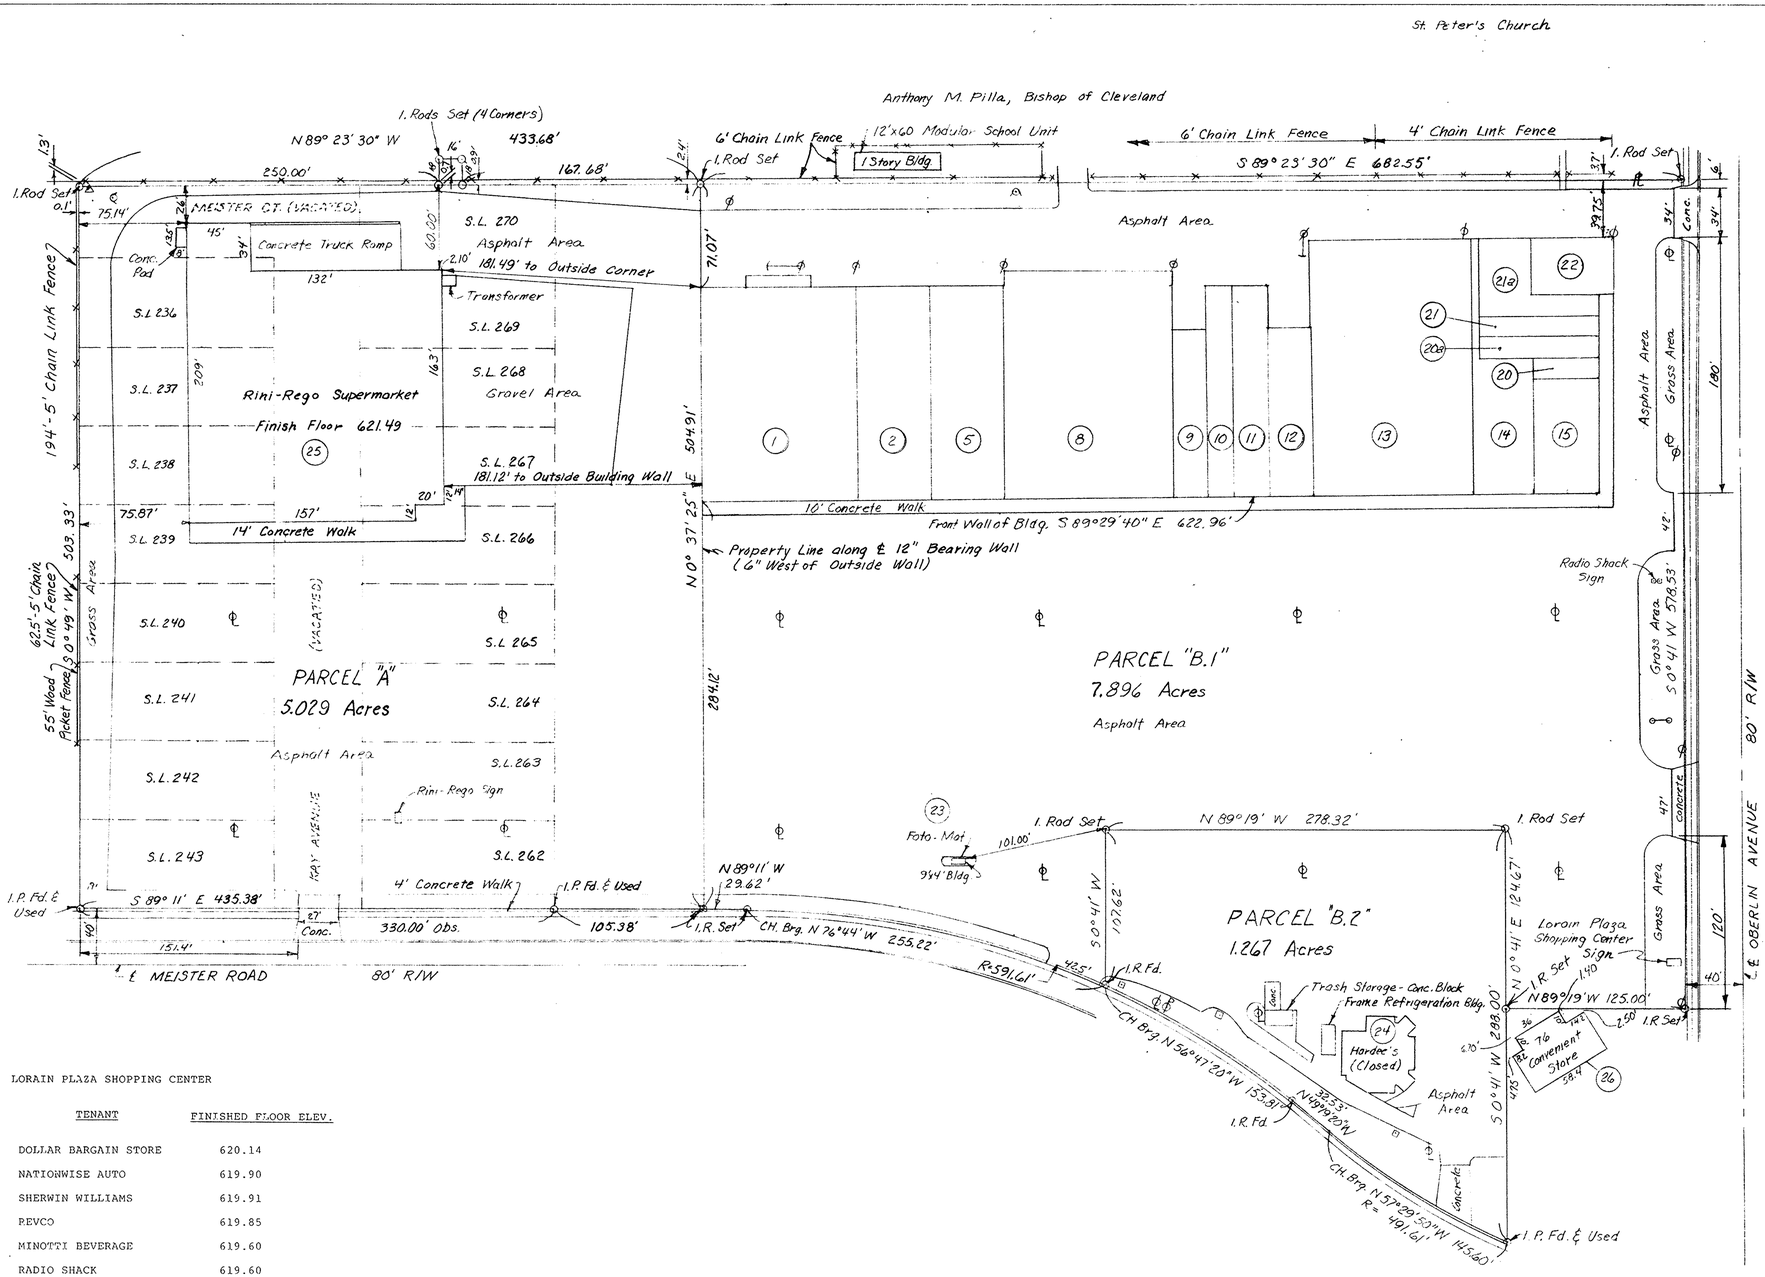

LORAIN PLAZA SHOPPING CENTER

STORE NO.	TENANT	FINISHED FLOOR ELEV.
1	DOLLAR BARGAIN STORE	620.14
2	NATIONWISE AUTO	619.90
5	SHERWIN WILLIAMS	619.91
8	REVCO	619.85
9	MINOTTI BEVERAGE	619.60
10	RADIO SHACK	619.60
11	MARGIES HALLMARK	619.62
12	J. C. PENNEY CATALOG STORE	619.60
13	T. J. MAXX	619.44
14	PAYLESS SHOE STORE	619.28
15	LORAIN NATIONAL BANK	619.19
20	NETWORK VIDEO	619.04
20a	VACANT	619.02
21	RENT-a-CENTER	619.08
21a	BELLA DONNA CLEANERS	619.06
22	HALLMARK CLEANERS	619.05
23	FOTOMAT	617.18
24	HARDEE'S (Vacant)	618.91
25	RINI-REGO	621.49
26	76 CONVENIENT STORE	619.98

BENCH MARK

CITY OF LORAIN NO. 391
CROSS CUT ON TOP OF CURB NORTHEAST CORNER
MARIE AVENUE AND MEISTER ROAD (NORTH END
OF TURNOUT)
ELEV. 44.69
LAKE ERIE CONVERSION 572.62
U. S. G. S. ELEVATION 617.31

STATE OF OHIO
LAWRENCE V. McGLINCHY
4970
REGISTERED
SURVEYOR

PLOT PLAN AND PLAT OF SURVEY

CITY AND COUNTY OF LORAIN, STATE OF OHIO
ORIGINAL BLACK RIVER TOWNSHIP, LOT NO. 6, TRACT NO. 1

PART OF FALBO SUBDIVISION NO. 2, PLAT VOLUME 18, PAGE 7

Revised 11-22-90

McGLINCHY AND ASSOCIATES
PROFESSIONAL ENGINEERS AND SURVEYORS
625 North Woodhill Drive Amherst, Ohio

SCALE: 1" = 50' DRAWN BY: L.V. McGlinchy
DATE: Nov. 4, 1990 JOB NO: 908006