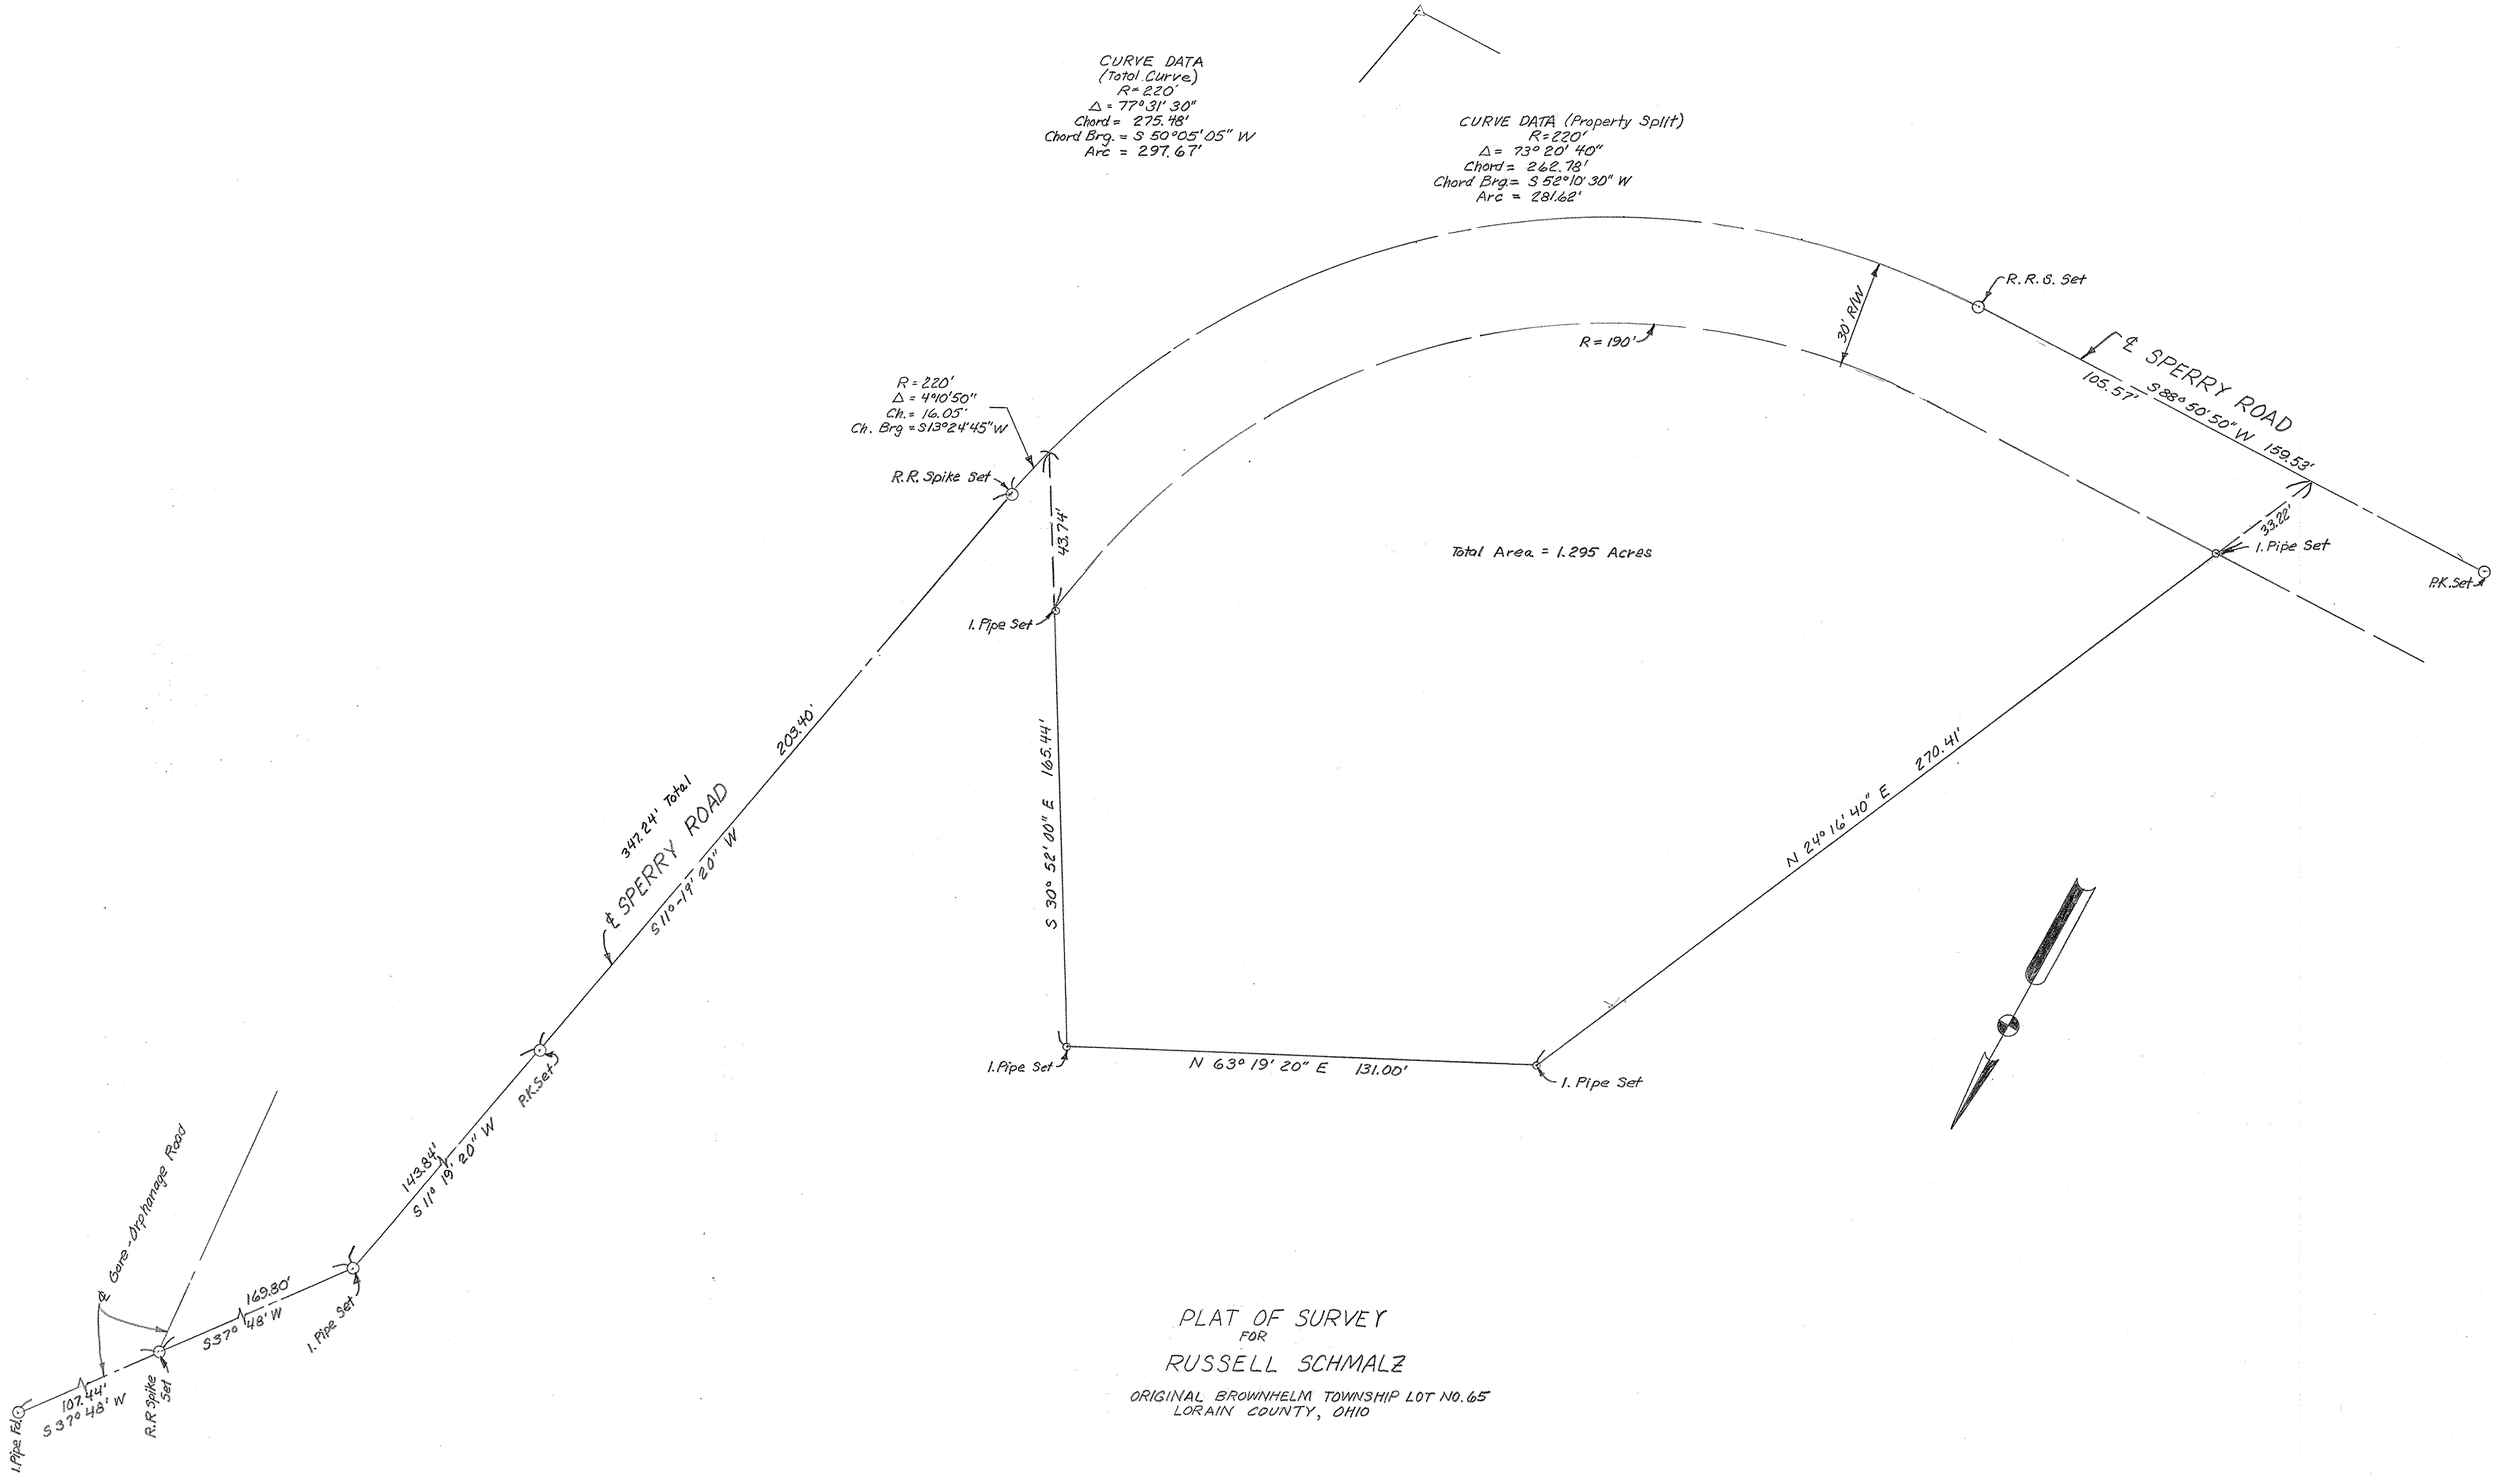

PLAT OF SURVEY
FOR
RUSSELL SCHMALZ

ORIGINAL BROWNHELM TOWNSHIP LOT NO. 65
LORAIN COUNTY, OHIO

McGINLHY AND ASSOCIATES
PROFESSIONAL ENGINEERS AND SURVEYORS
625 North Woodhill Drive Amherst, Ohio

SCALE: 1"=20' DRAWN BY: L. W. McGinchy
DATE: 12/2/90 JOB NO: 908808