

2.9988 Acres

DUE EAST
813.637

838.31 rec.
838.36 calc.
N 89° 59' 56" W

Fence Post
fd. and used
76° 36' 20"
obs.

155.64' obs.
156.88' calc.
S 13° 23' 40" W

NORFOLK & WESTERN R.R.
(AND WHEELING & LAKE ERIE R.R.)

I.P. fd. 1.24' North
of S.E. Corner


MAP of SURVEY

PART of ORIGINAL RUSSIA TOWNSHIP LOT 14
VILLAGE of SOUTH AMHERST, LORAIN COUNTY, OHIO

PP # 09-00-014-102-007

PREPARED FOR:
CARL VISCI JR.
PINECREST APTS.-C-3
MIDDLE RIDGE RD.
AMHERST, OHIO 44001

McGLINCHY & ASSOCIATES
REGISTERED ENGINEER & SURVEYORS
ELYZIA OHIO
JUNE 16, 1977 JOB# 772082

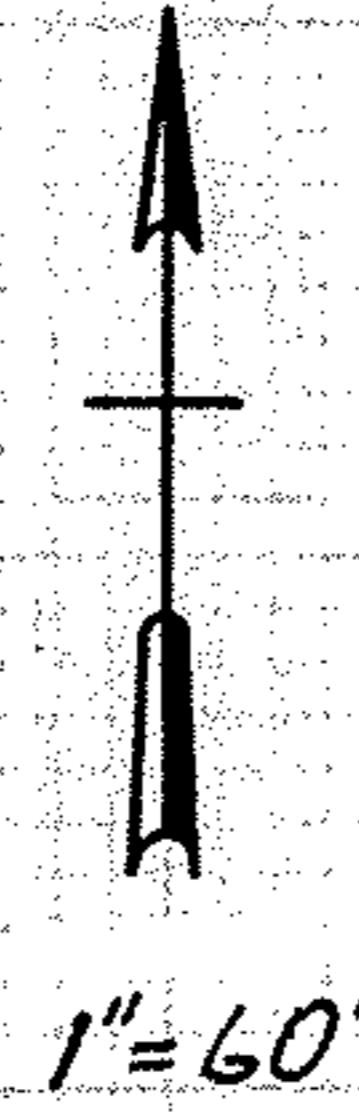

ANNIS ROAD - 50'

152.60'
N 00° 24' E

1500.54'

RUSSIA RD.

Drill Hole in Iron Pin
in Monument Box

175.00'

175.00'

I.P. Set

I.P. Set

I.P. Set

I.P. Set

φ

φ

25'

25'






