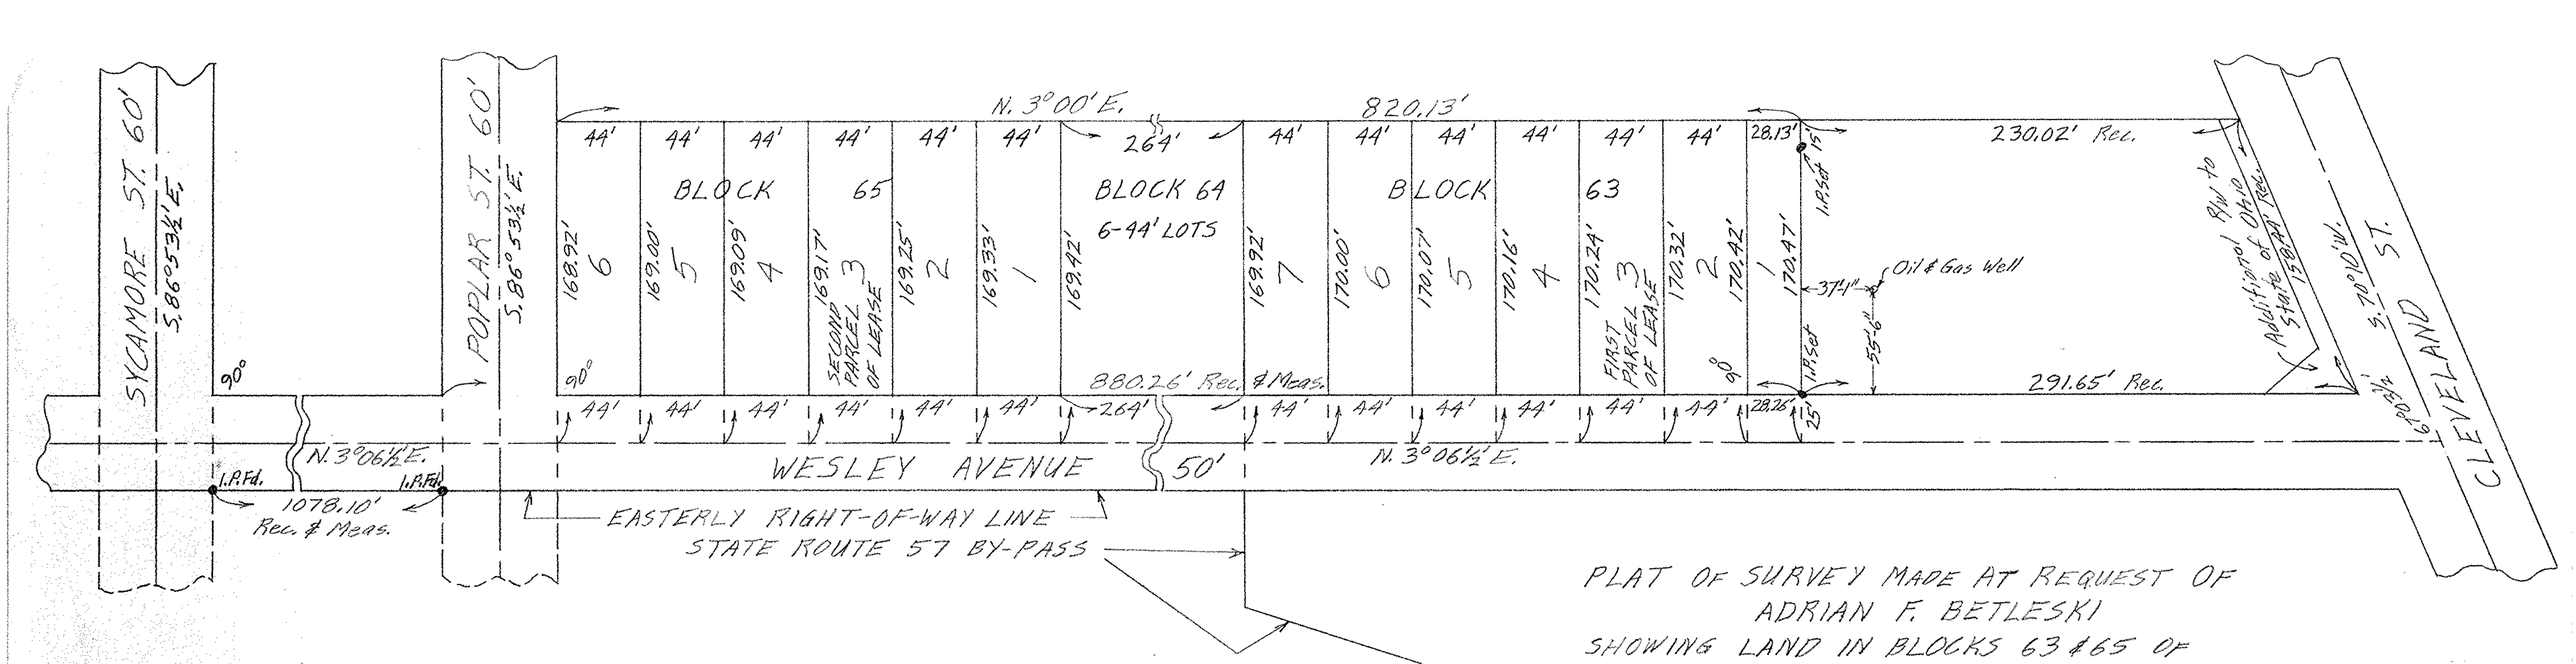

I hereby certify that this map shows the true and accurate location of the oil & gas well in question in relation to Block 63 of City Farms Allotment. I also certify that no evidence was found of a oil & gas well having been drilled on Sub-Lot No. 3 of Block 63.

PLAT OF SURVEY MADE AT REQUEST OF
ADRIAN F. BETLESKI
SHOWING LAND IN BLOCKS 63 & 65 OF CITY FARMS ALLOTMENT - VOL. 9 PG. 3 PLATS AS REFERRED TO IN LEASE RECORDED IN LEASE VOL. 57 PG. 322 LORAIN COUNTY RECORDS ALSO ACTUAL LOCATION OF OIL & GAS WELL ON ADJOINING PROPERTY AS DETERMINED BY FIELD SURVEY IN ELYRIA CITY - LORAIN COUNTY - OHIO

SCALE: 1" = 60' MARCH 27-1961

Gary E. Penfound Reg. Surveyor No. 4457

06-25-023