PLAT OF SURVEYS FOR
ADOLPH E. & EDNA R. STUDEBAKER

ORIGINAL LOT NO. 9 - WELLINGTON TOWNSHIP
LORAIN COUNTY OHIO
SCALE: 1"=100' JUNE 6-1969
Gary E. Penfound Reg. Surveyor No. 4457

NOTE: ● indicates iron pin set June 1969.
○ indicates iron pin found or set previous survey.

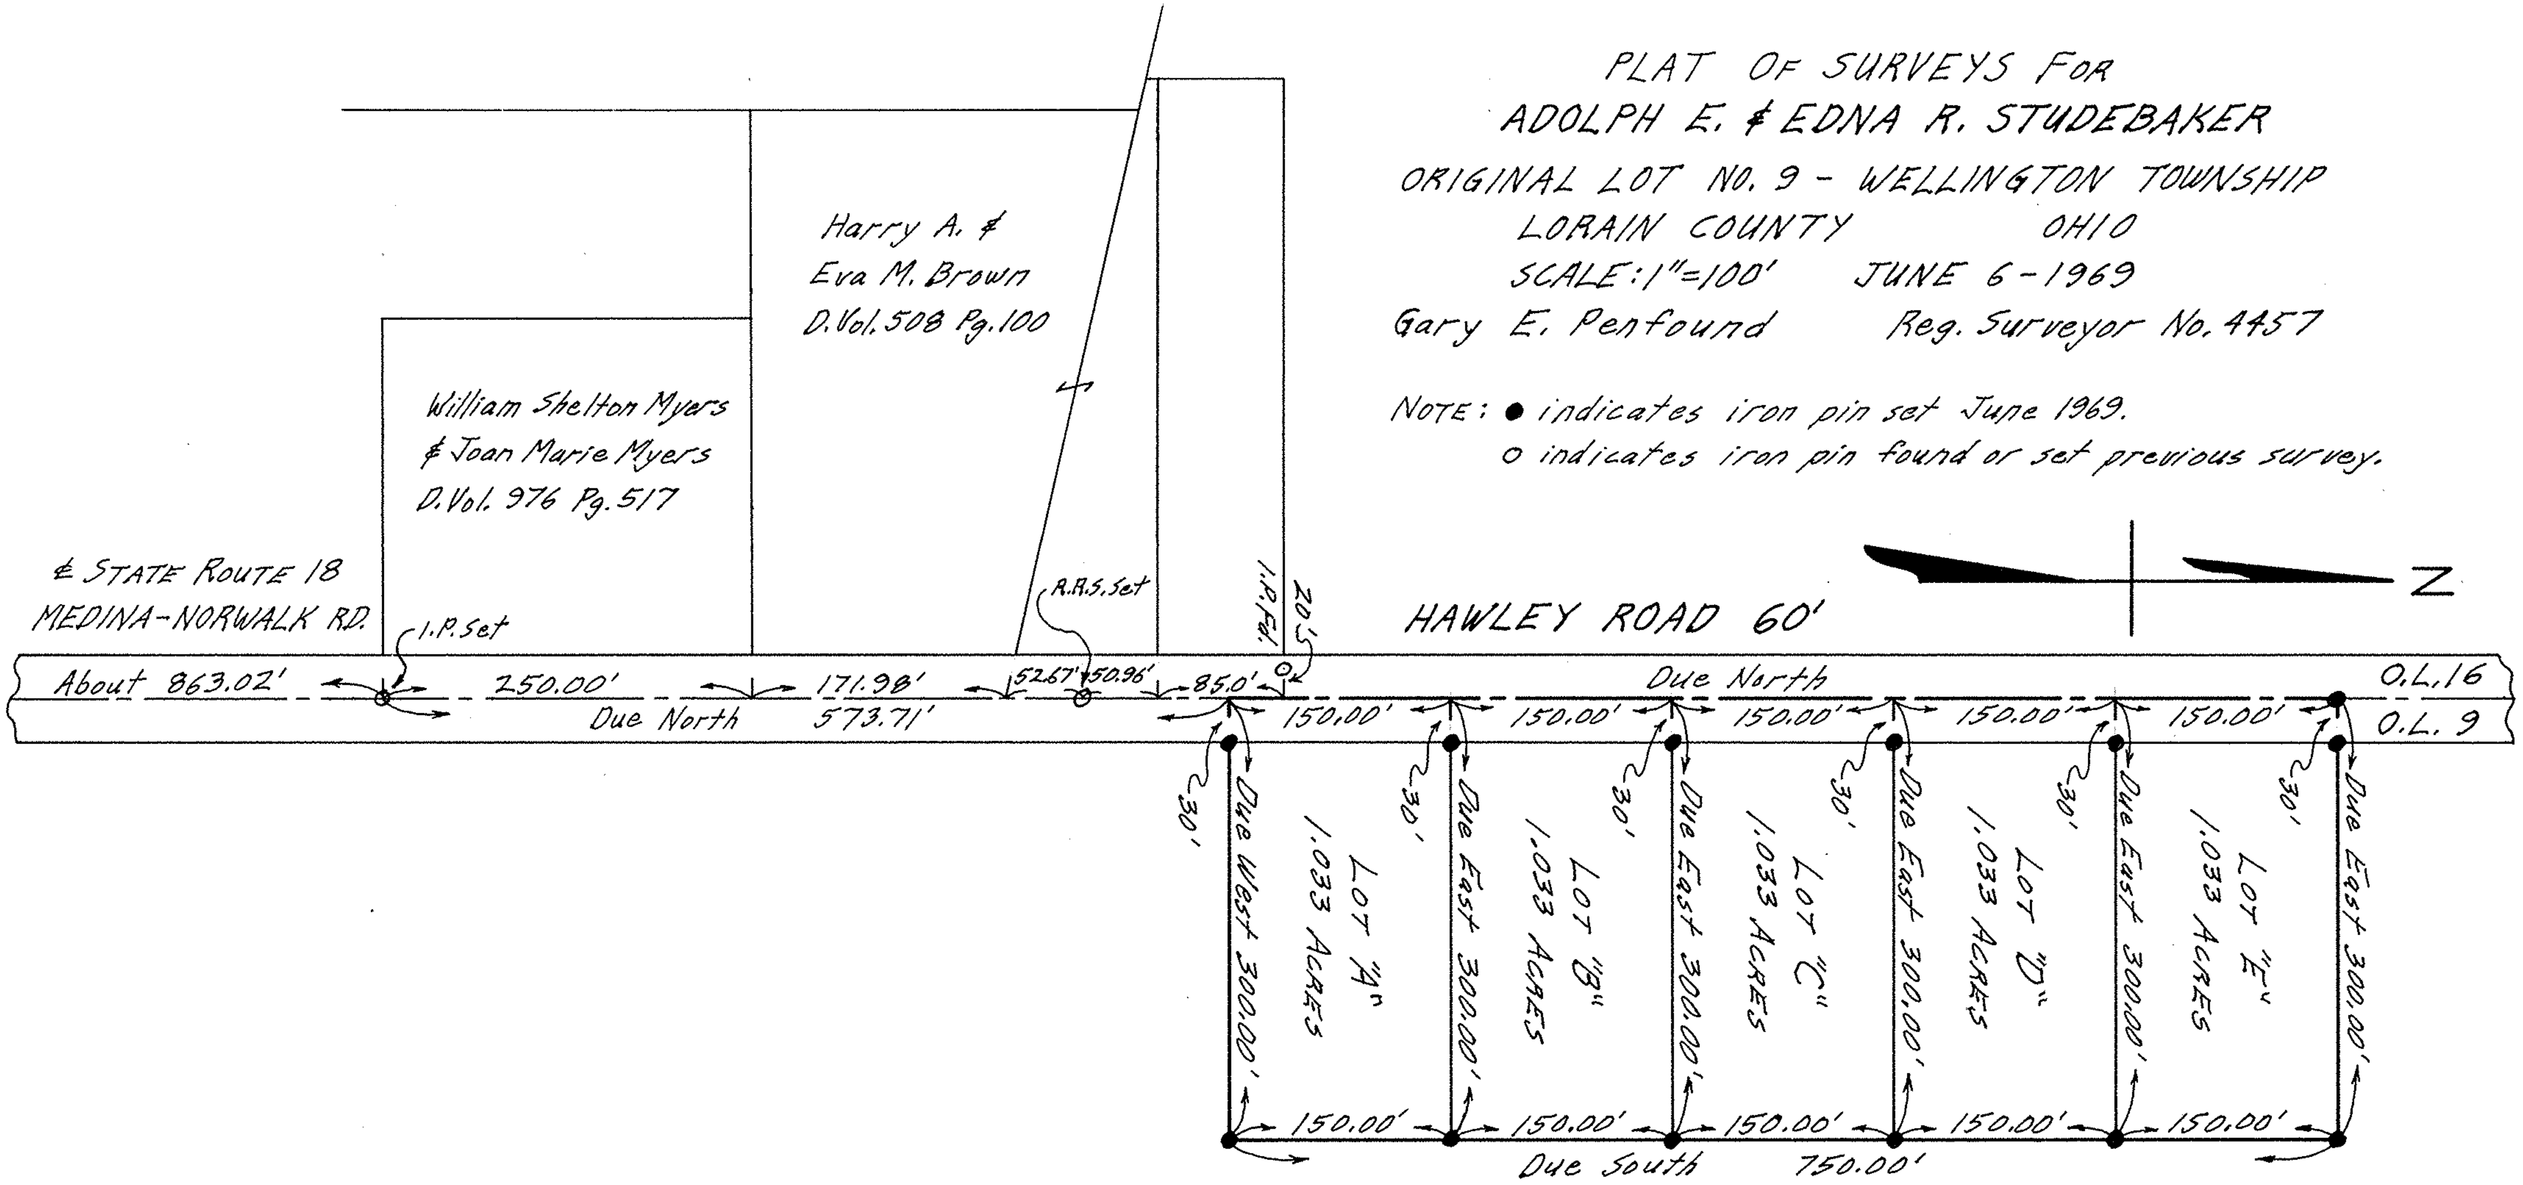

18-00-009