PLAT OF SURVEY AND OIL LINE LOCATION FOR DELLEN D. & FLORIS W. BROUSE

ORIGINAL LOT 29 WELLINGTON TWP.
LORAIN COUNTY OHIO
SCALE: 1" = 30' OCTOBER 7-8, 1973
Gary E. Penfound Reg. Surveyor No. 4457

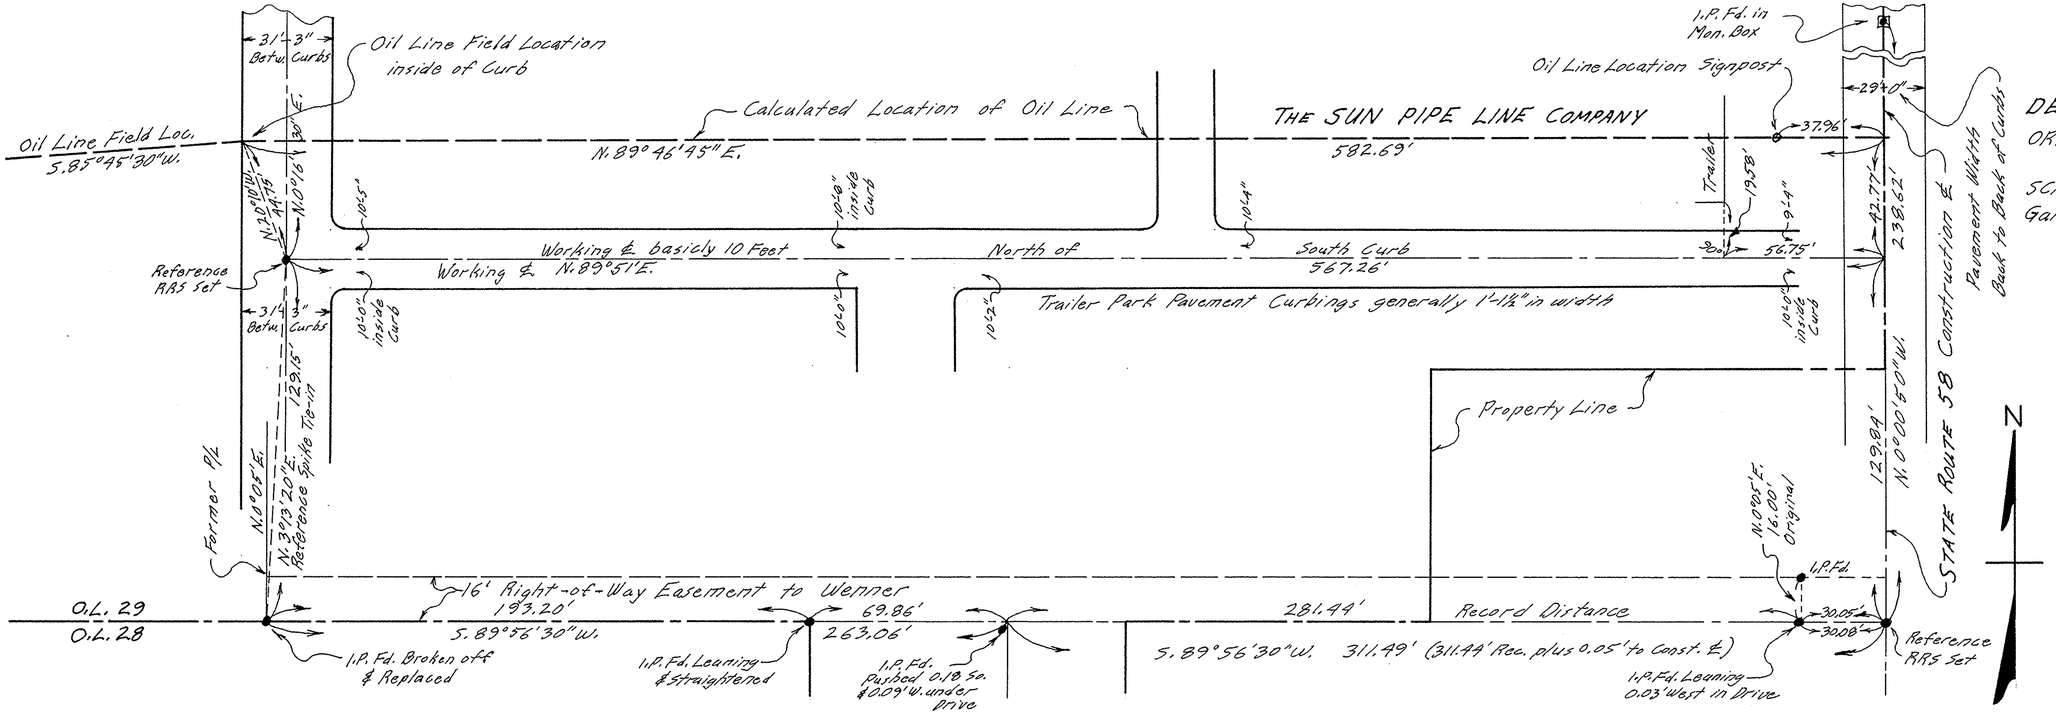

18-00-029