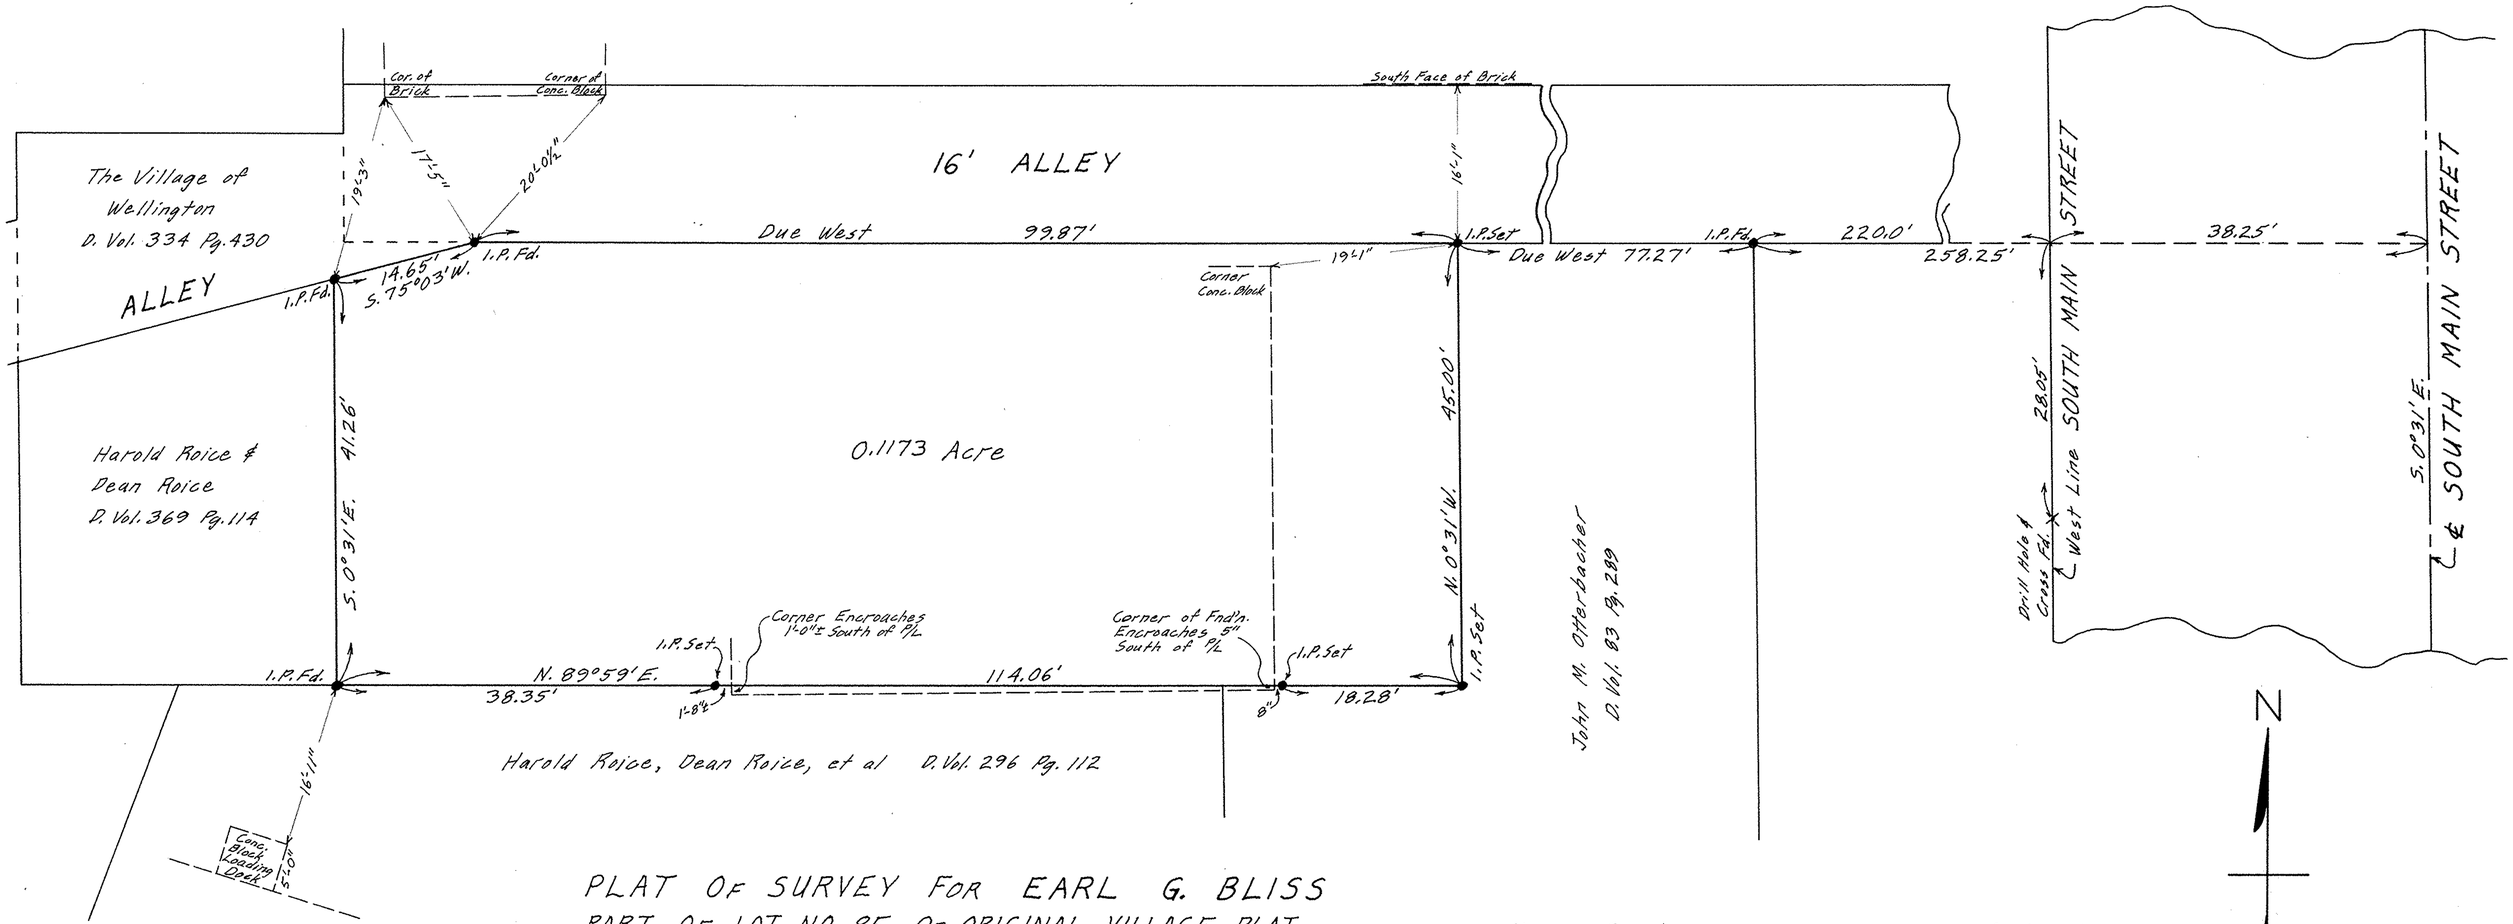

PLAT OF SURVEY FOR EARL G. BLISS
PART OF LOT NO. 85 OF ORIGINAL VILLAGE PLAT
ORIGINAL LOT NO. 27 WELLINGTON TOWNSHIP
WELLINGTON VILLAGE - LORAIN COUNTY - OHIO
SCALE: 1" = 10' SEPTEMBER 1965
Gary E. Penfound Registered Surveyor No. 4457

NOTES: Survey measurements given in feet and decimals.
Reference measurements given in feet and inches.

18-00-027