PLAT OF SURVEYS FOR DONALD & PHYLLIS R. BODEN

ORIGINAL LOTS 91 & 92 – LAGRANGE TWP. – LORAIN COUNTY – OHIO

SCALE: 1" = 100' – DECEMBER 1971 – Gary E. Penfound Reg. Surveyor No. 4957

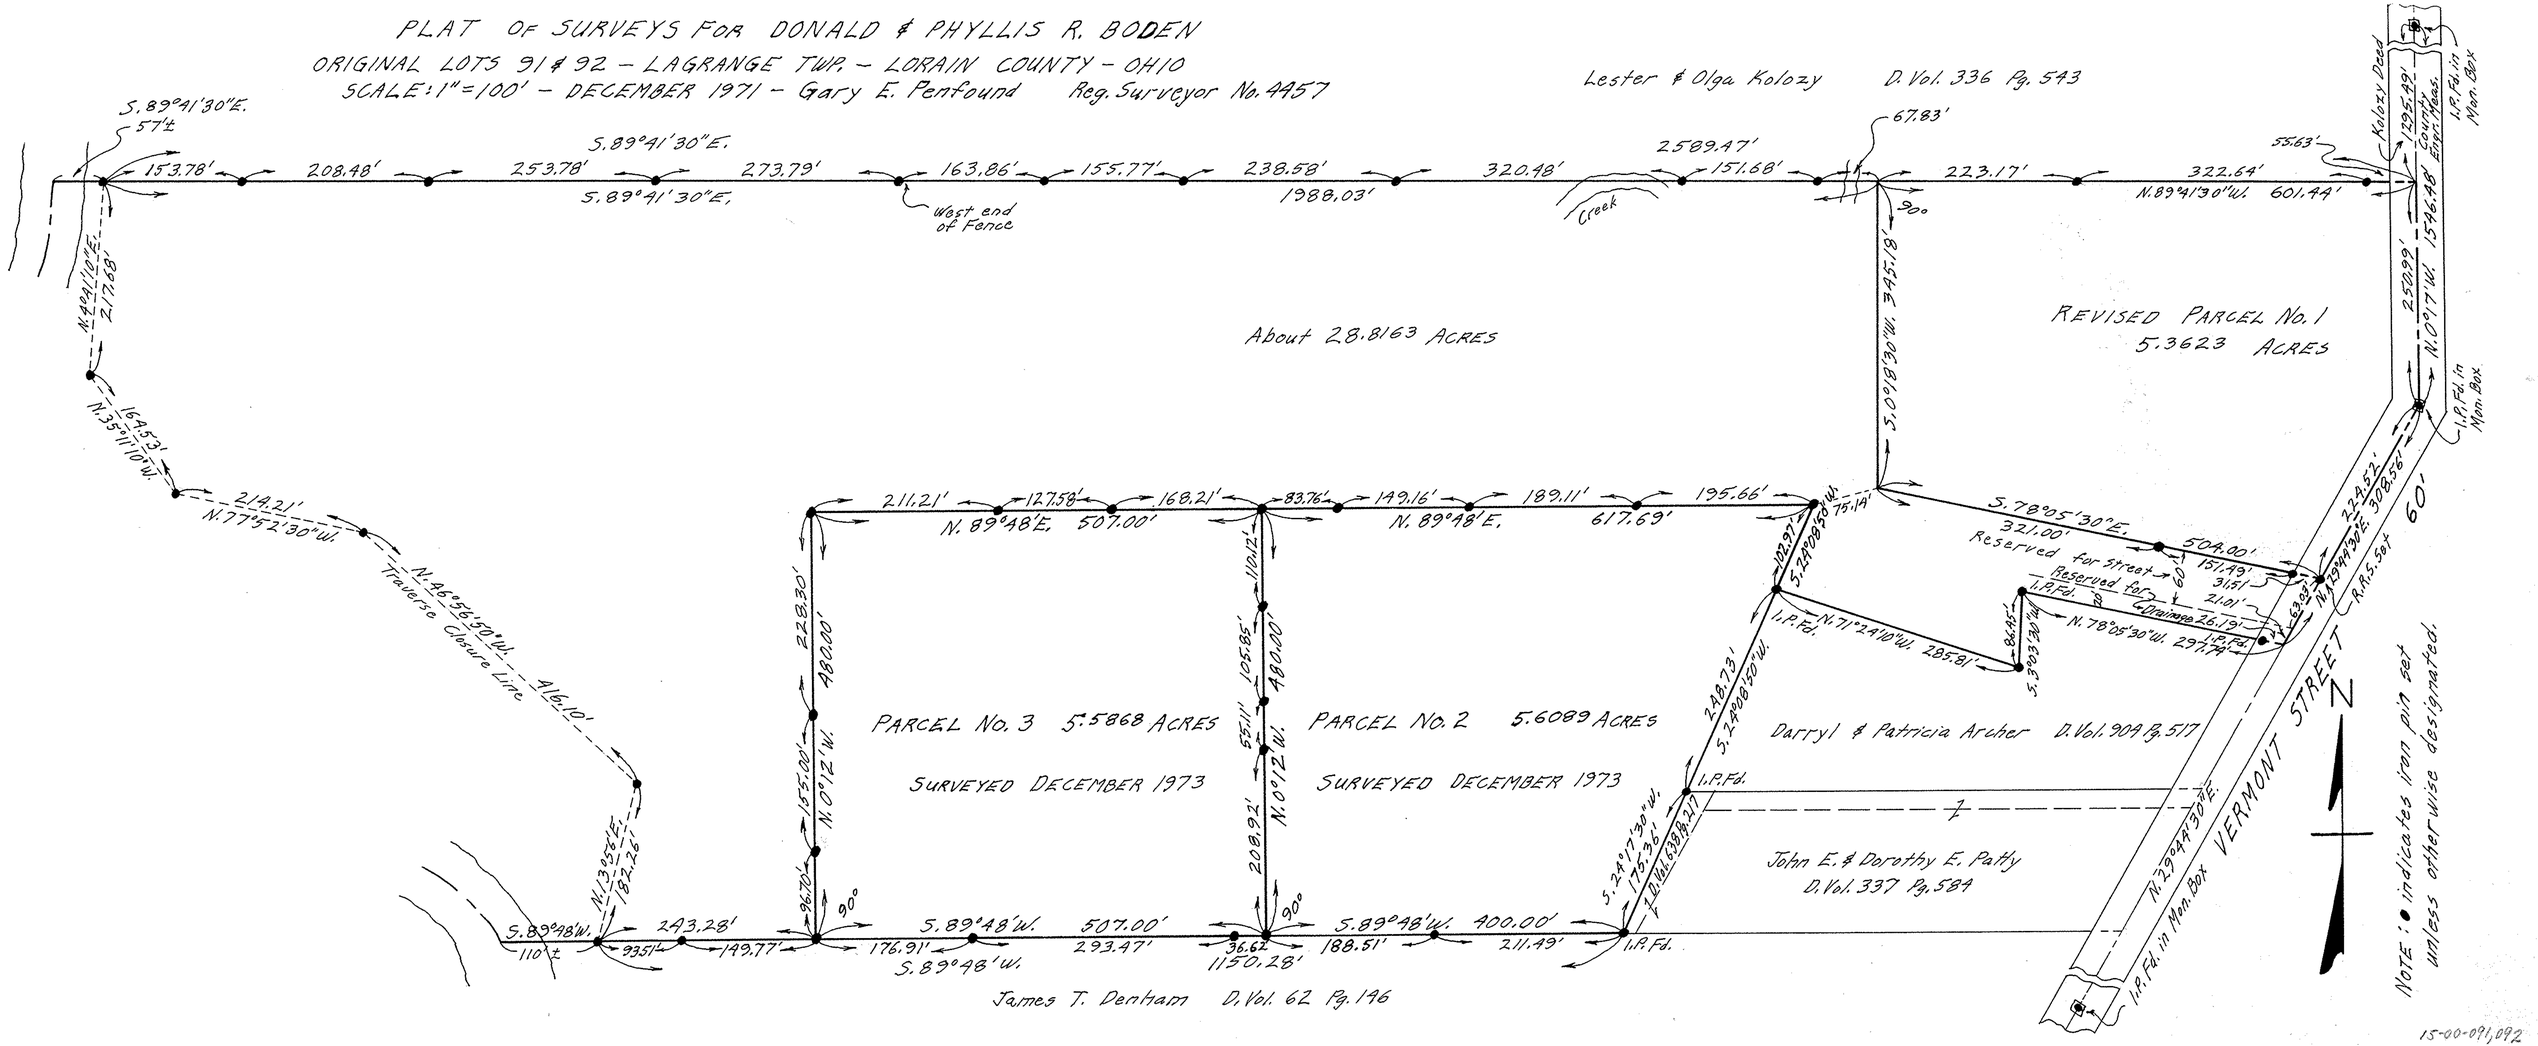

NOTE: ● indicates iron pin set unless otherwise designated.

15-00-091,092