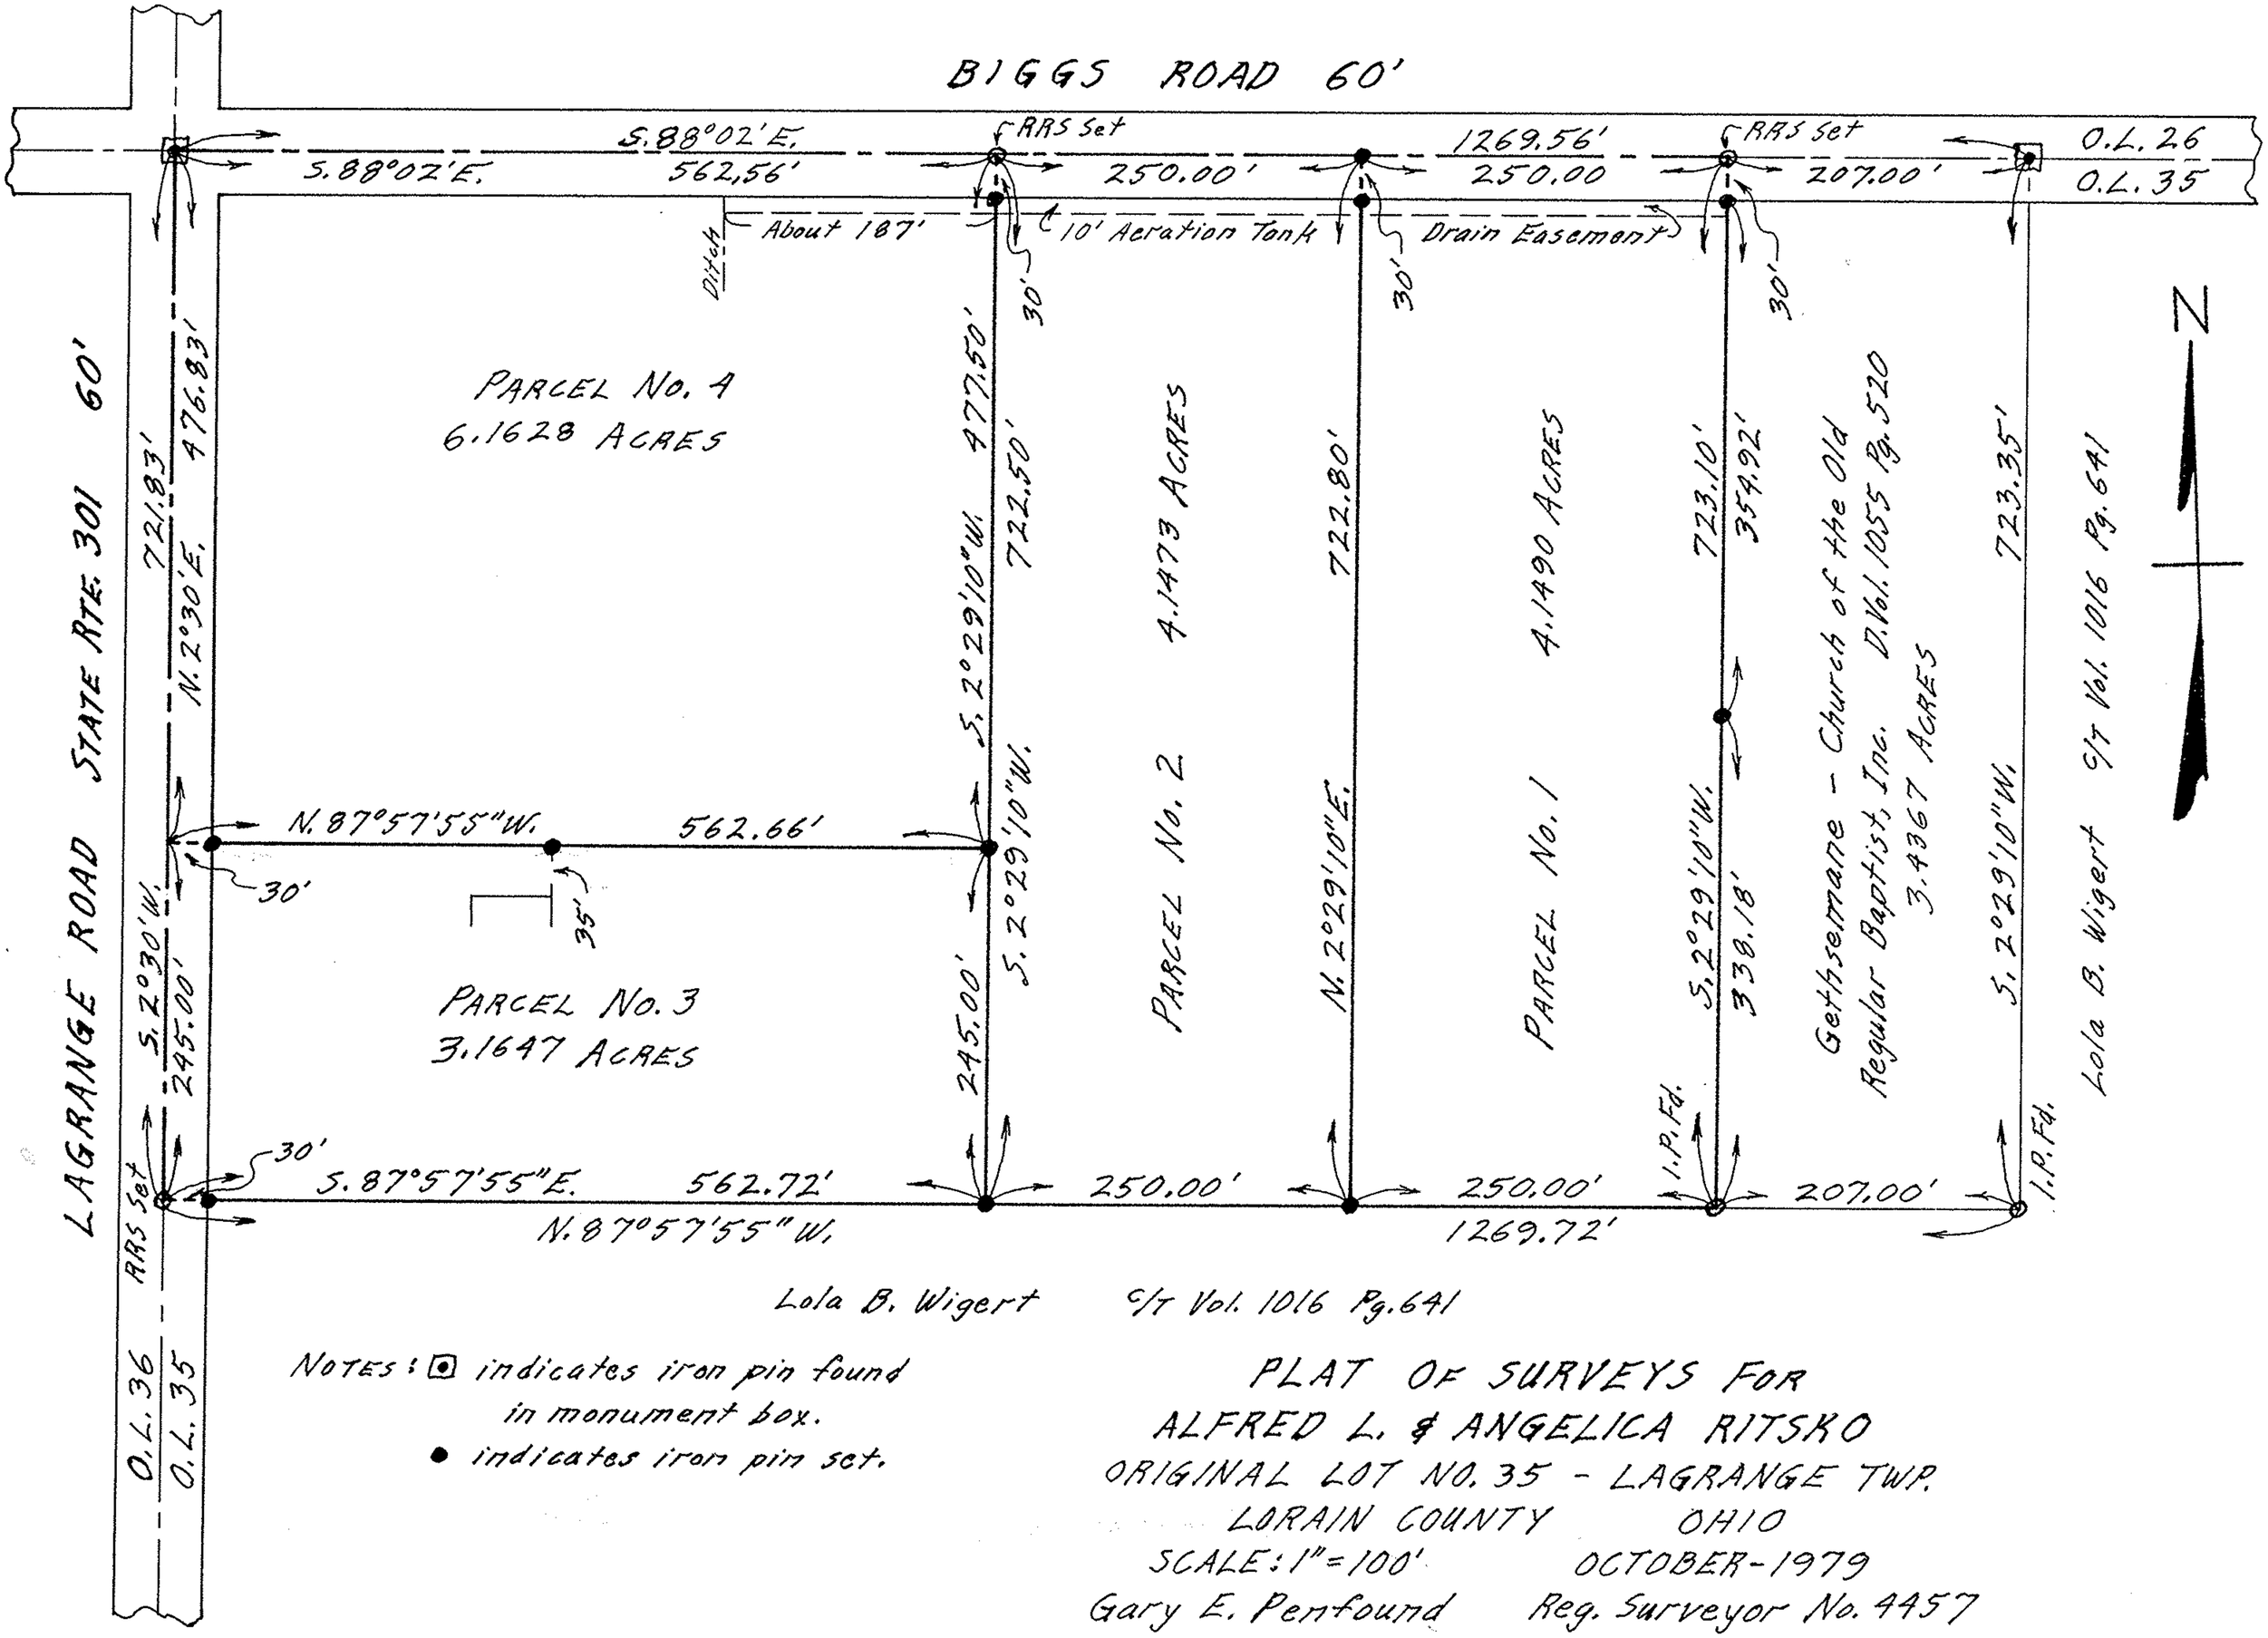

Lola B. Wigert C/T Vol. 1016 Pg. 641

NOTES: ⊡ indicates iron pin found in monument box.
● indicates iron pin set.

PLAT OF SURVEYS FOR
ALFRED L. & ANGELICA RITSKO
ORIGINAL LOT NO. 35 - LAGRANGE TWP.
LORAIN COUNTY OHIO
SCALE: 1" = 100' OCTOBER-1979
Gary E. Penfound Reg. Surveyor No. 4457

15-00-035