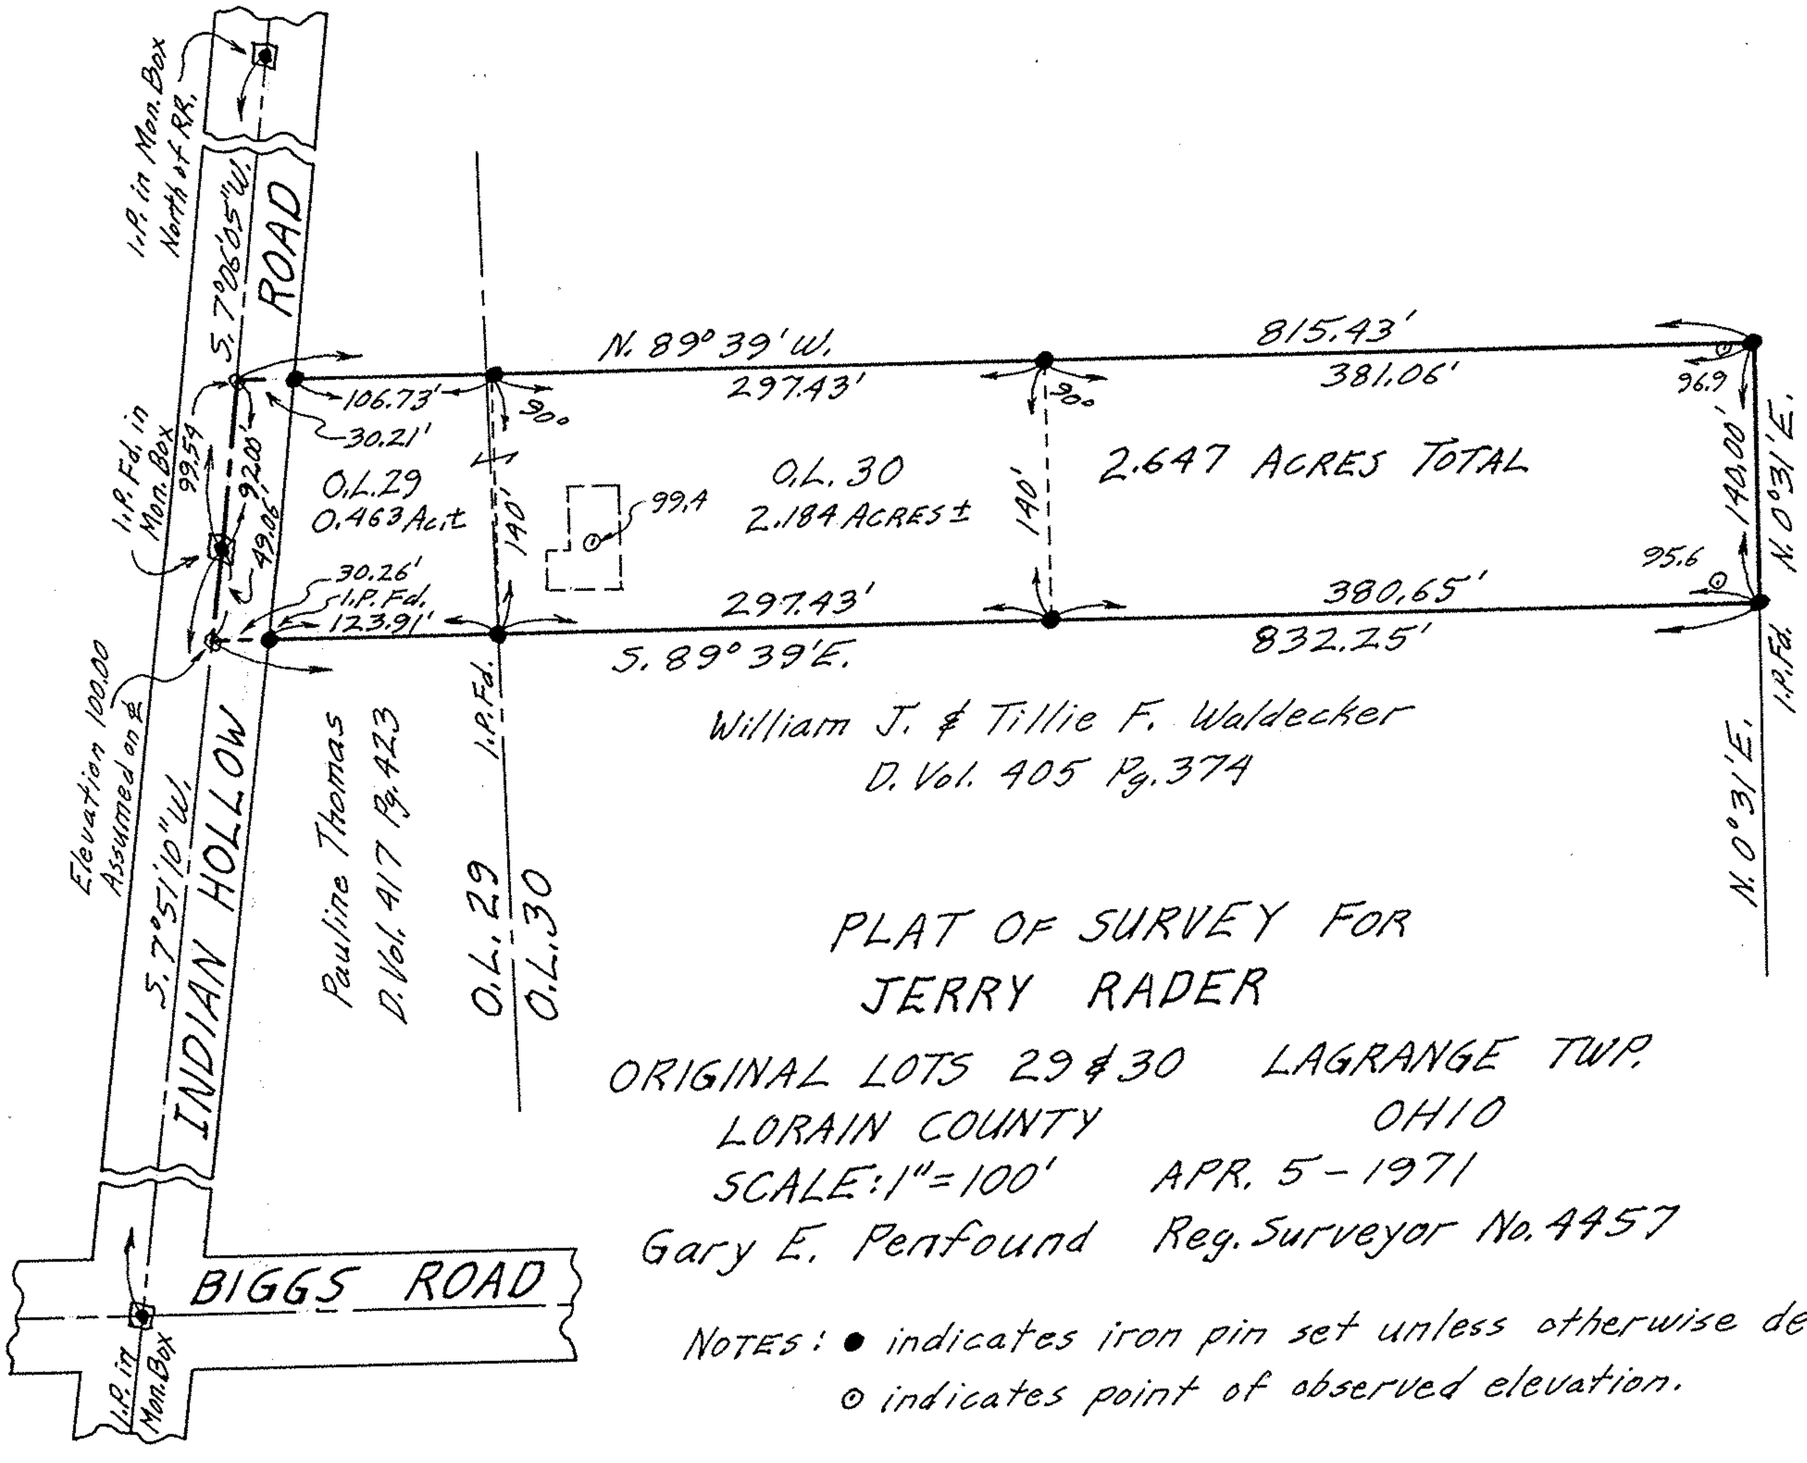

PLAT OF SURVEY FOR JERRY RADER

ORIGINAL LOTS 29 & 30 LAGRANGE TWP.
LORAIN COUNTY OHIO
SCALE: 1"=100' APR. 5-1971
Gary E. Penfound Reg. Surveyor No. 4457

NOTES: ● indicates iron pin set unless otherwise designated.
⊙ indicates point of observed elevation.

15-00-029,030