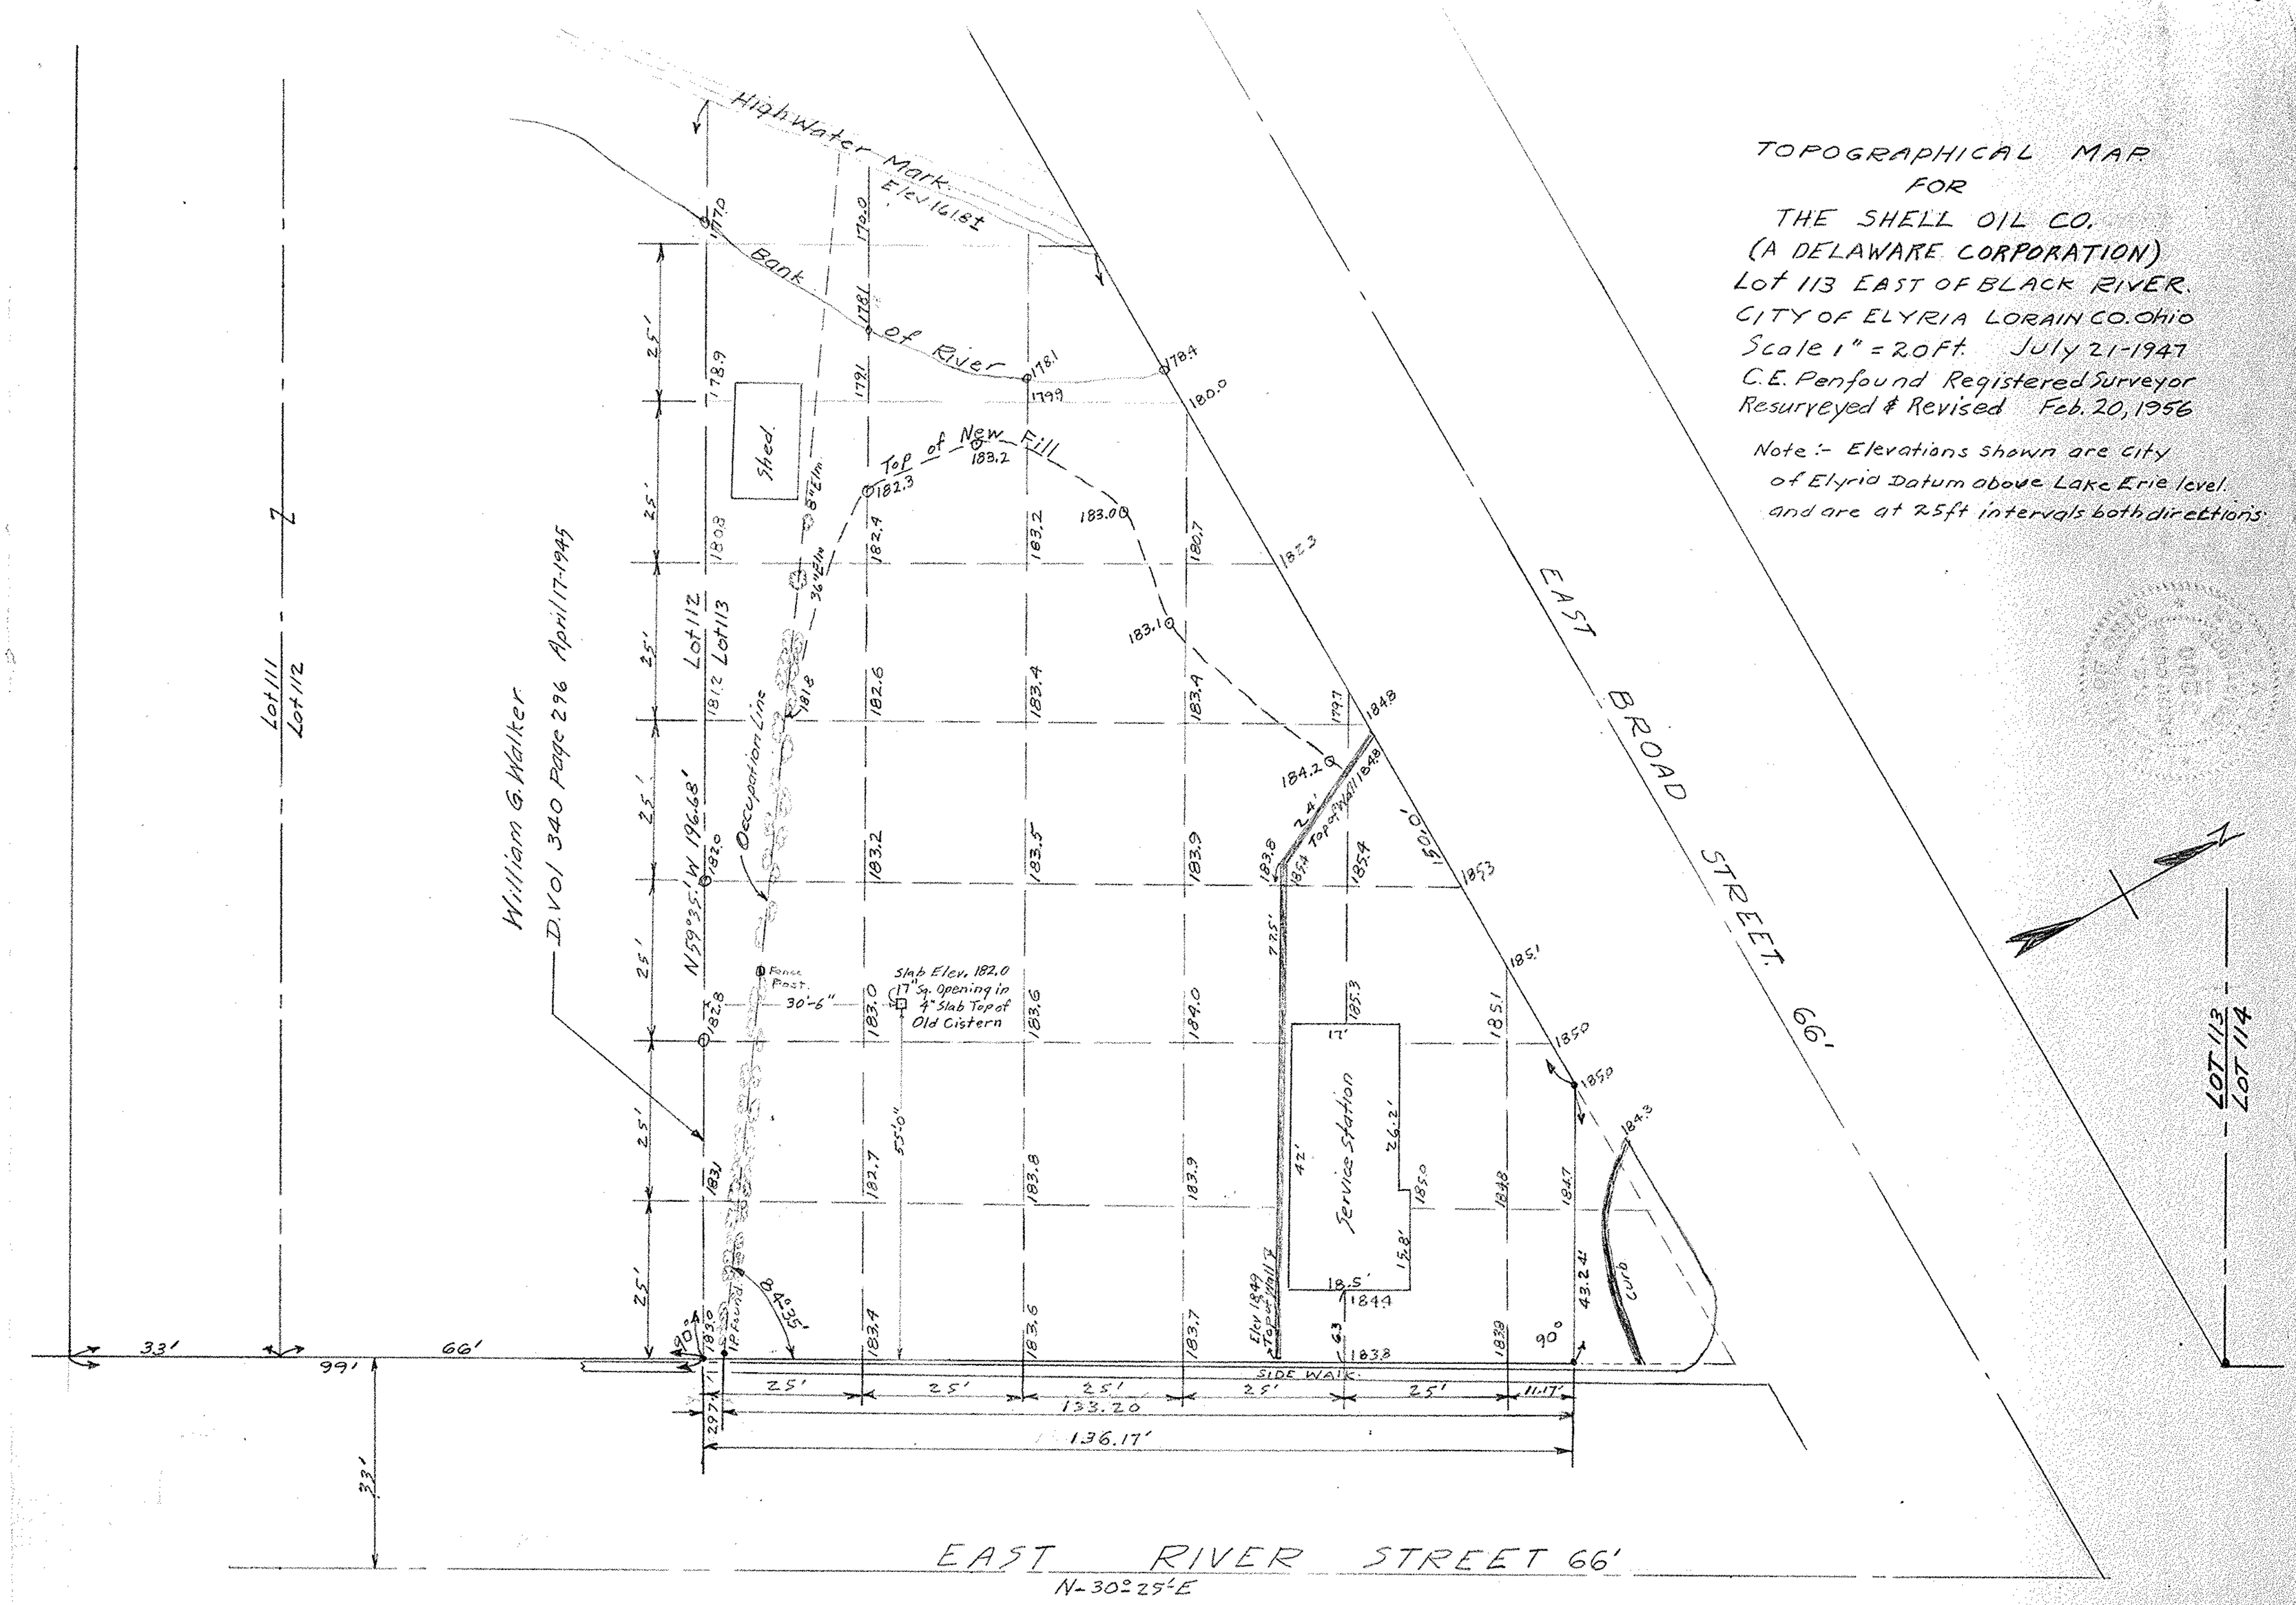
TOPOGRAPHICAL MAP
FOR
THE SHELL OIL CO.
(A DELAWARE CORPORATION)
Lot 113 EAST OF BLACK RIVER.
CITY OF ELYRIA LORAIN CO. Ohio
Scale 1" = 20 Ft. July 21-1947
C.E. Penfound Registered Surveyor
Resurveyed & Revised Feb. 20, 1956
Note :- Elevations shown are city of Elyria Datum above Lake Erie level. and are at 25 ft intervals both directions.
High Water Mark
Elev. 161.8±
Bank of River
Top of New Fill
Shed
Occupation Line
William G. Walker
D.Vol 340 Page 296 April 17-1945
Lot 111
Lot 112
Lot 113
Lot 114
Fence Post
30'-6"
Slab Elev. 182.0
17" Sq. Opening in 4" Slab Top of Old Cistern
Service Station
Top of Wall 184.8
Elev 184.9 Top of Wall
Curb
SIDE WALK
133.20
136.17'
EAST BROAD STREET 66'
EAST RIVER STREET 66'
N-30°25'-E
N59°35'W 196.68'
84°35'
90°
33'
99'
66'
LOT 113
LOT 114

06-25-113