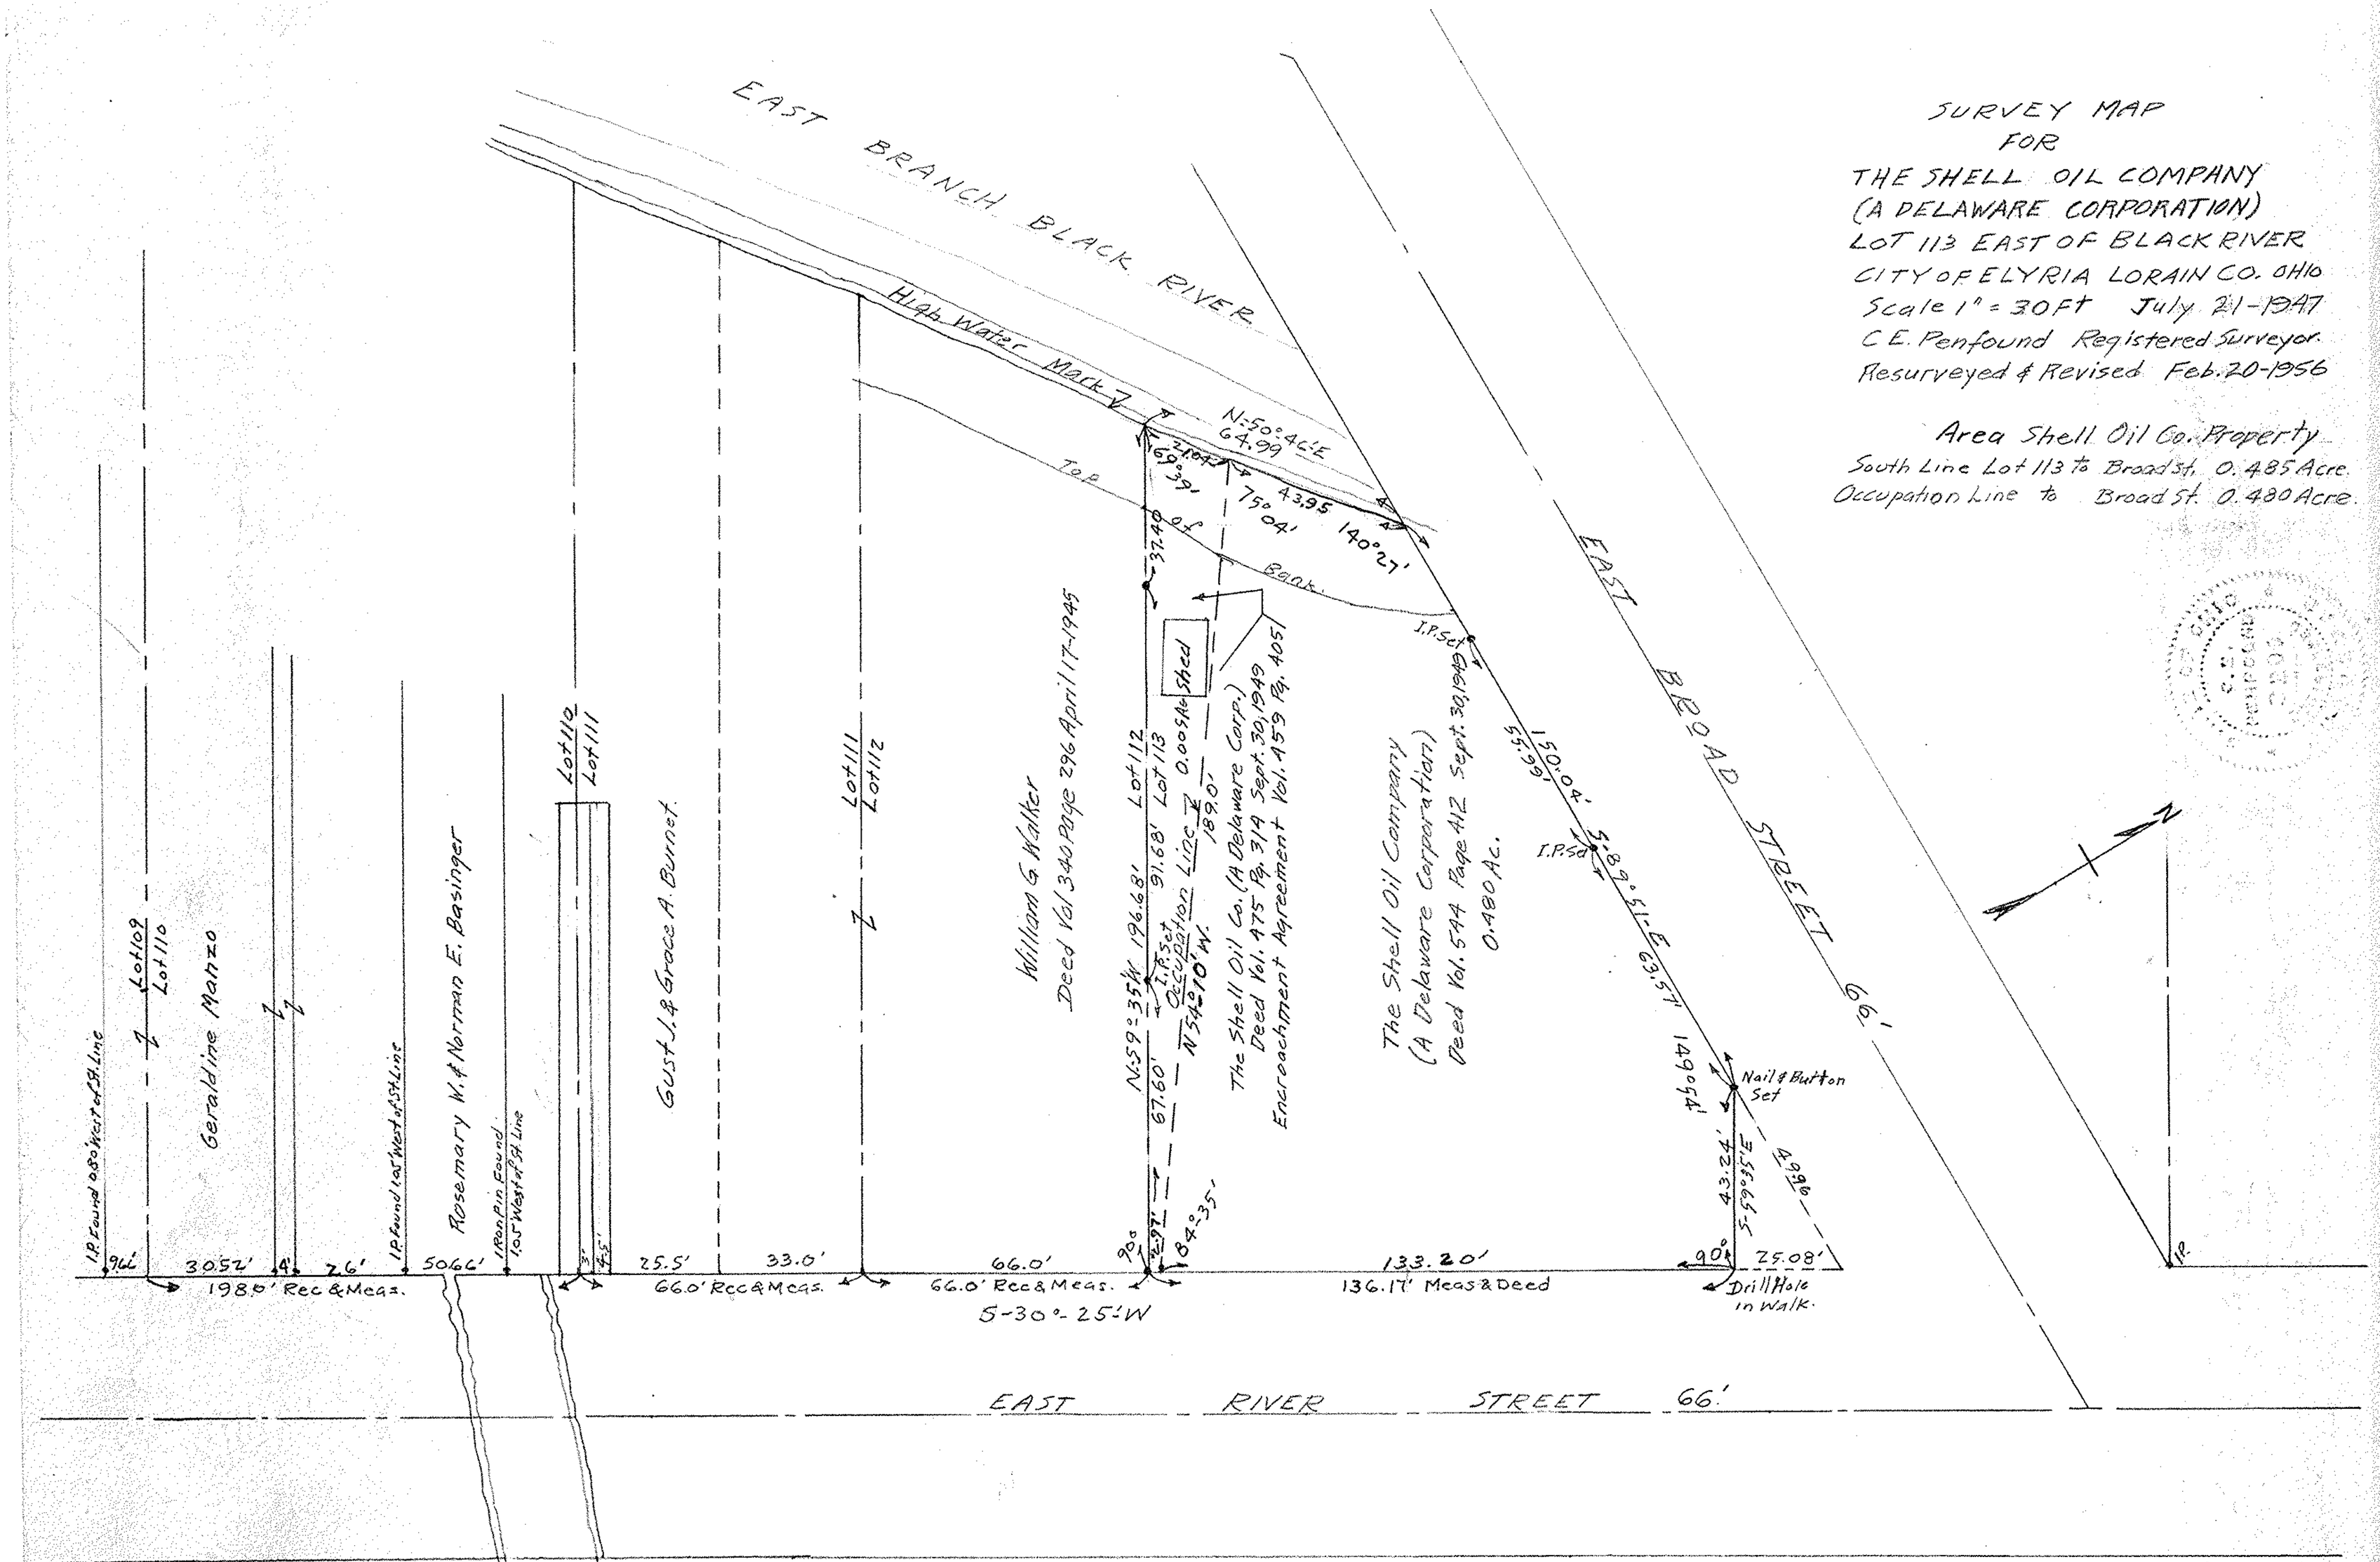

SURVEY MAP
FOR
THE SHELL OIL COMPANY
(A DELAWARE CORPORATION)
LOT 113 EAST OF BLACK RIVER
CITY OF ELYRIA LORAIN CO. OHIO
Scale 1" = 30 Ft July 21-1947
C.E. Penfound Registered Surveyor.
Resurveyed & Revised Feb. 20-1956

Area Shell Oil Co. Property
South Line Lot 113 to Broad St. 0.485 Acre.
Occupation Line to Broad St. 0.480 Acre.

06-25-113