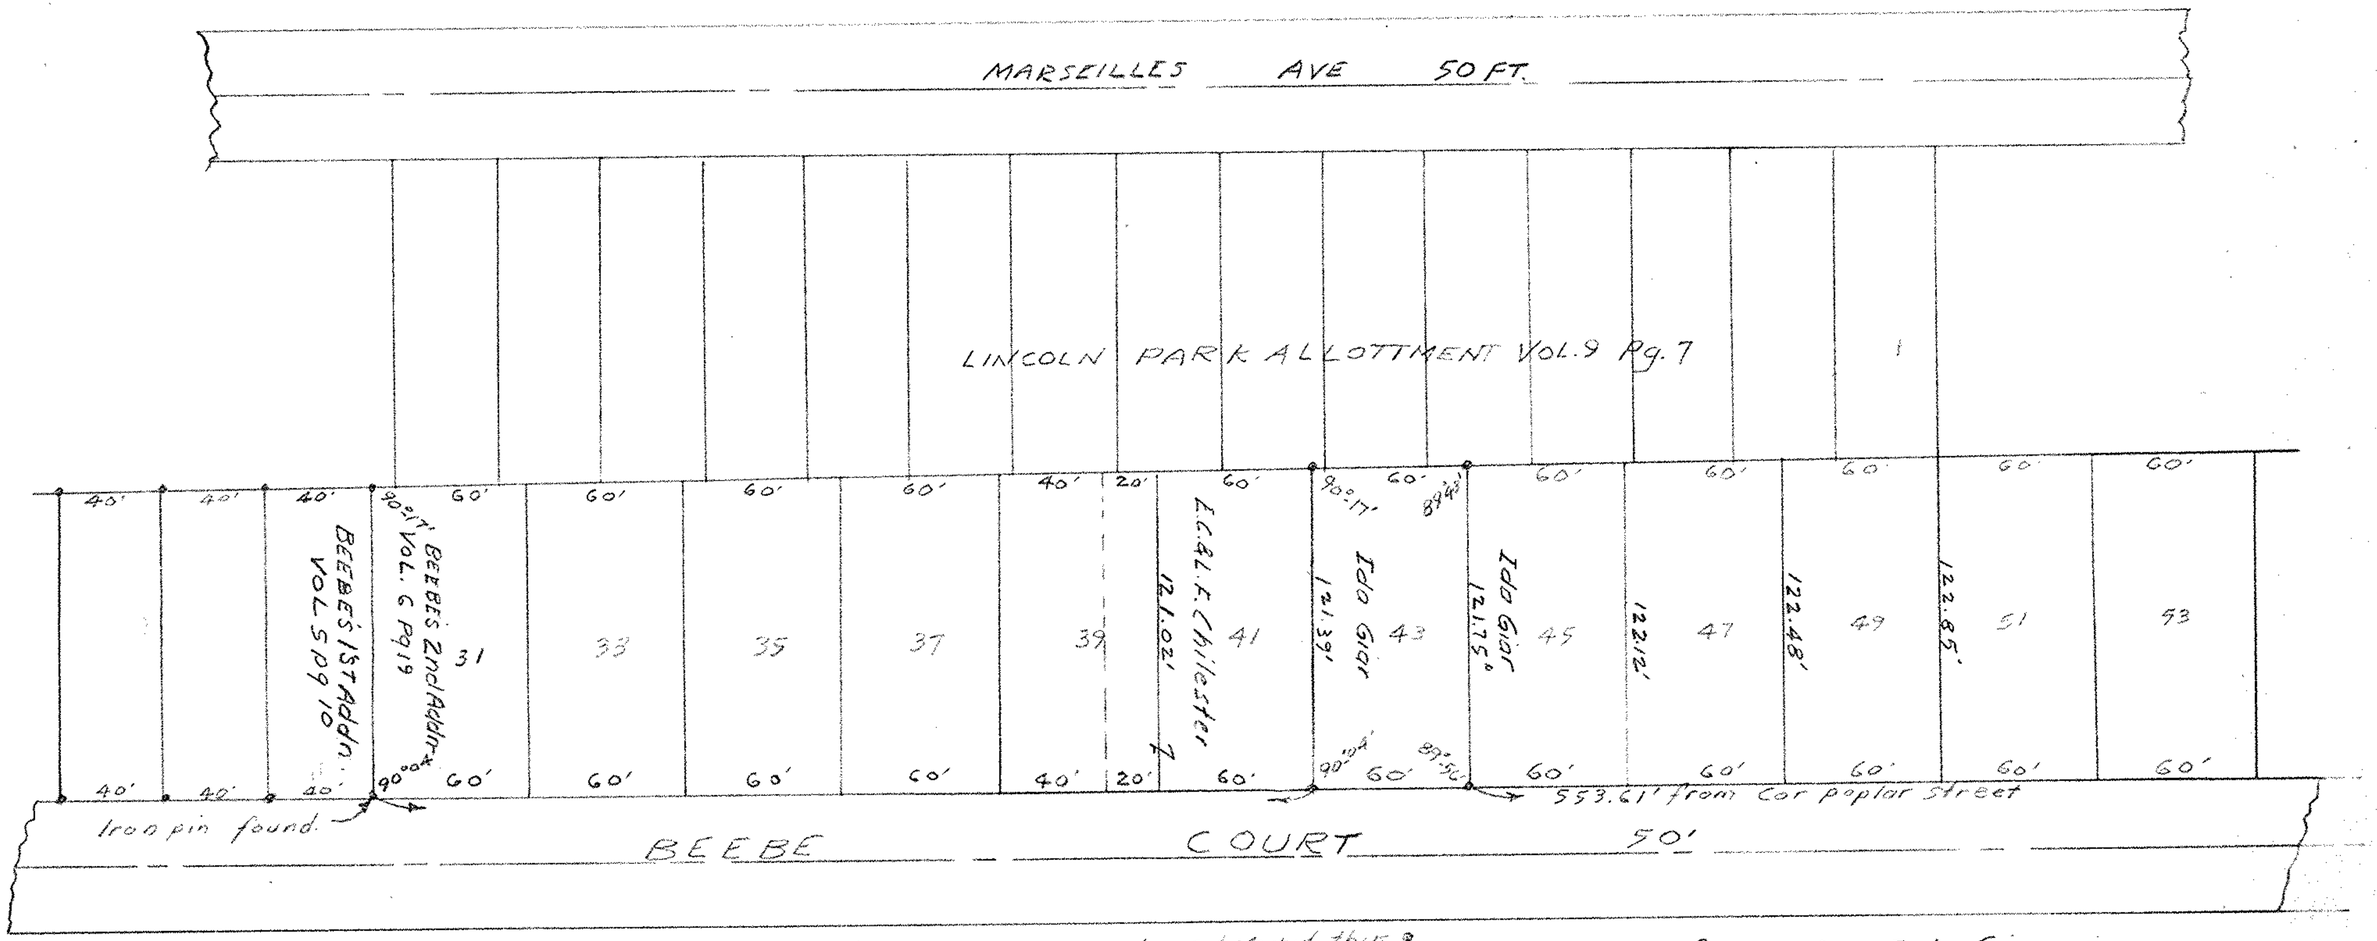

Note:- Iron pins found or set Marked thus •

Survey for Ida Giar
LOT 43 BEEBE'S 2ND ADDITION
CITY OF ELYRIA EAST OF RIVER.
LORAIN COUNTY OHIO
SCALE 1"=50' OCT 6-1947
C.E. Penfound Reg. Surveyor.

06-25-043 (3)