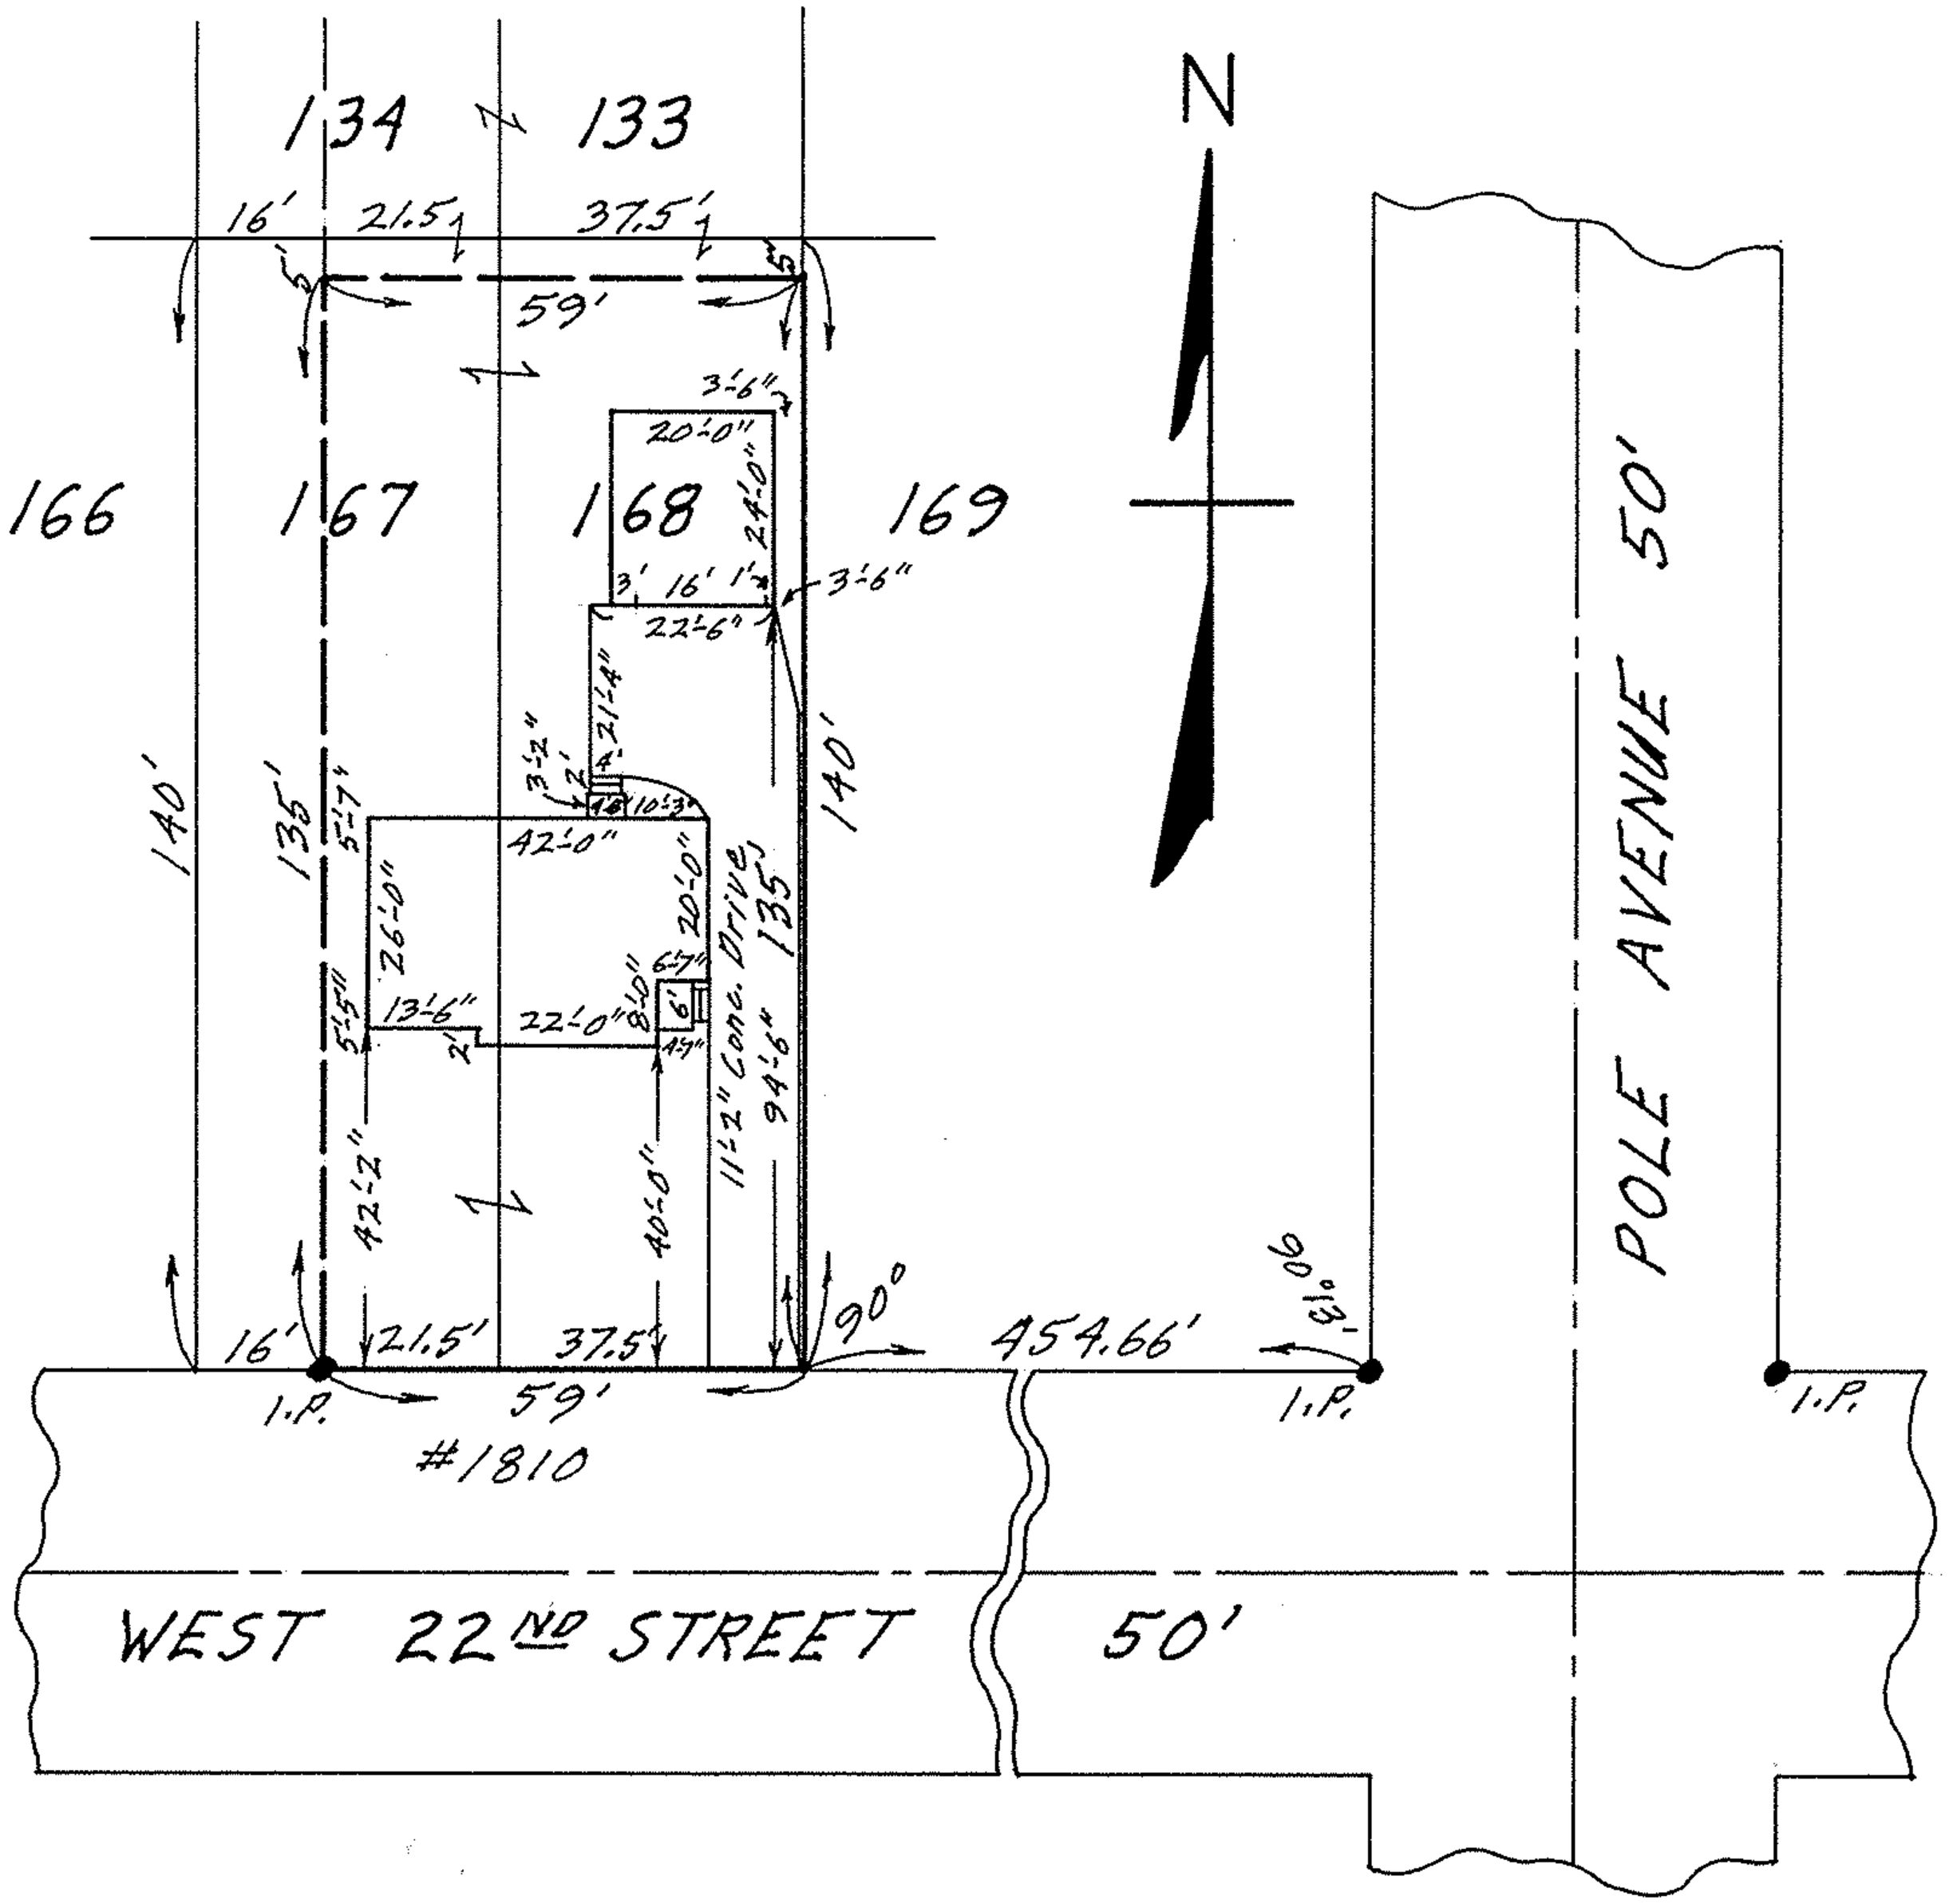


MAP OF PARTS OF SUB-LOTS NOS. 167 & 168
POLE & REEVES CITY ACRES ADD'N. VOL. 12 PG. 15
ORIG. LOT 24 - TRACT 2 - BLACK RIVER TWP.
LORAIN CITY - LORAIN COUNTY - OHIO
SCALE: 1" = 30' SEPT. 25-1967 11:30 A.M.
Gary E. Penfound REG. SURVEYOR

Donald & Maggie D. Blakely

02-02-024