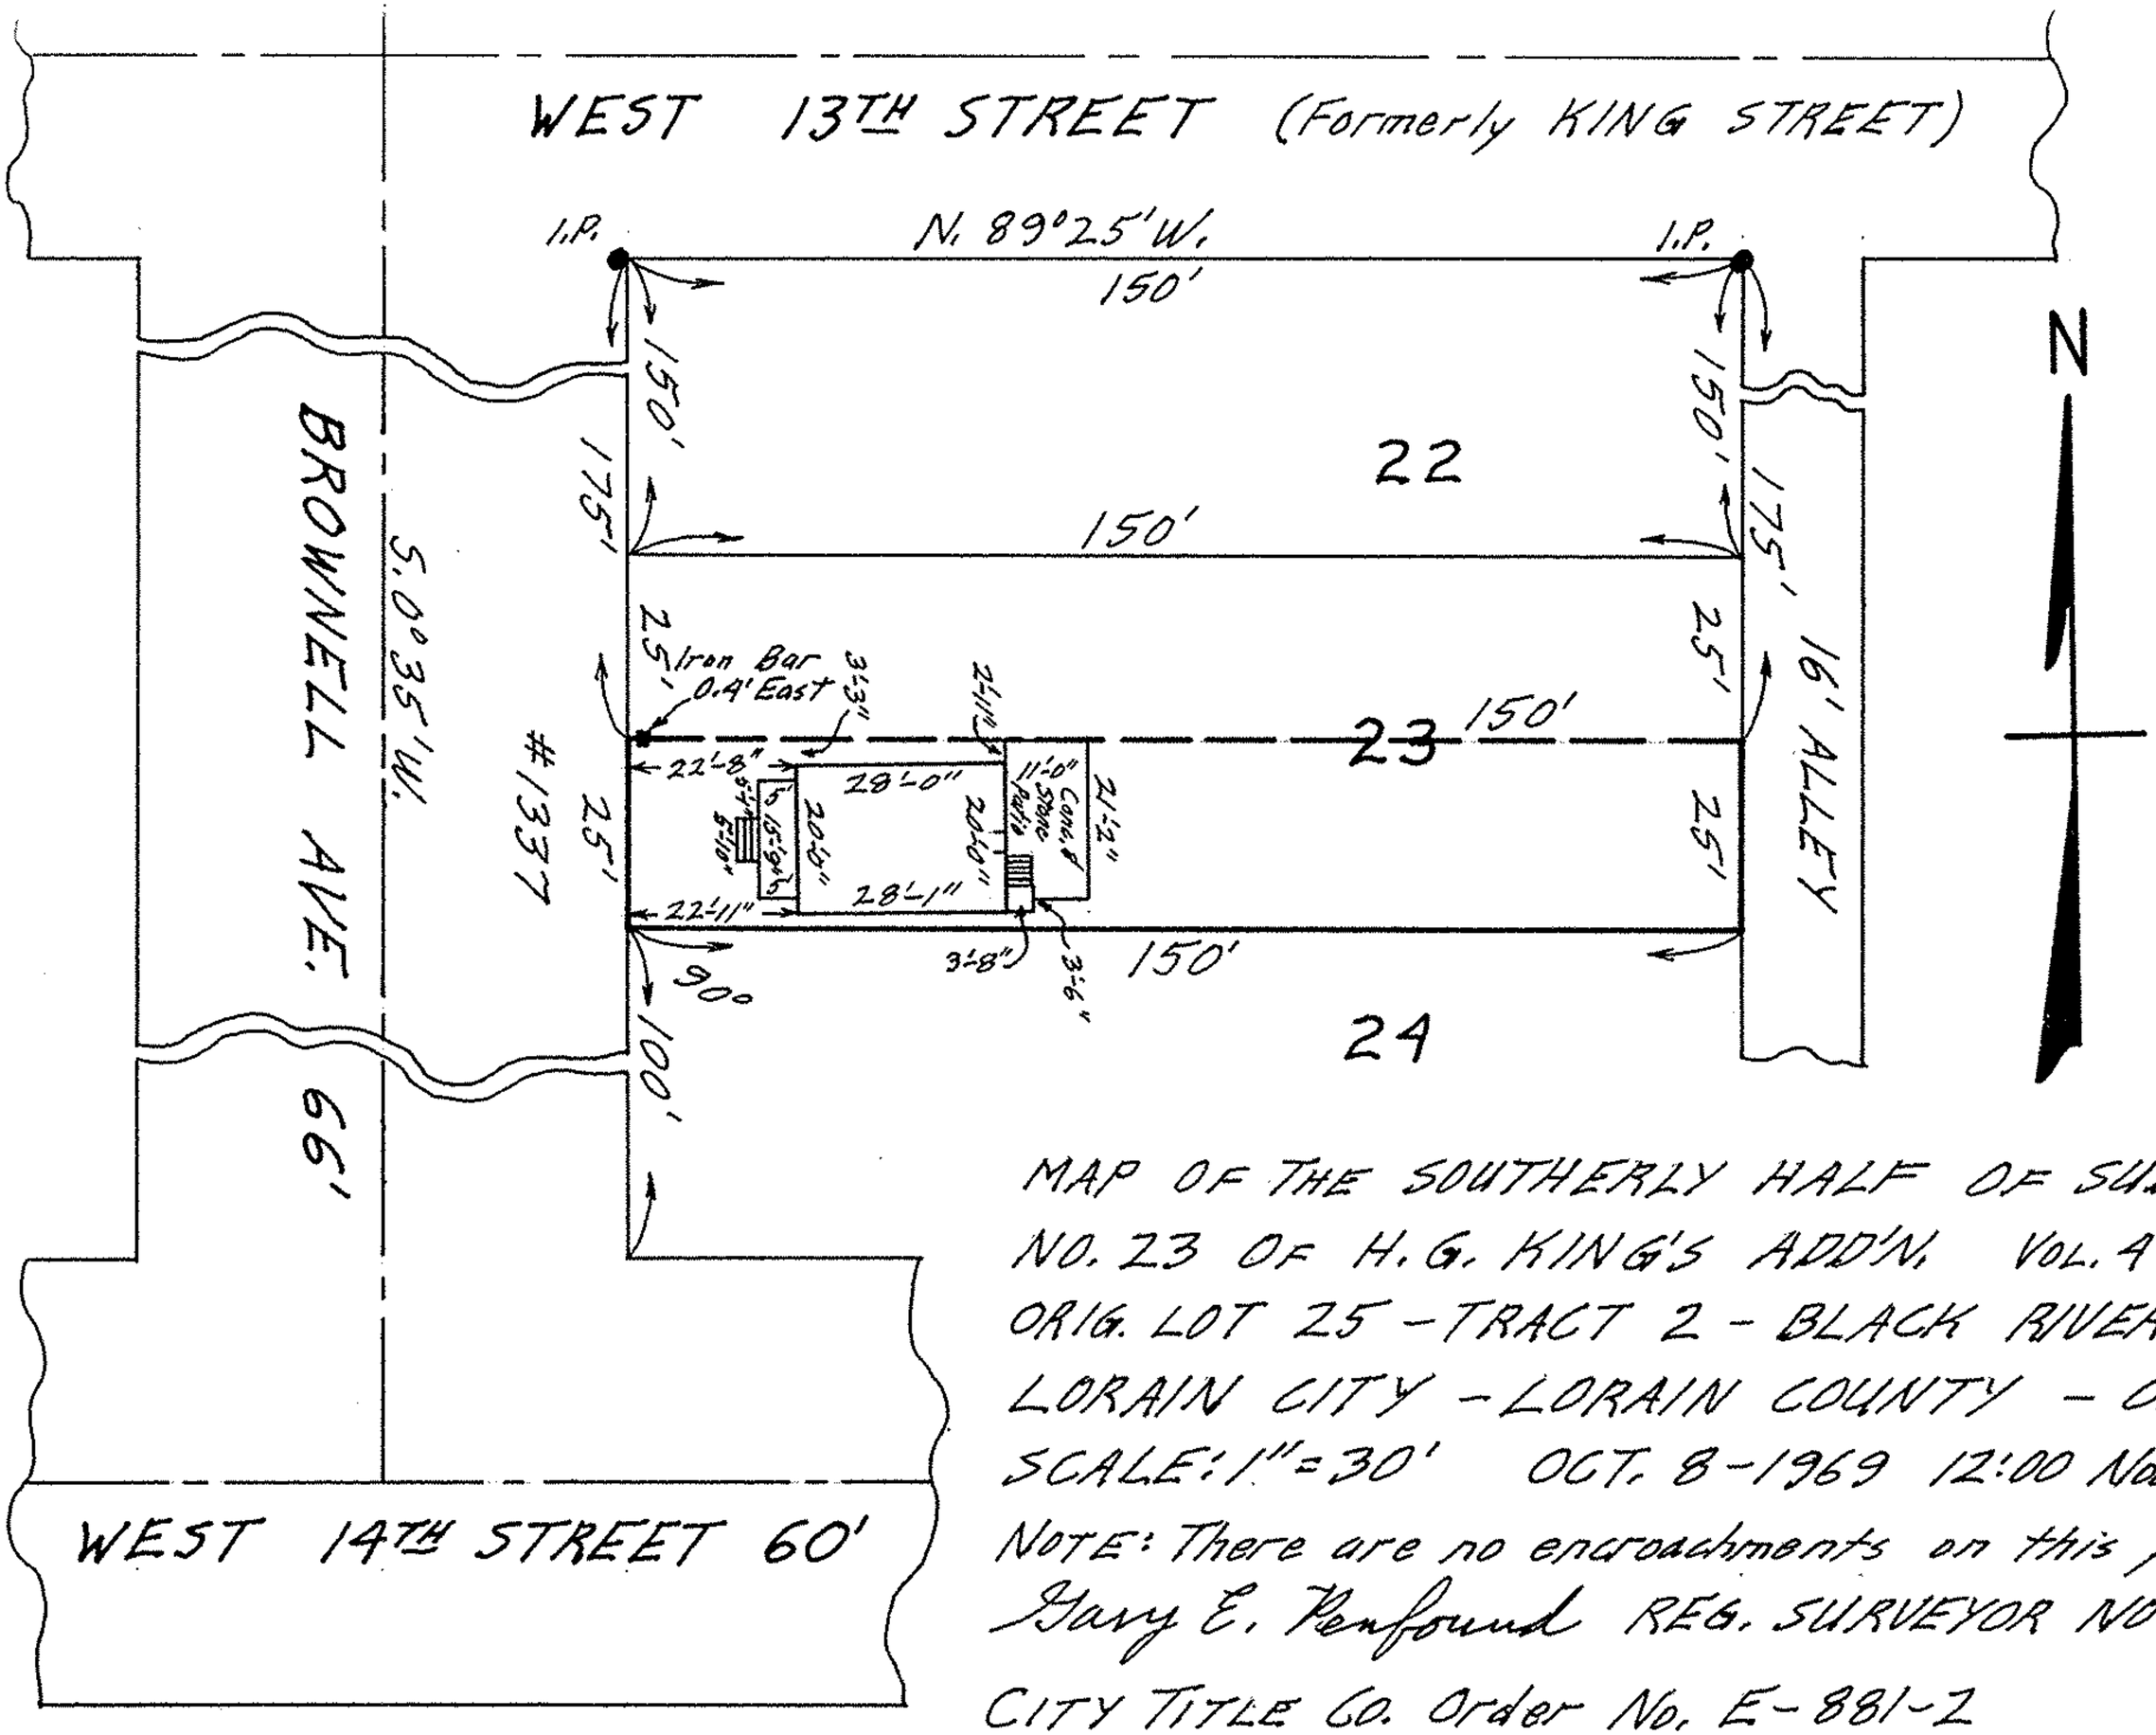

MAP OF THE SOUTHERLY HALF OF SUB-LOT NO. 23 OF H.G. KING'S ADD'N. VOL. 4 PG. 1
ORIG. LOT 25 - TRACT 2 - BLACK RIVER TWP.
LORAIN CITY - LORAIN COUNTY - OHIO
SCALE: 1" = 30' OCT. 8 - 1969 12:00 Noon

NOTE: There are no encroachments on this property.

Gary E. Penfound REG. SURVEYOR NO. 4457

CITY TITLE CO. Order No. E-881-2

Prestige Realty, Inc. to Sam Jones, Jr. & Dorothy J. Jones