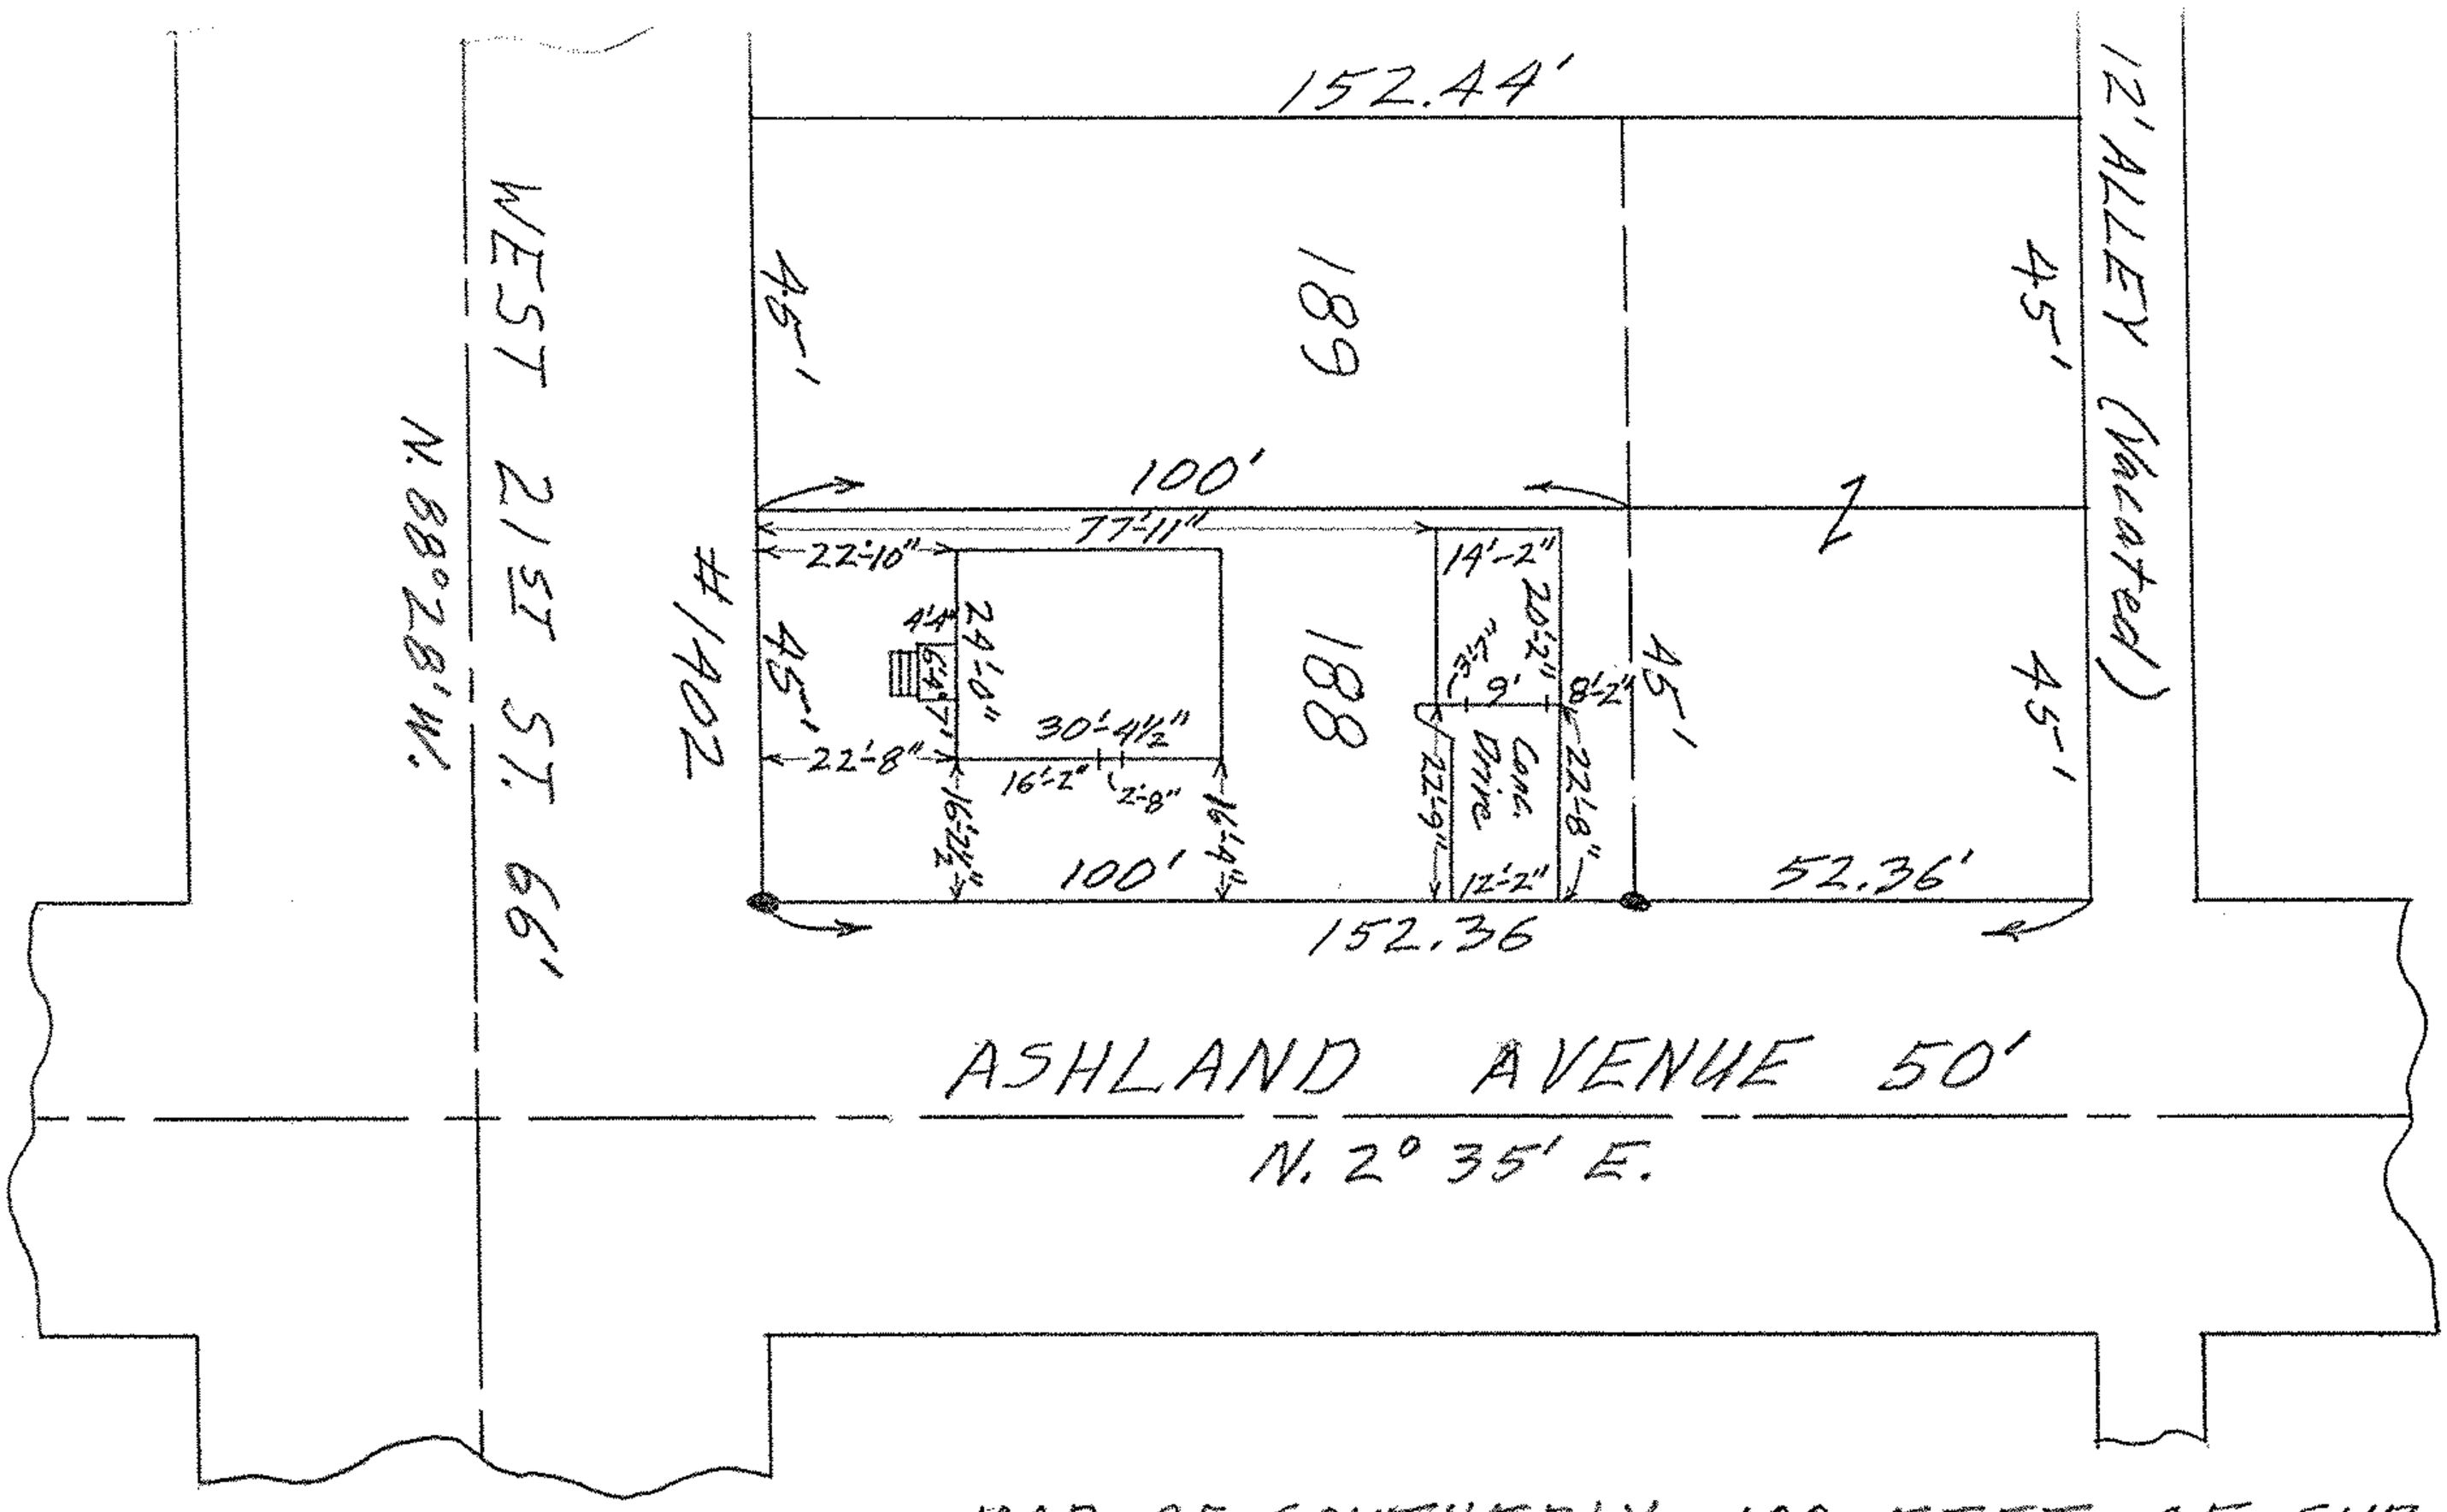

MAP OF SOUTHERLY 100 FEET OF SUB-LOT NO. 188 OF OAKLAND ADD'N. VOL. 4 PG. 17
ORIG. LOT 25 - TRACT 2 - BLACK RIVER TWP.
LORAIN CITY - LORAIN COUNTY - OHIO
SCALE: 1"=30' JULY 1-1963 3:15 P.M.
Gary E. Penfound REG. SURVEYOR

James W. Mastin

W W 02-02-025