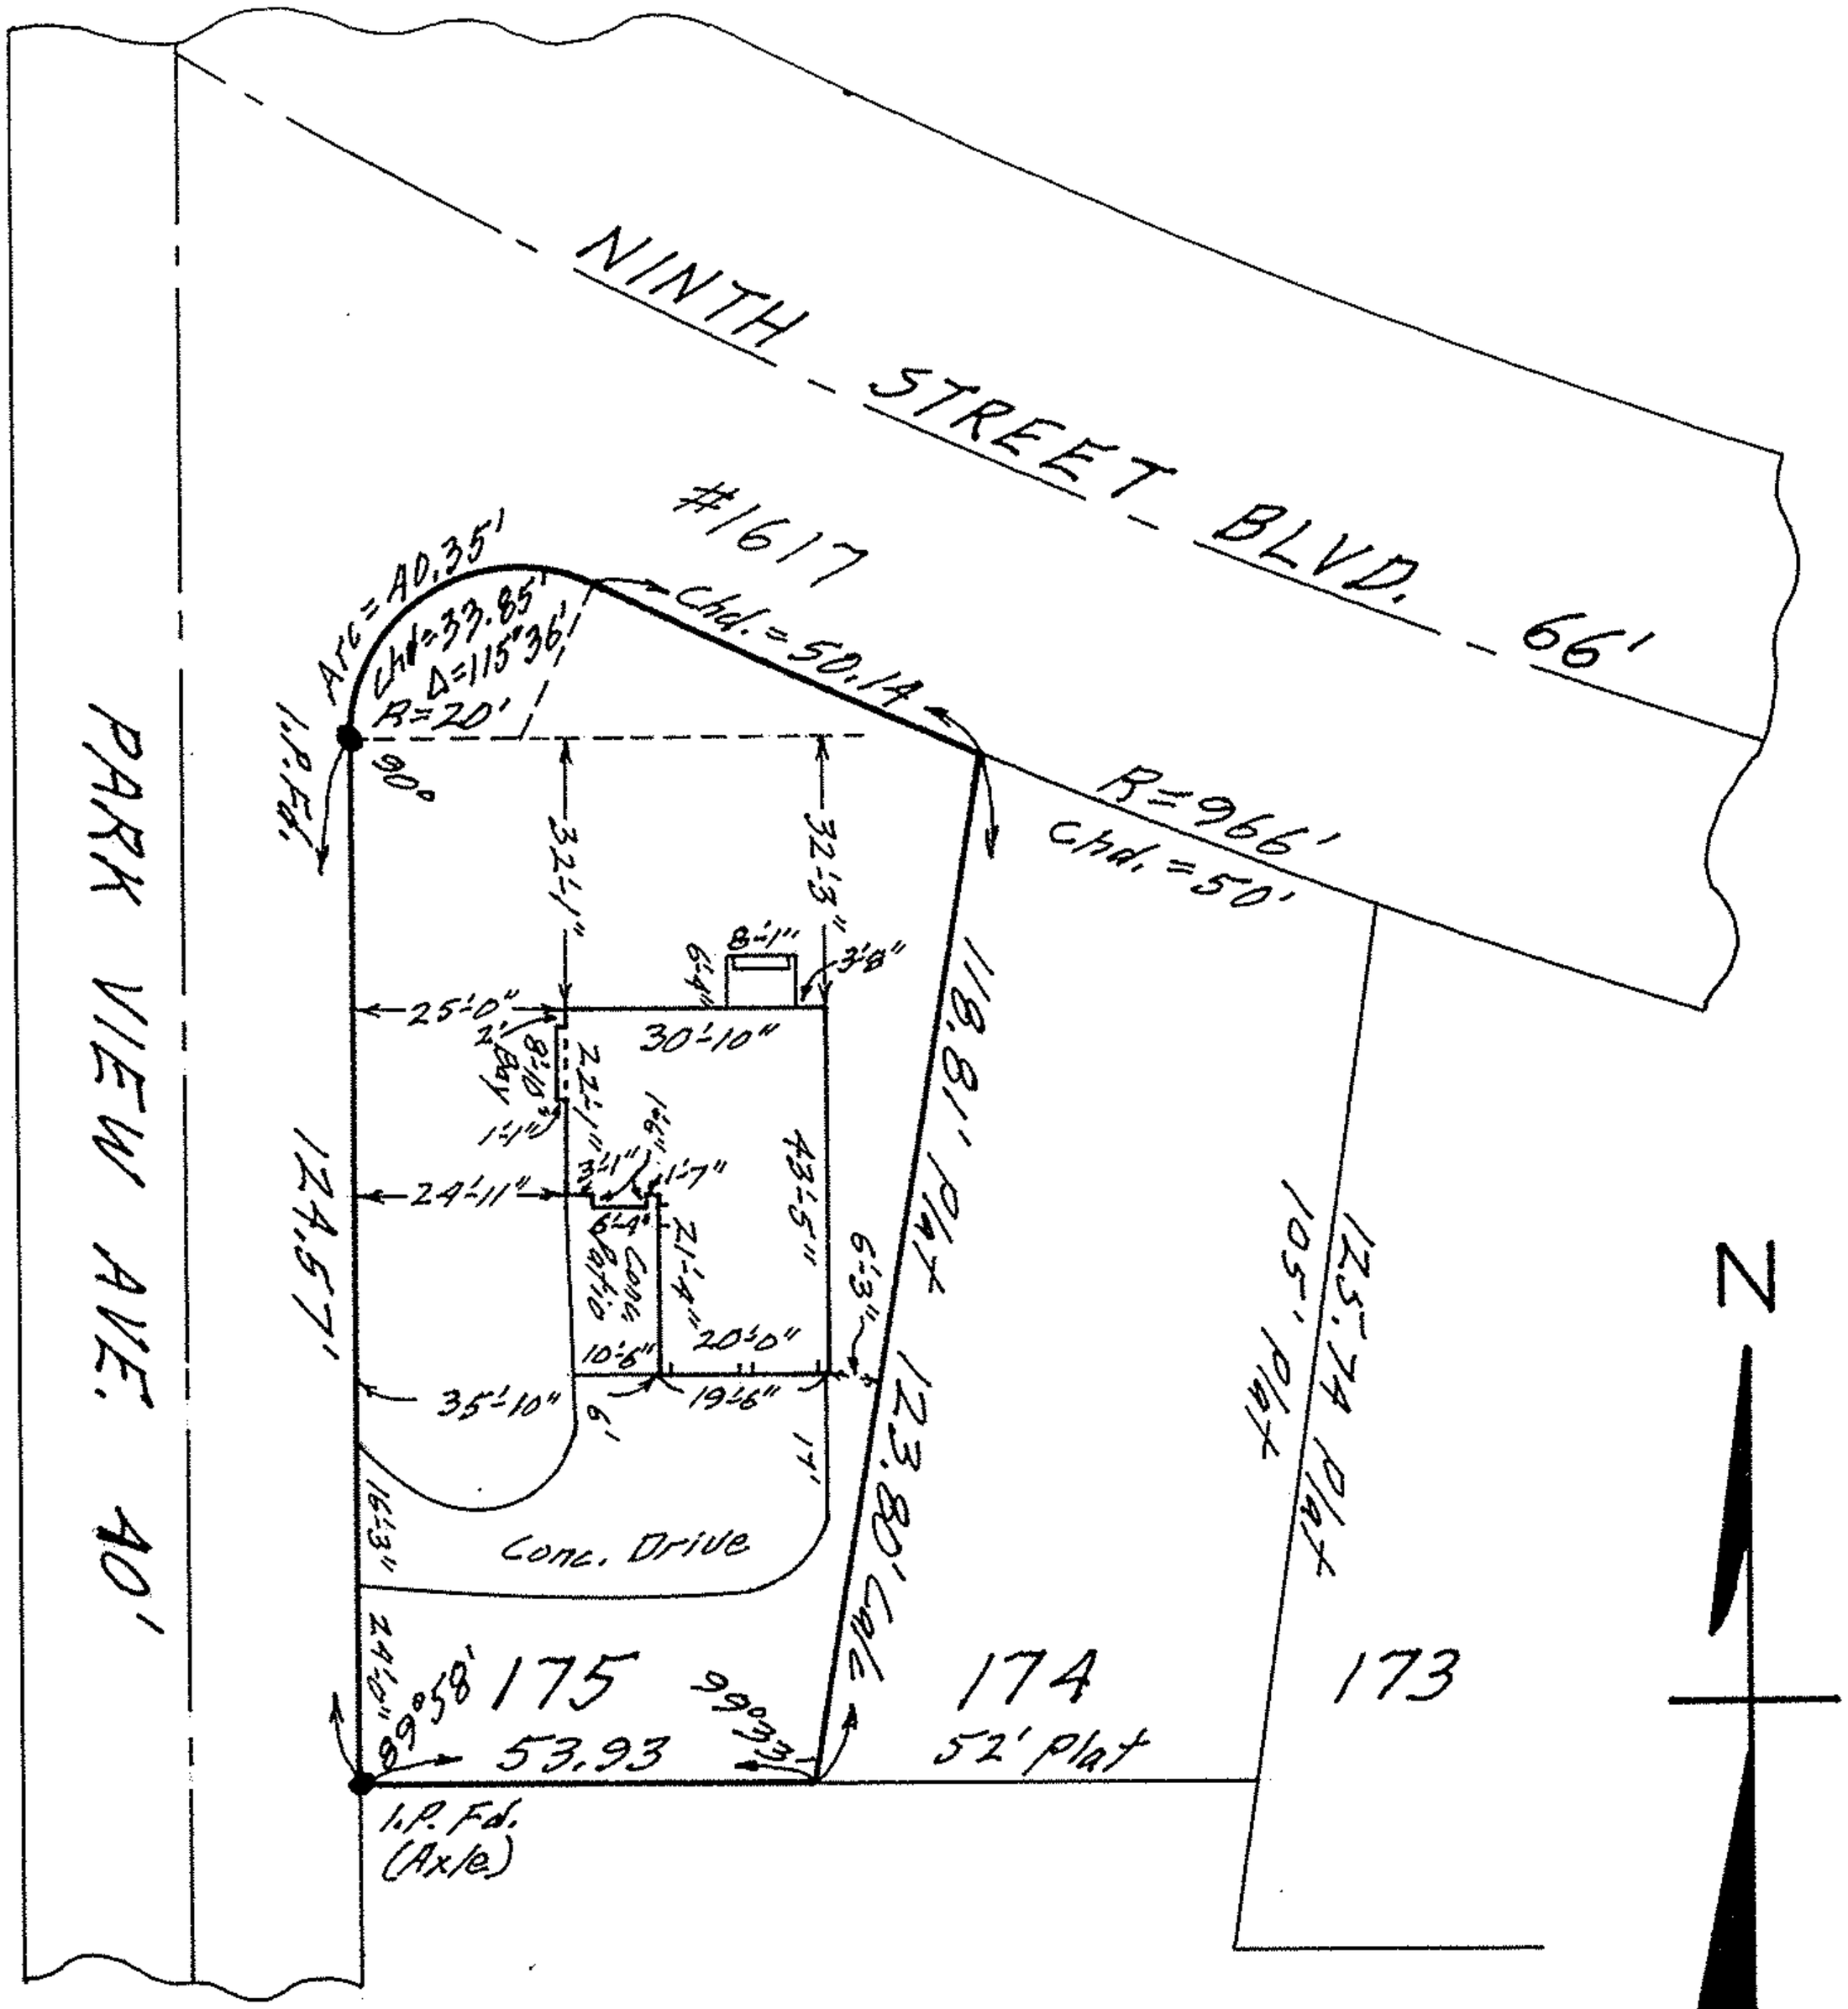

MAP OF SUB-LOT NO. 175

LAKE VIEW PARK REALTY CO. ALL'T. - VOL. 9 PG. 6

ORIG. LOT 27 - TRACT 2 - BLACK RIVER TWP.

LORAIN CITY LORAIN COUNTY OHIO

SCALE: 1"=30' OCT. 7 - 1968 11:15 A.M.

Gary E. Penfound REG. SURVEYOR

Daniel A. Cook & Mary Jo Cook

02-02-027