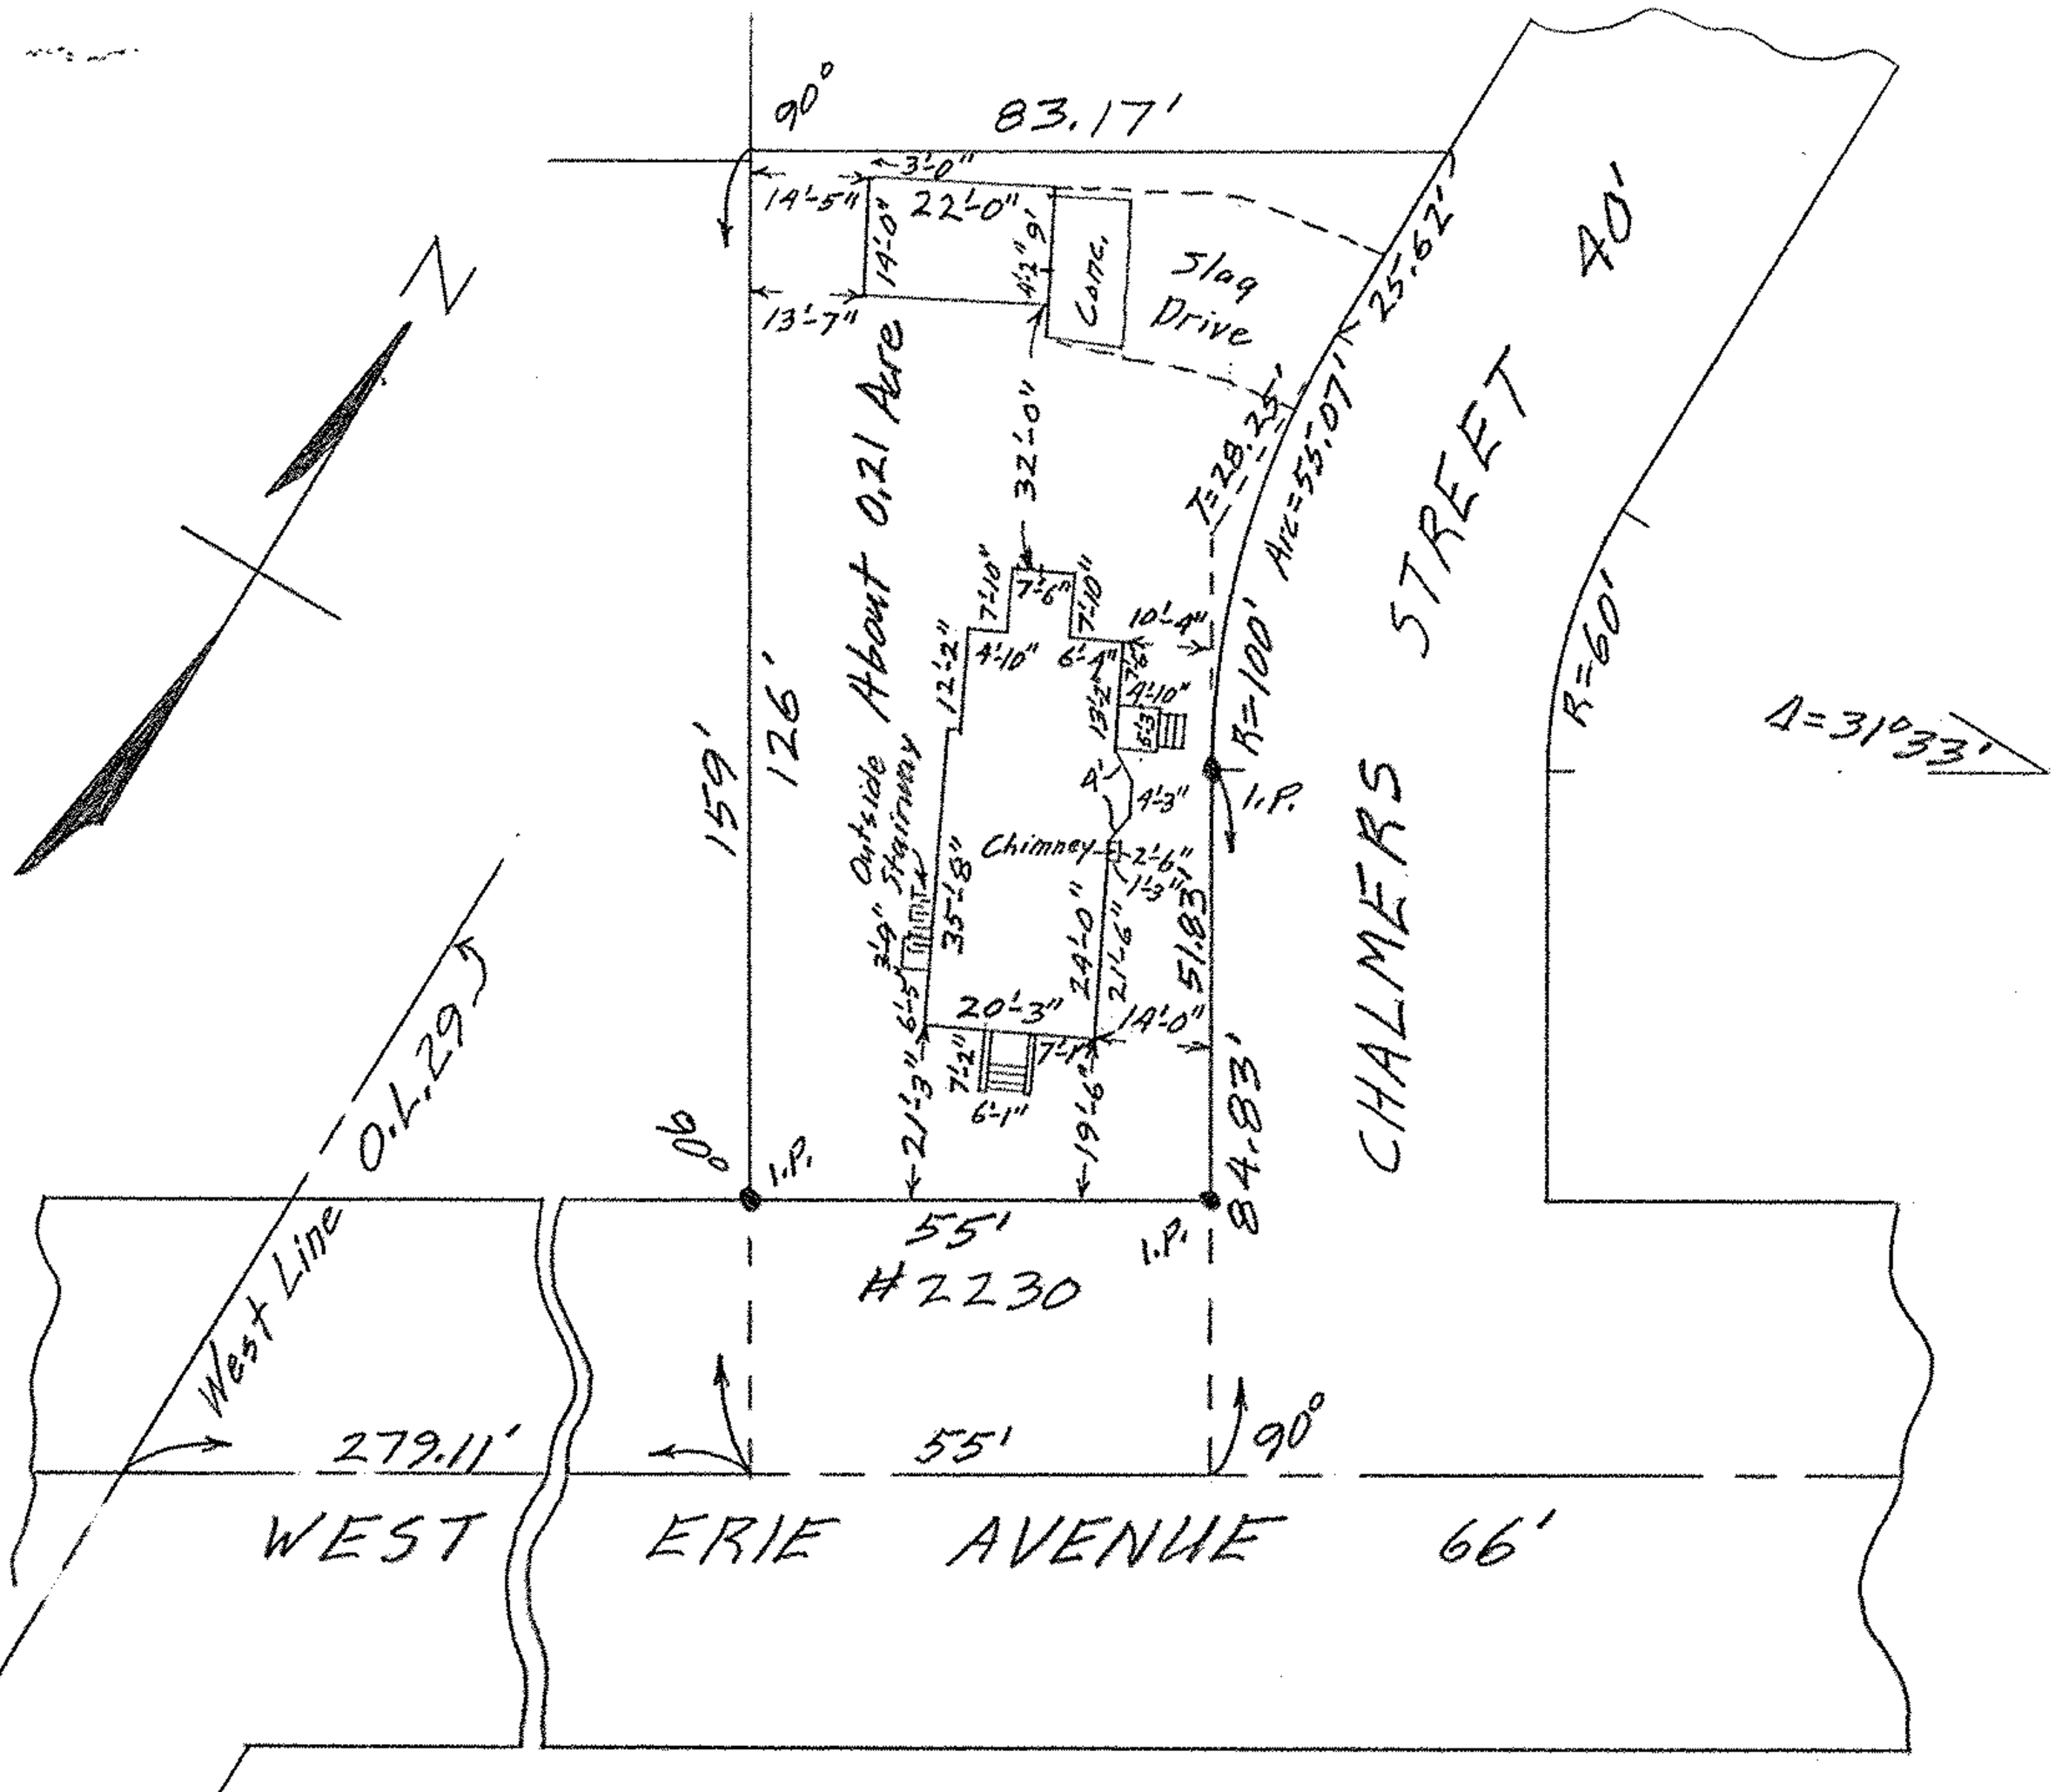

MAP OF PART OF ORIG. LOT 29 - TRACT 2
BLACK RIVER TWP. LORAIN CITY
LORAIN COUNTY OHIO
SCALE: 1" = 30' NOV. 6-1964 11:00 A.M.
Gary E. Penfound REG. SURVEYOR

Jessie L. & Ollie B. Scates

PC

02-02-029