MAP OF SUB-LOT NO. 78
EASTHAVEN SUB'N. VOL. 9 PG. 4
ORIG. LOT 46 SHEFFIELD TWP.
LORAIN CITY - LORAIN COUNTY - OHIO
SCALE: 1" = 30' NOV. 2 - 1969 5:45 P.M.
NOTE! There are no encroachments on this property.
Gary E. Penfound REG. SURVEYOR NO. 4457

CITY TITLE CO.
Order No. E-921-2
Ira & Mary Ash
to Billy J. & Judith D.
Miller

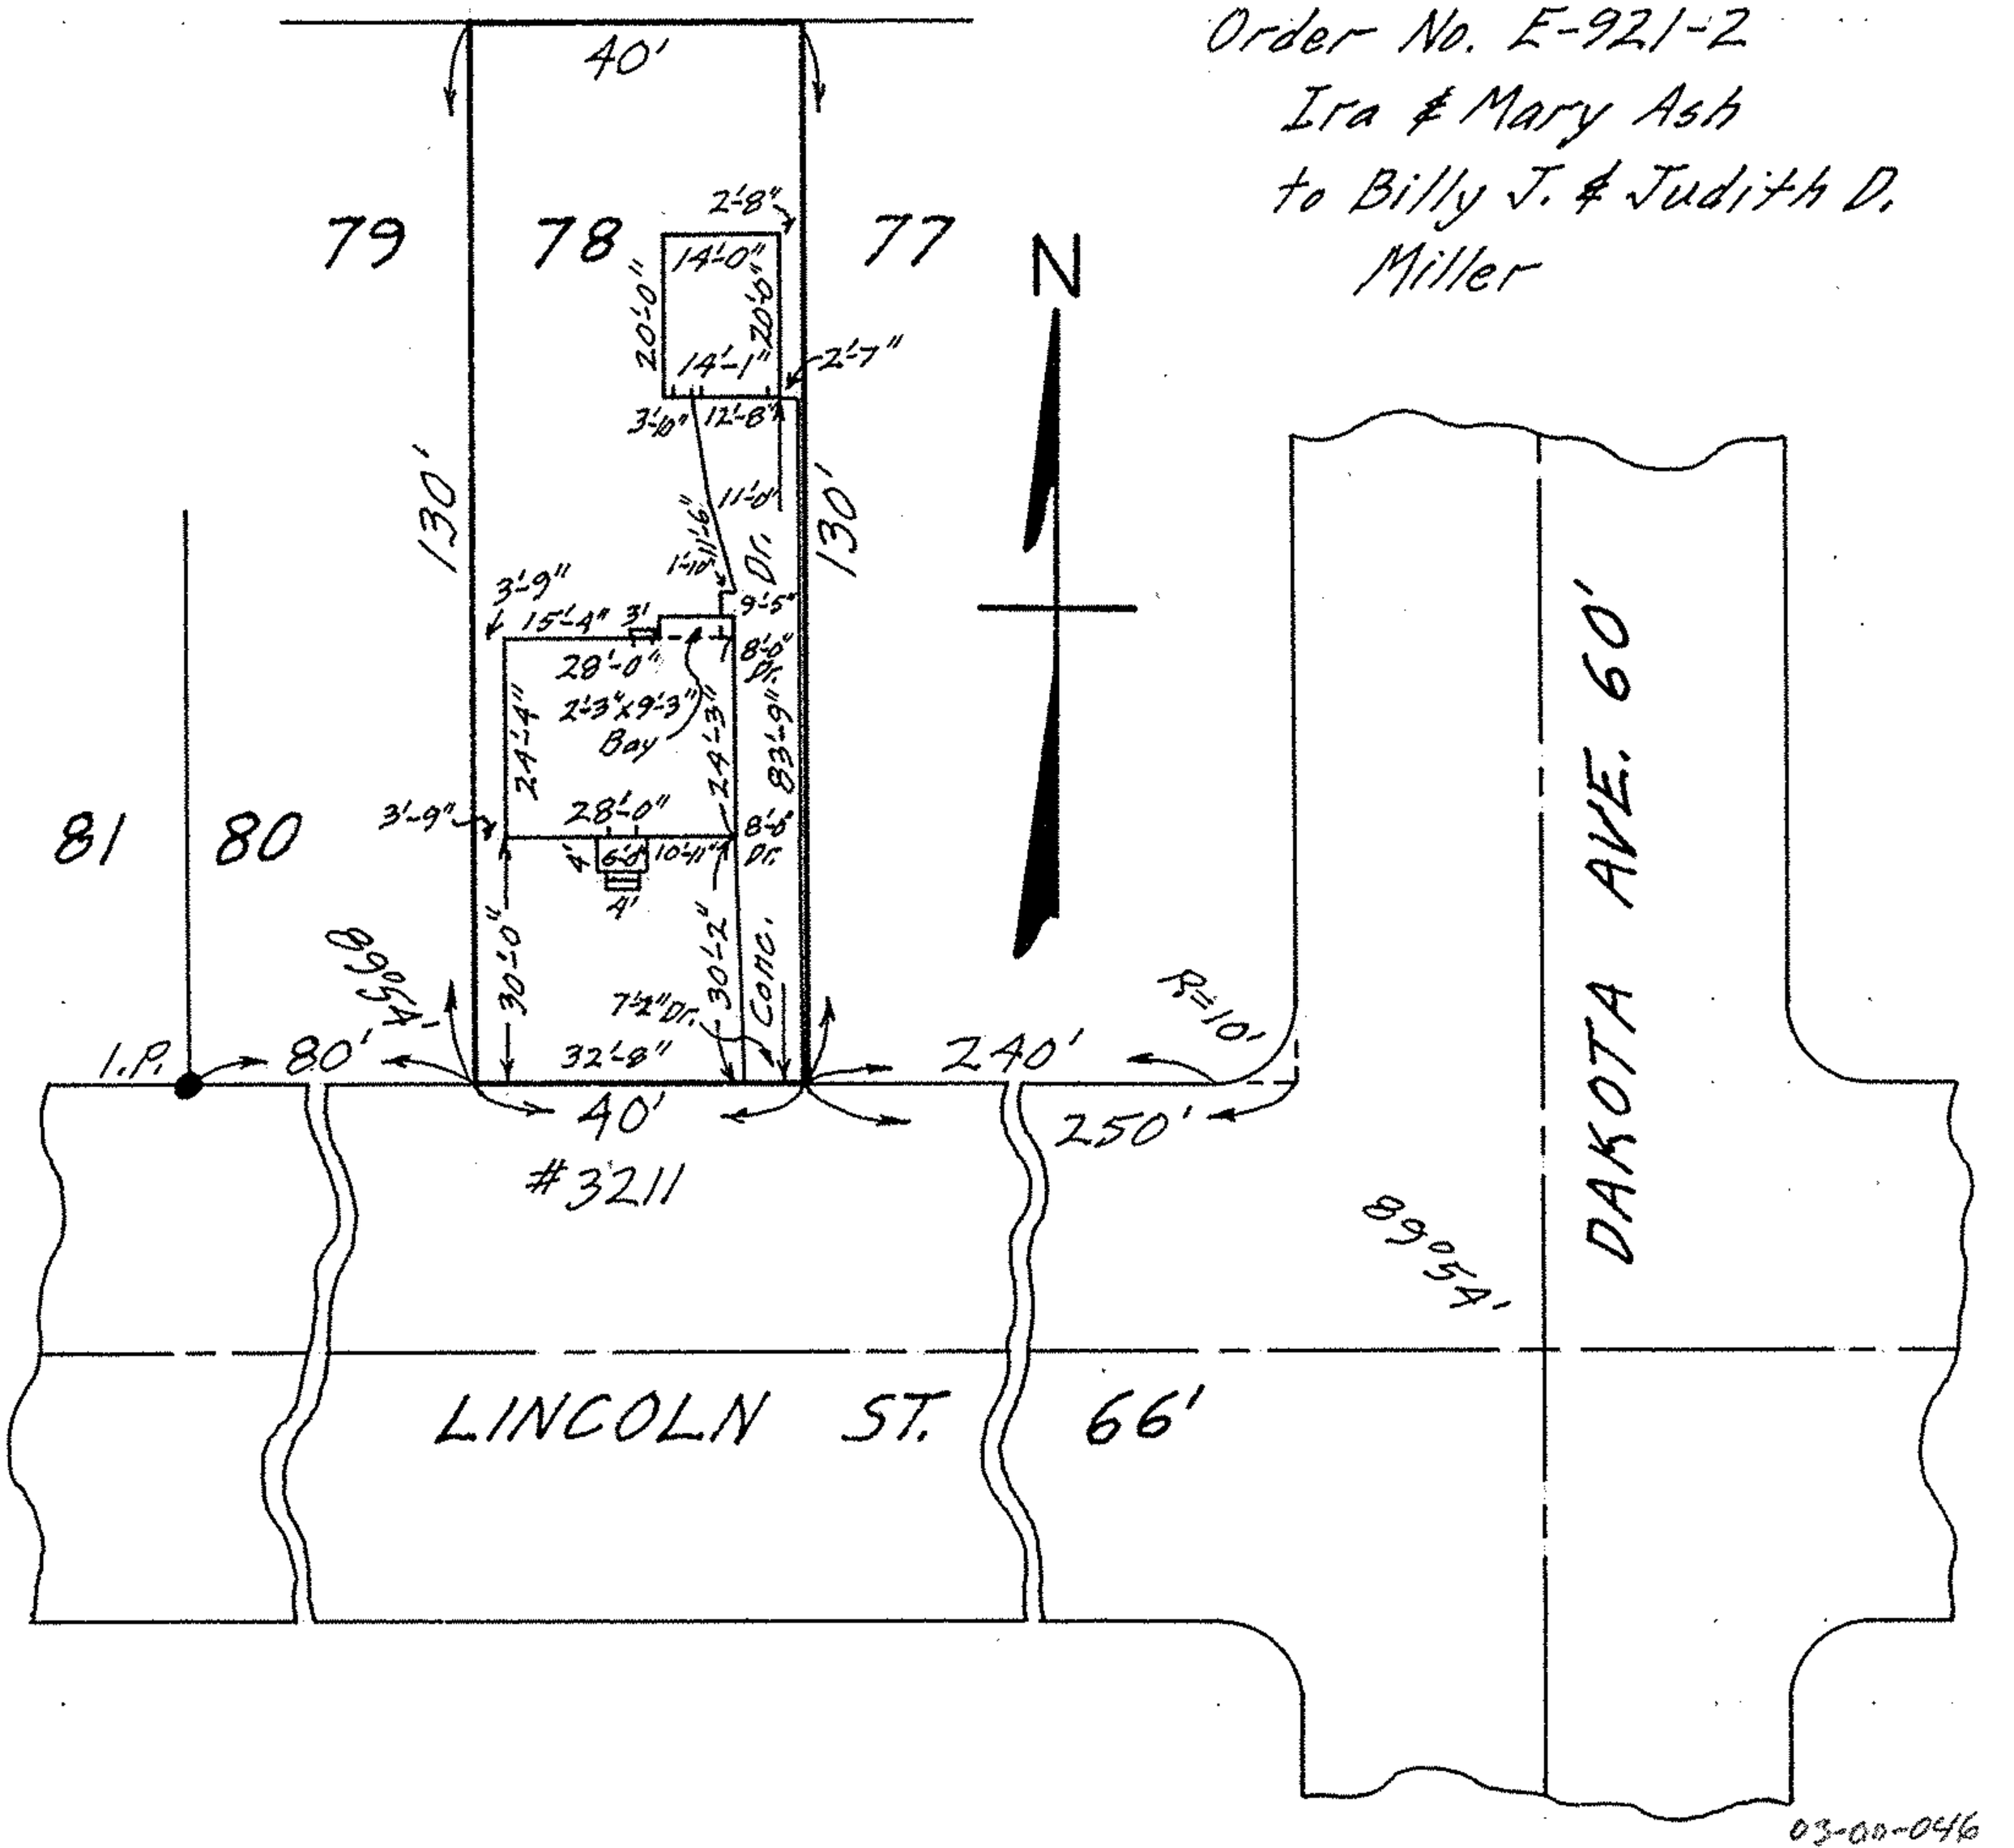

03-00-046