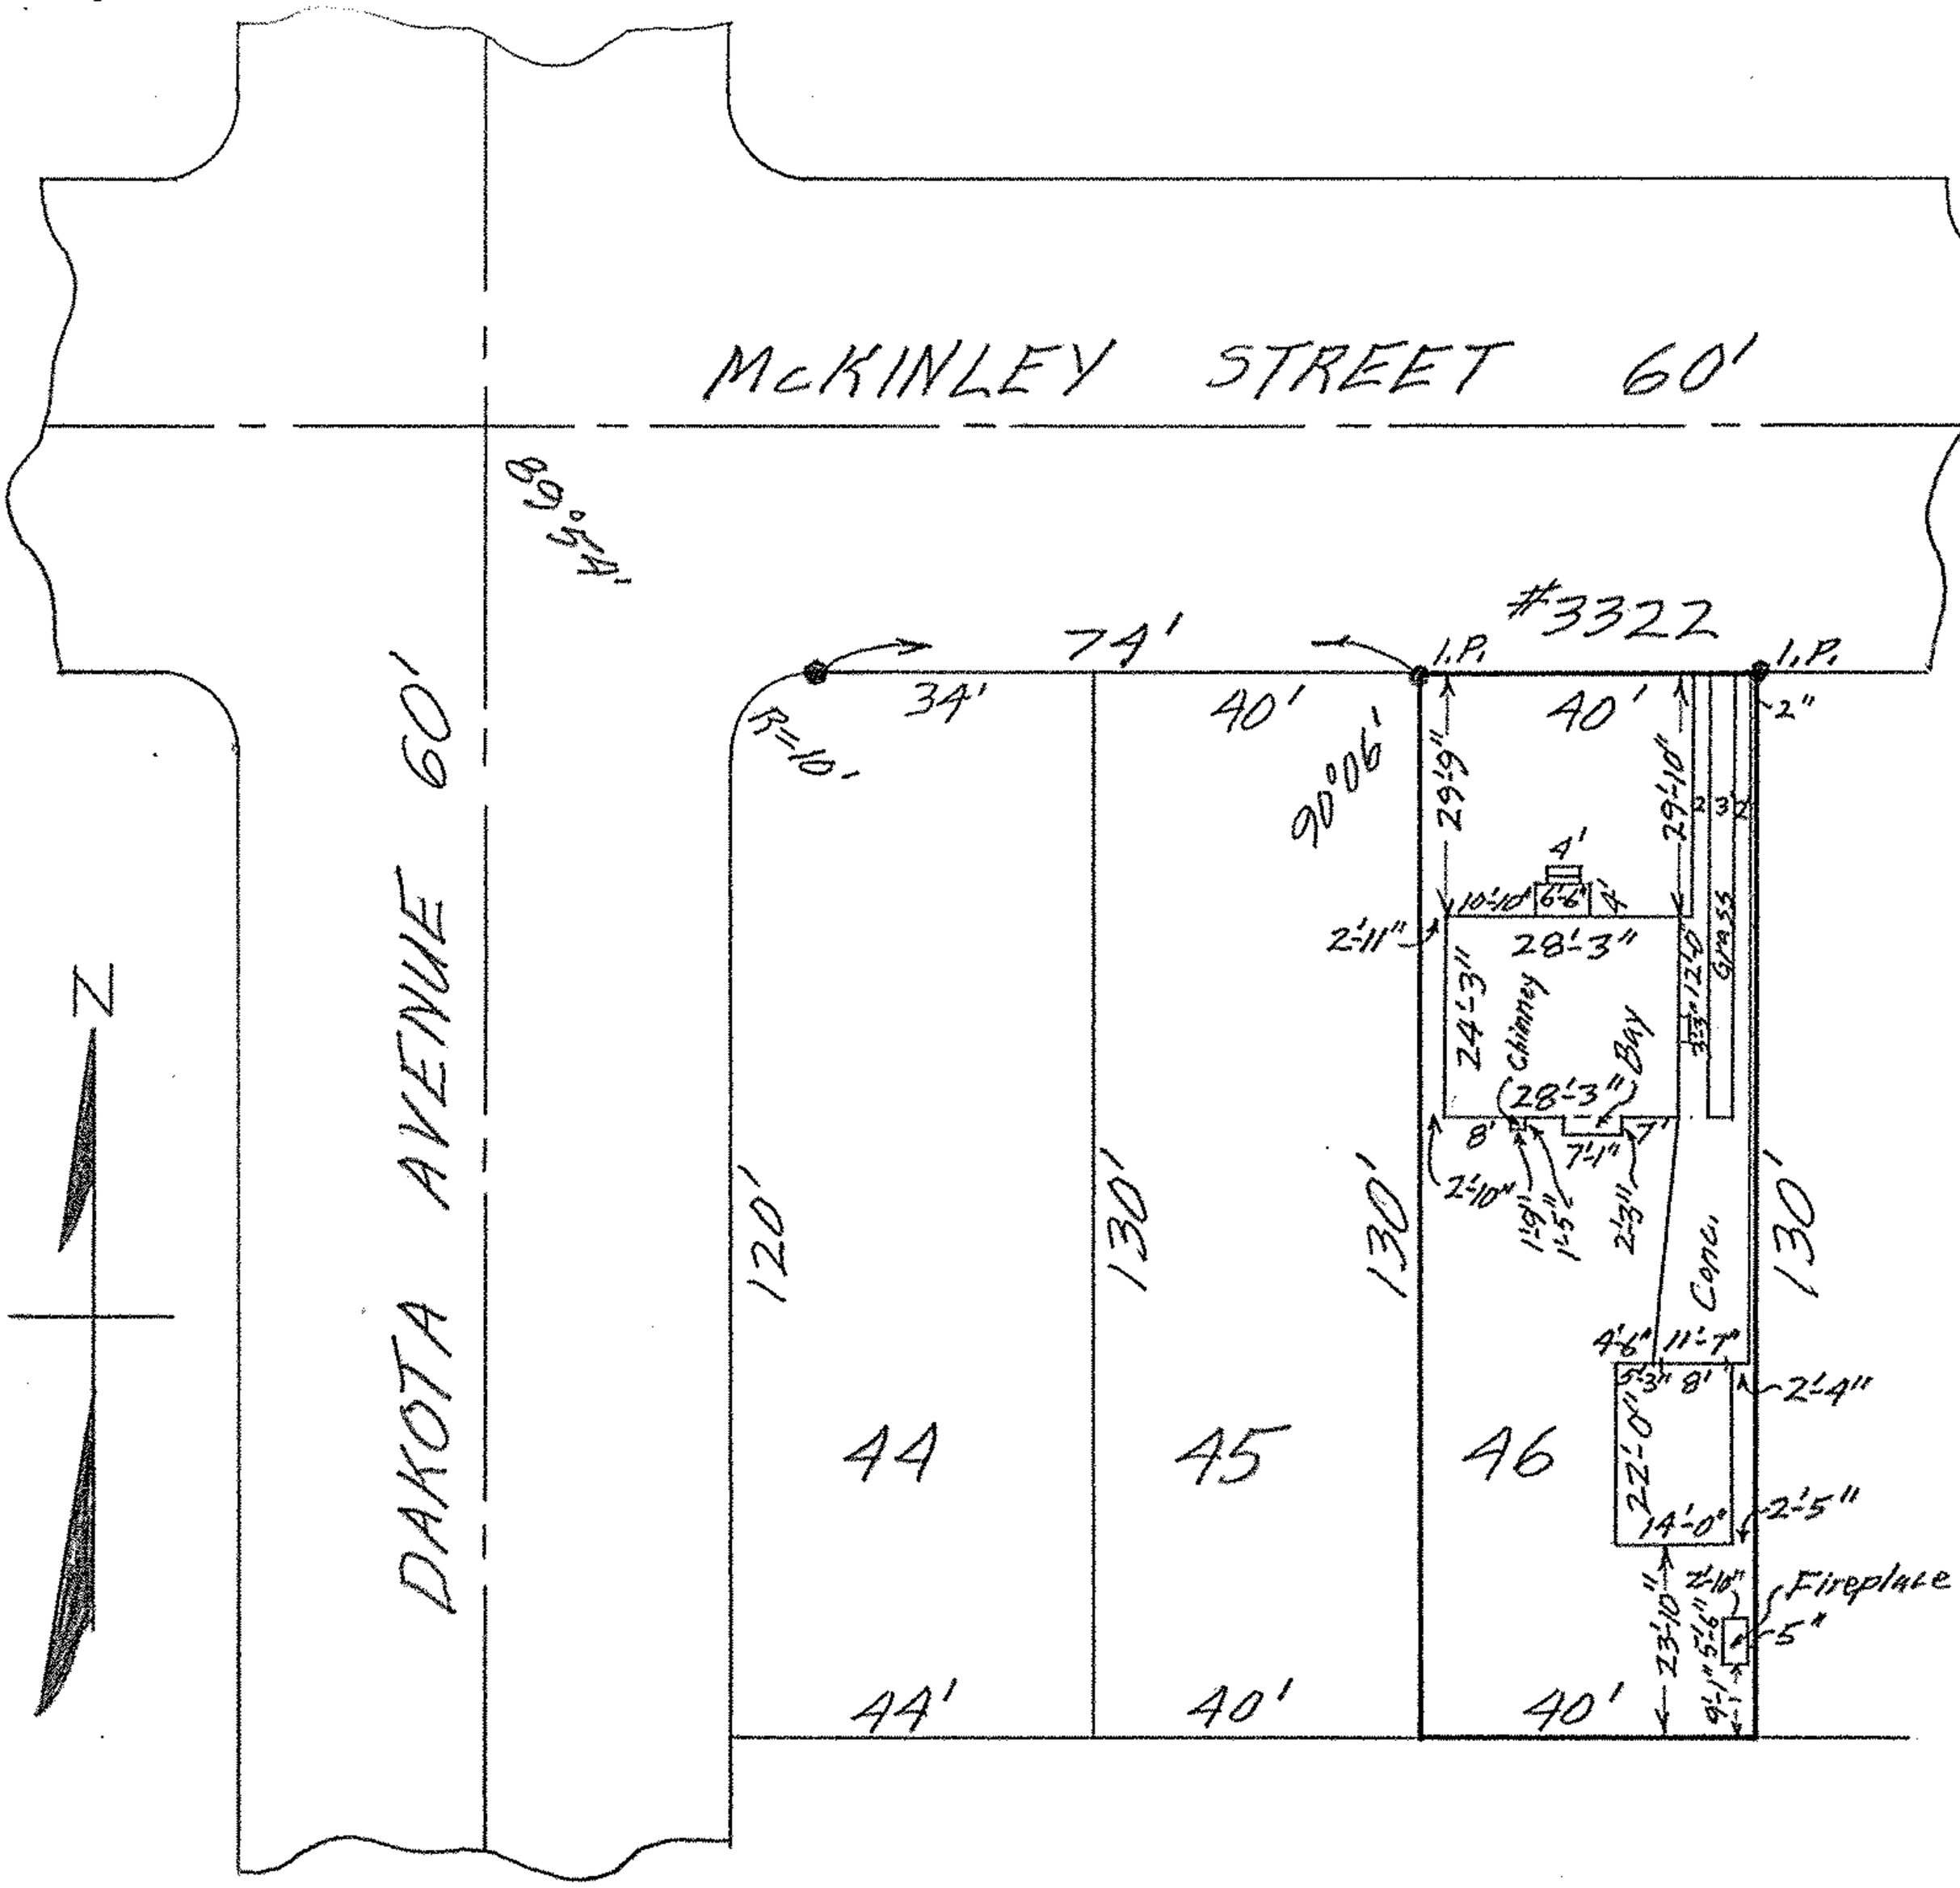

MAP OF SUB-LOT NO. 46
EASTHAVEN SUB'N. VOL. 9 PG. 4 PLATS
ORIG. LOT NO. 46 SHEFFIELD TWP.
LORAIN CITY - LORAIN COUNTY - OHIO
SCALE: 1" = 30' AUG. 5-1965 11:00 A.M.
Gary E. Penfound REG. SURVEYOR

OHIO BAR TITLE INSURANCE CO.
Milton Friedman, Agent
Order No. 1223 Daisy Lazevich