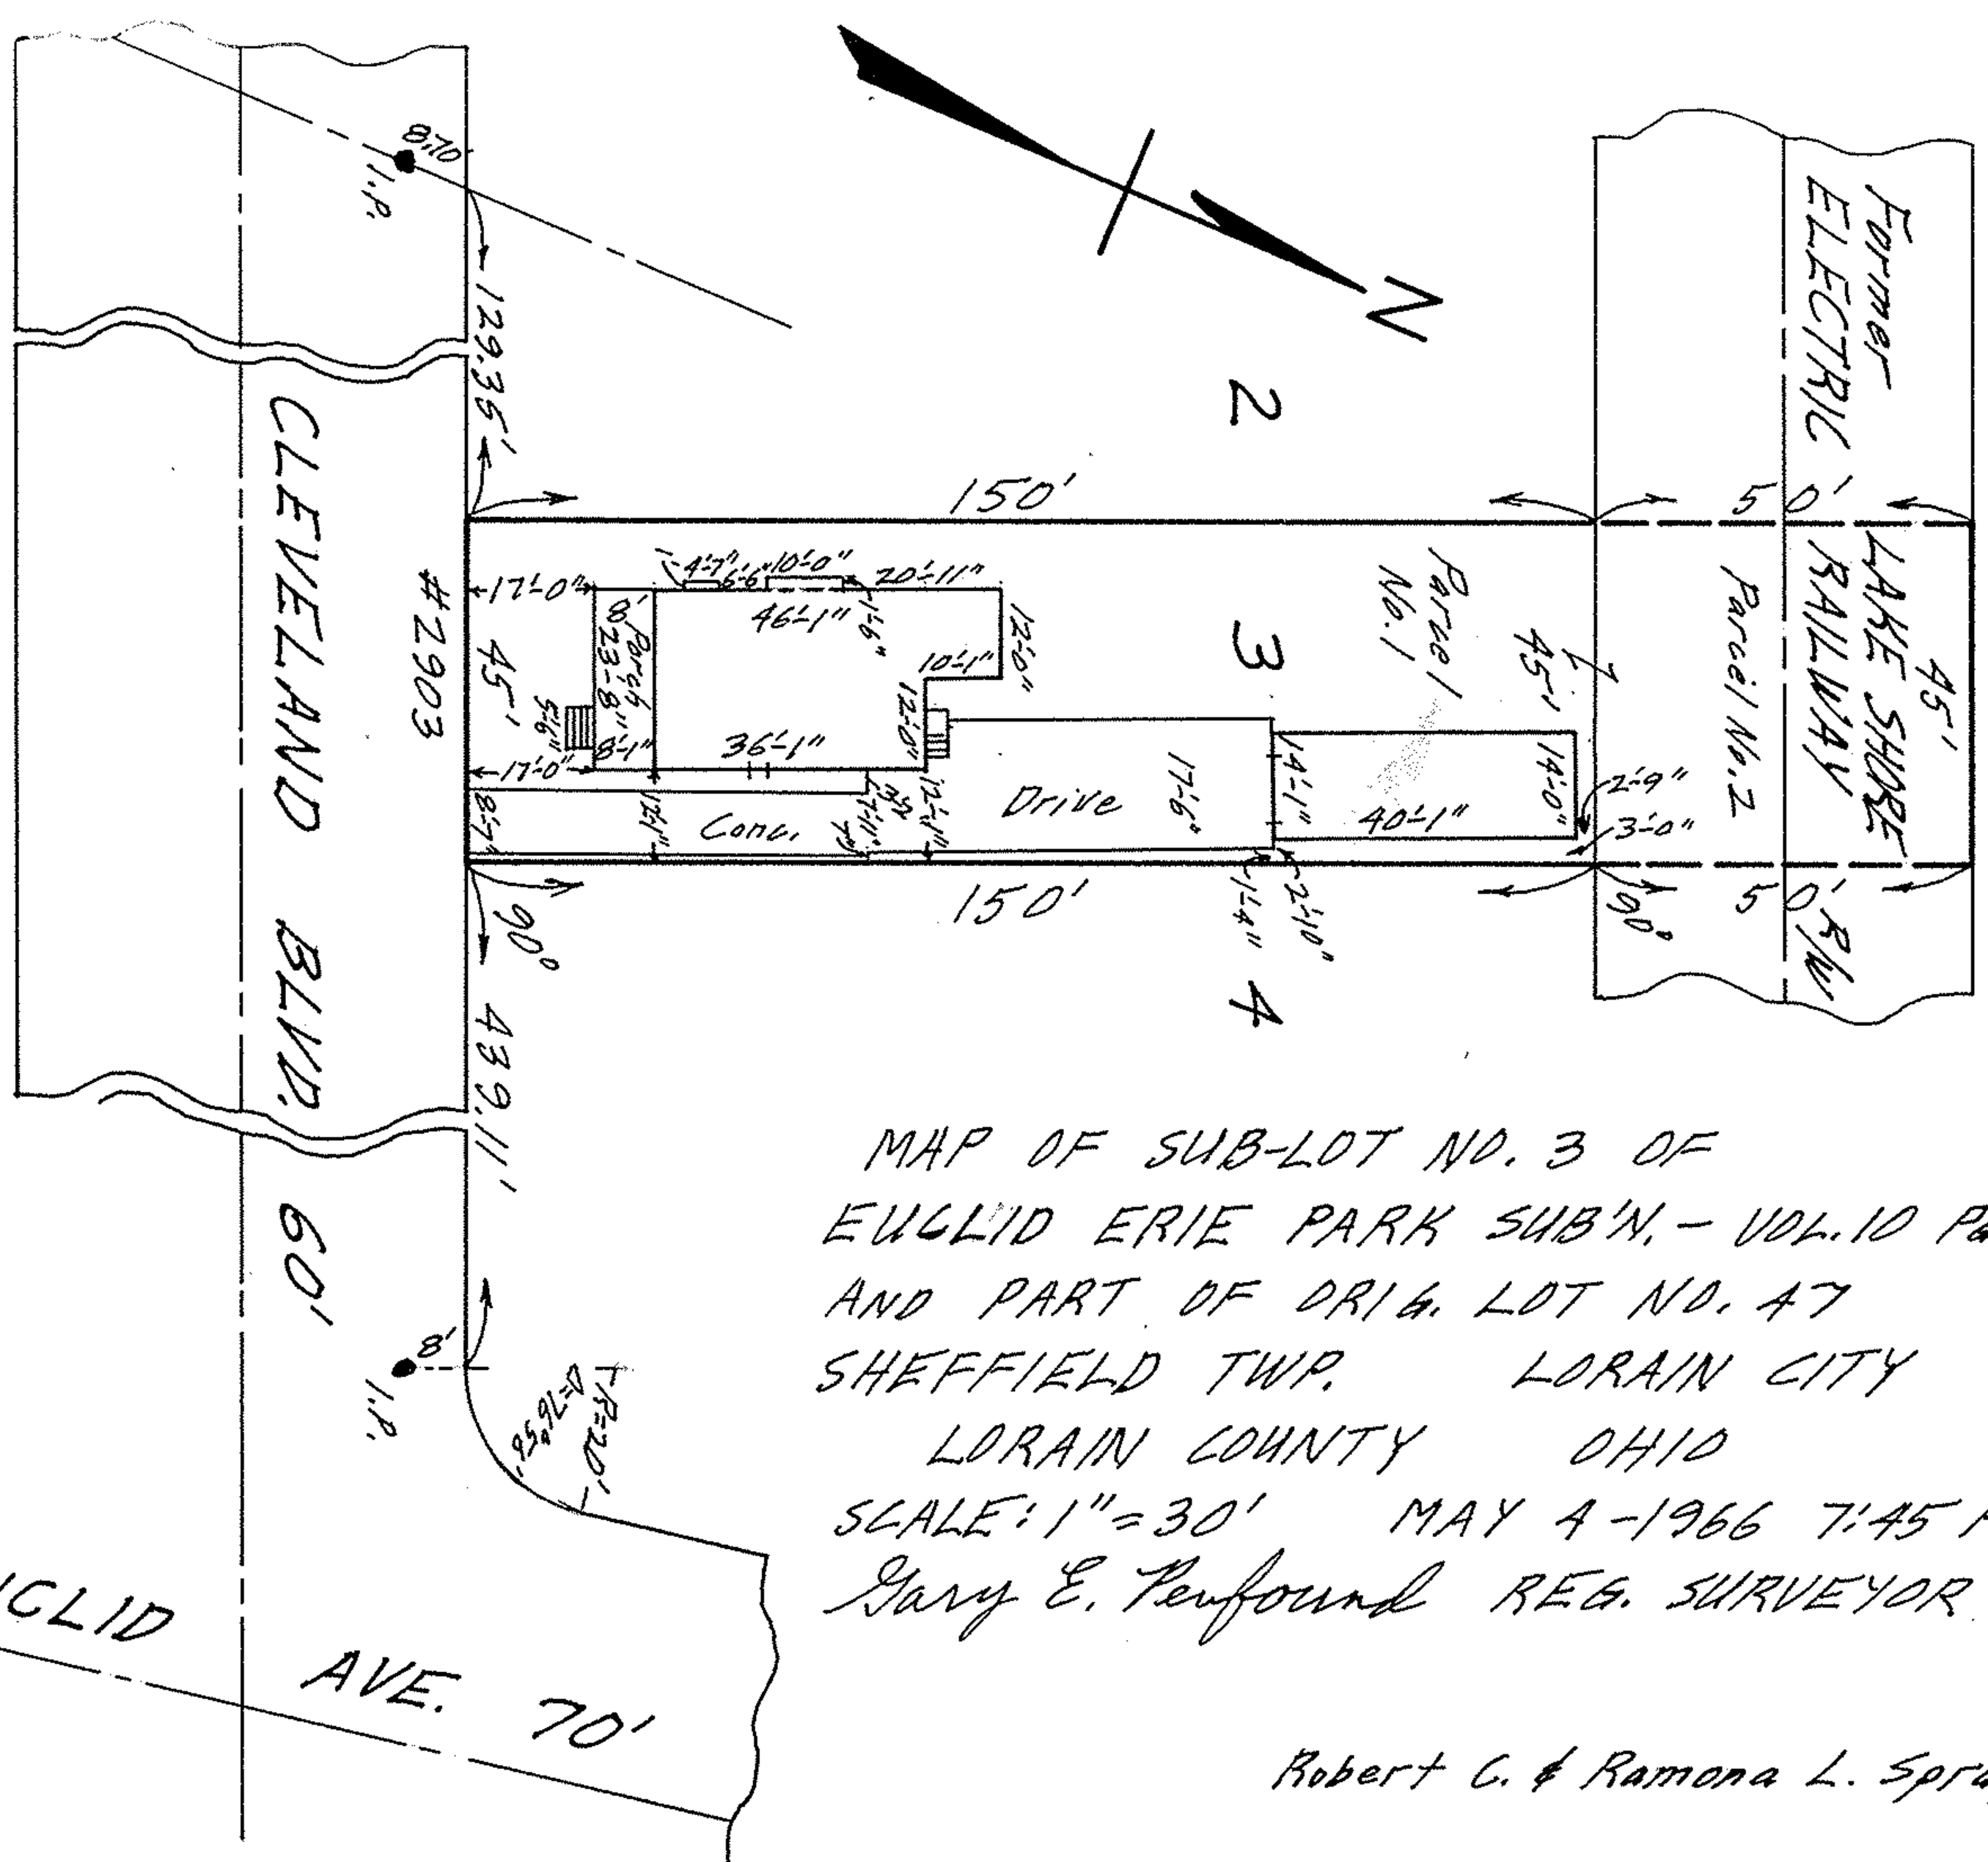

MAP OF SUB-LOT NO. 3 OF
EUCLID ERIE PARK SUB'N. - VOL. 10 Pg. 17
AND PART OF ORIG. LOT NO. 47
SHEFFIELD TWP. LORAIN CITY
LORAIN COUNTY OHIO
SCALE: 1"=30' MAY 4-1966 7:45 P.M.
Gary E. Penfound REG. SURVEYOR

Robert C. & Ramona L. Sprague

PG

03-00-047