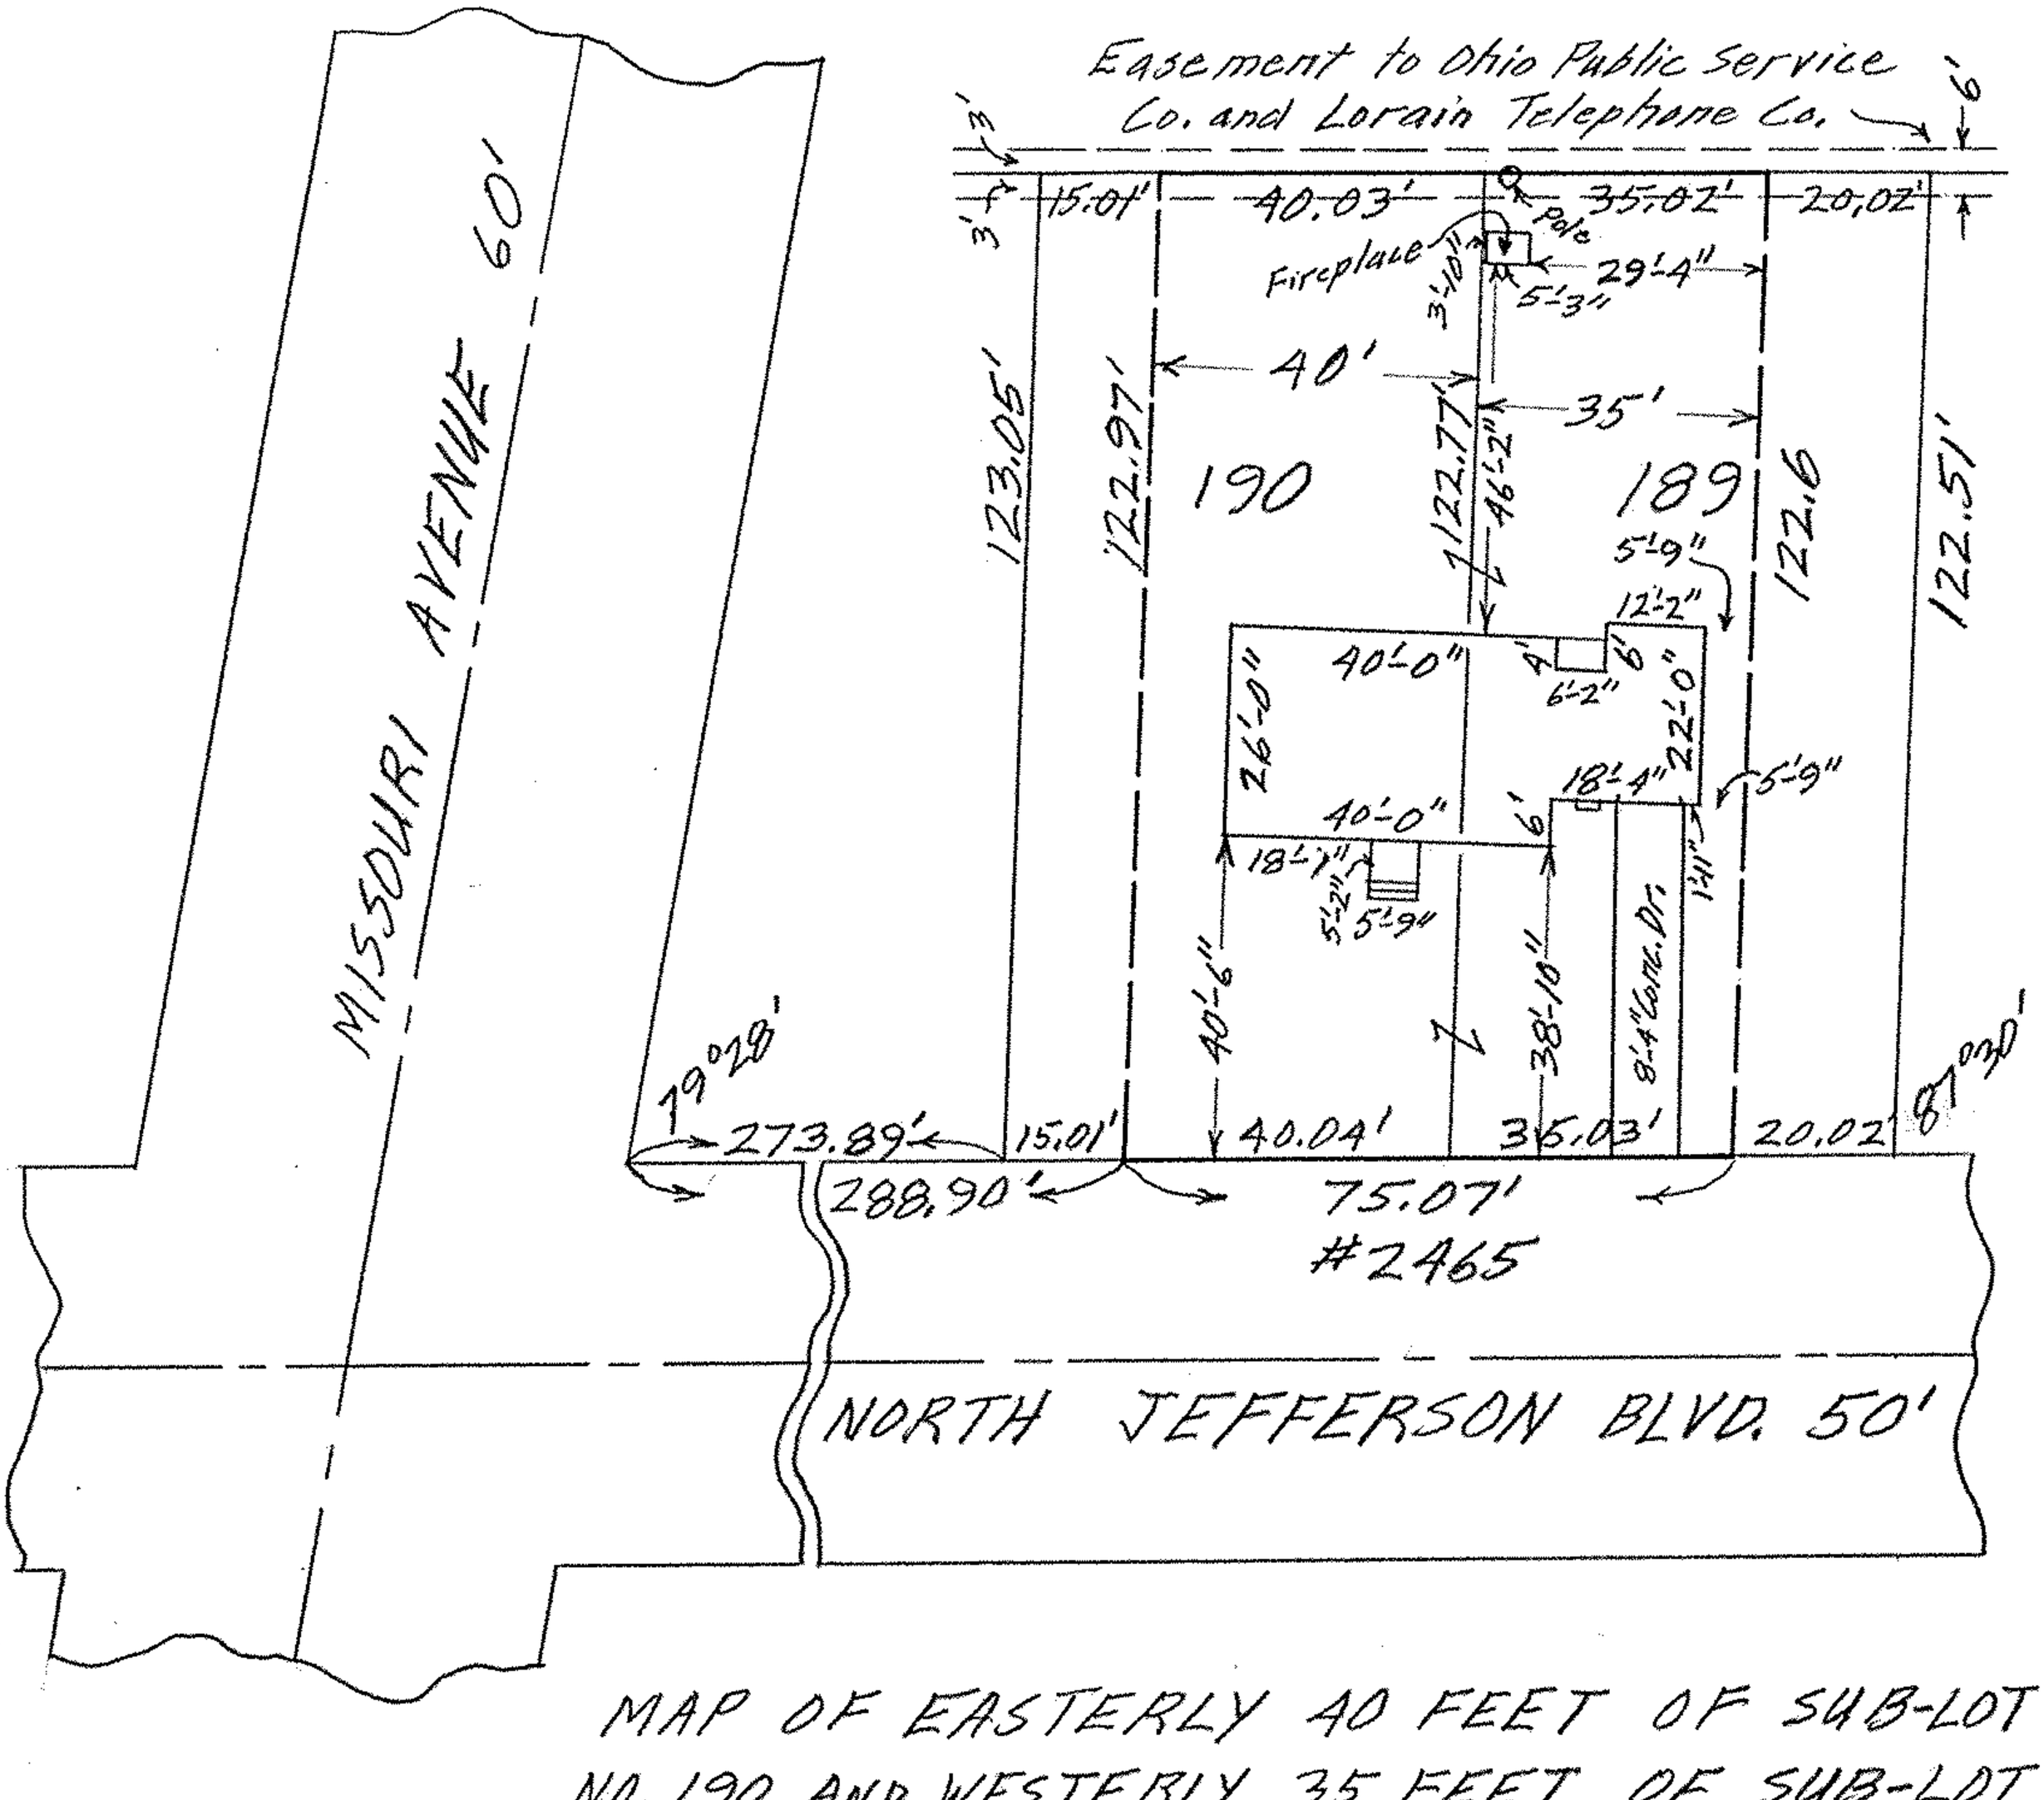


MAP OF EASTERLY 40 FEET OF SUB-LOT NO. 190 AND WESTERLY 35 FEET OF SUB-LOT NO. 189 IN HOY-LO-MAE ALL'T., SECOND ADD'N.
VOL. 14 PG. 12 PLATS
ORIG. LOTS 48 & 49 SHEFFIELD TWP.
LORAIN CITY - LORAIN COUNTY - OHIO
SCALE: 1"=30' MAY 20-1965 12:30 P.M.
Gary E. Penfound REG. SURVEYOR

Rollin R. & Mary W. Bishop

BH

03-00-049