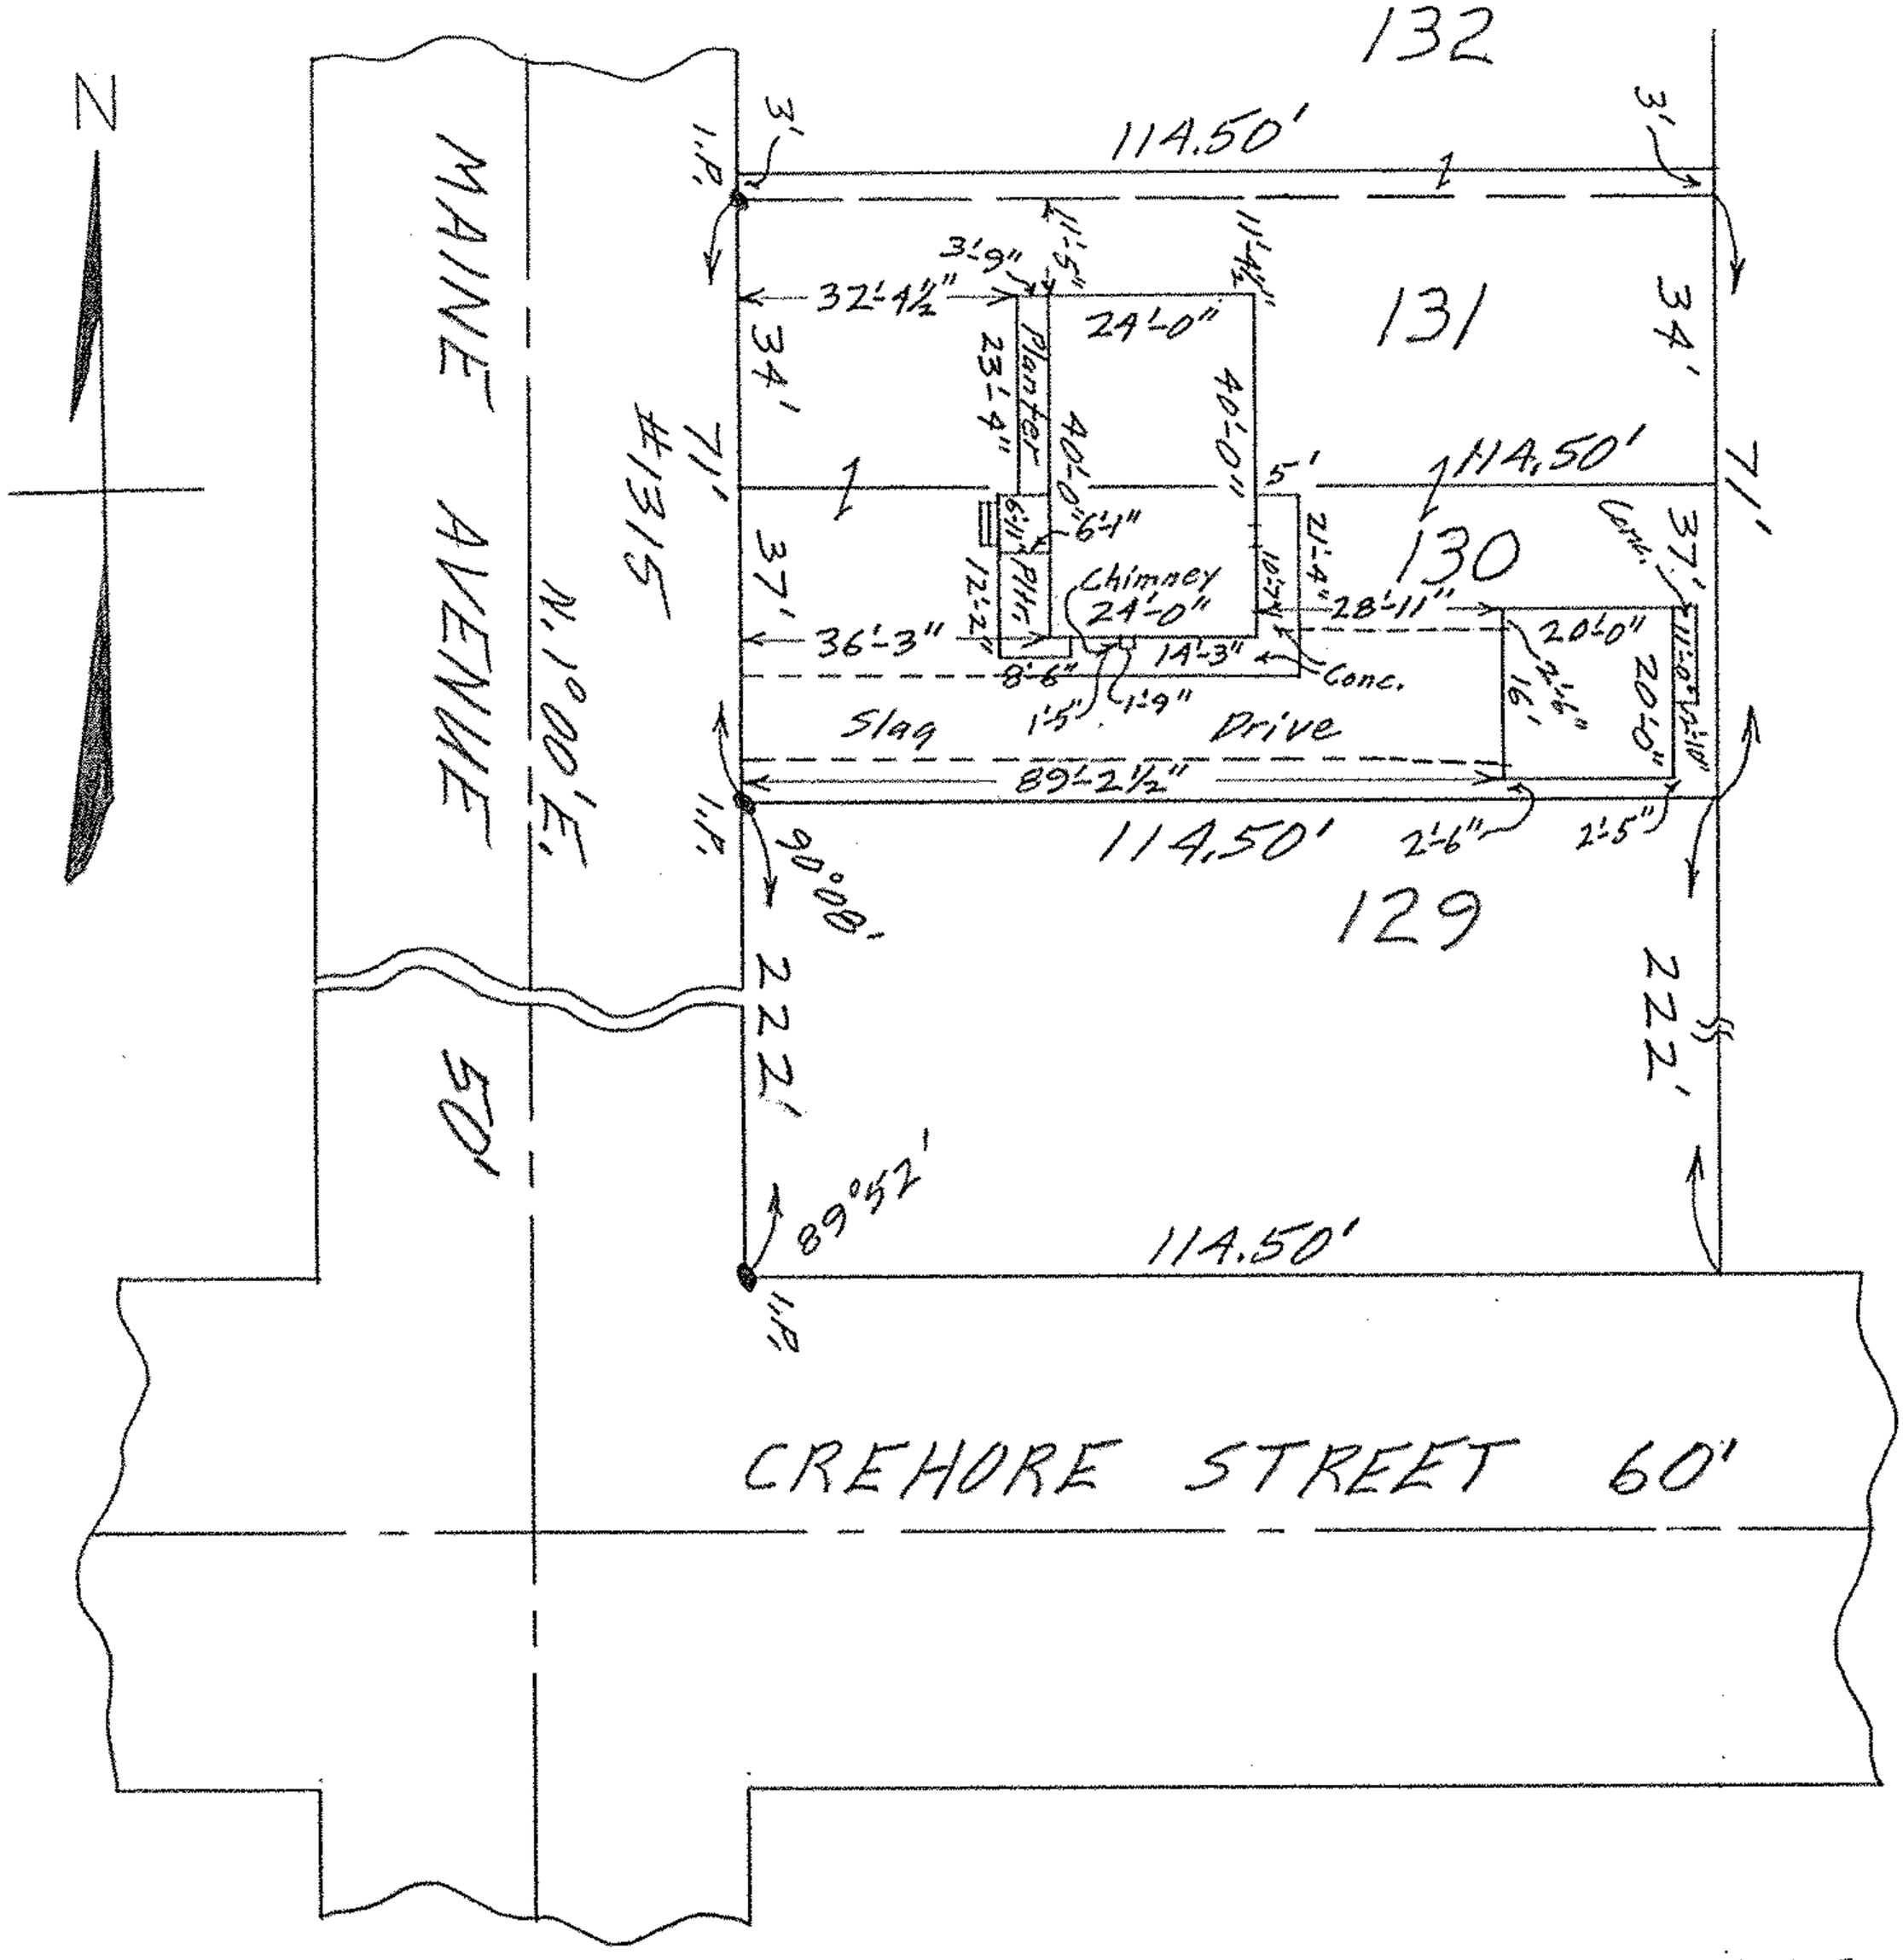

MAP OF SUB-LOT NO. 130 AND SOUTHERLY 34 FEET OF SUB-LOT NO. 131 OF COLORADO PARK ALLOTMENT VOL. 9 PG. 12 PLAT RECORDS - ORIG. LOT 50 SHEFFIELD TWP. LORAIN CITY - LORAIN COUNTY - OHIO

SCALE: 1"=30' SEPT. 17-1964 7:15 P.M.

Gary E. Penfound REG. SURVEYOR

John L. & Lorene Bracy

03-00-050 WW