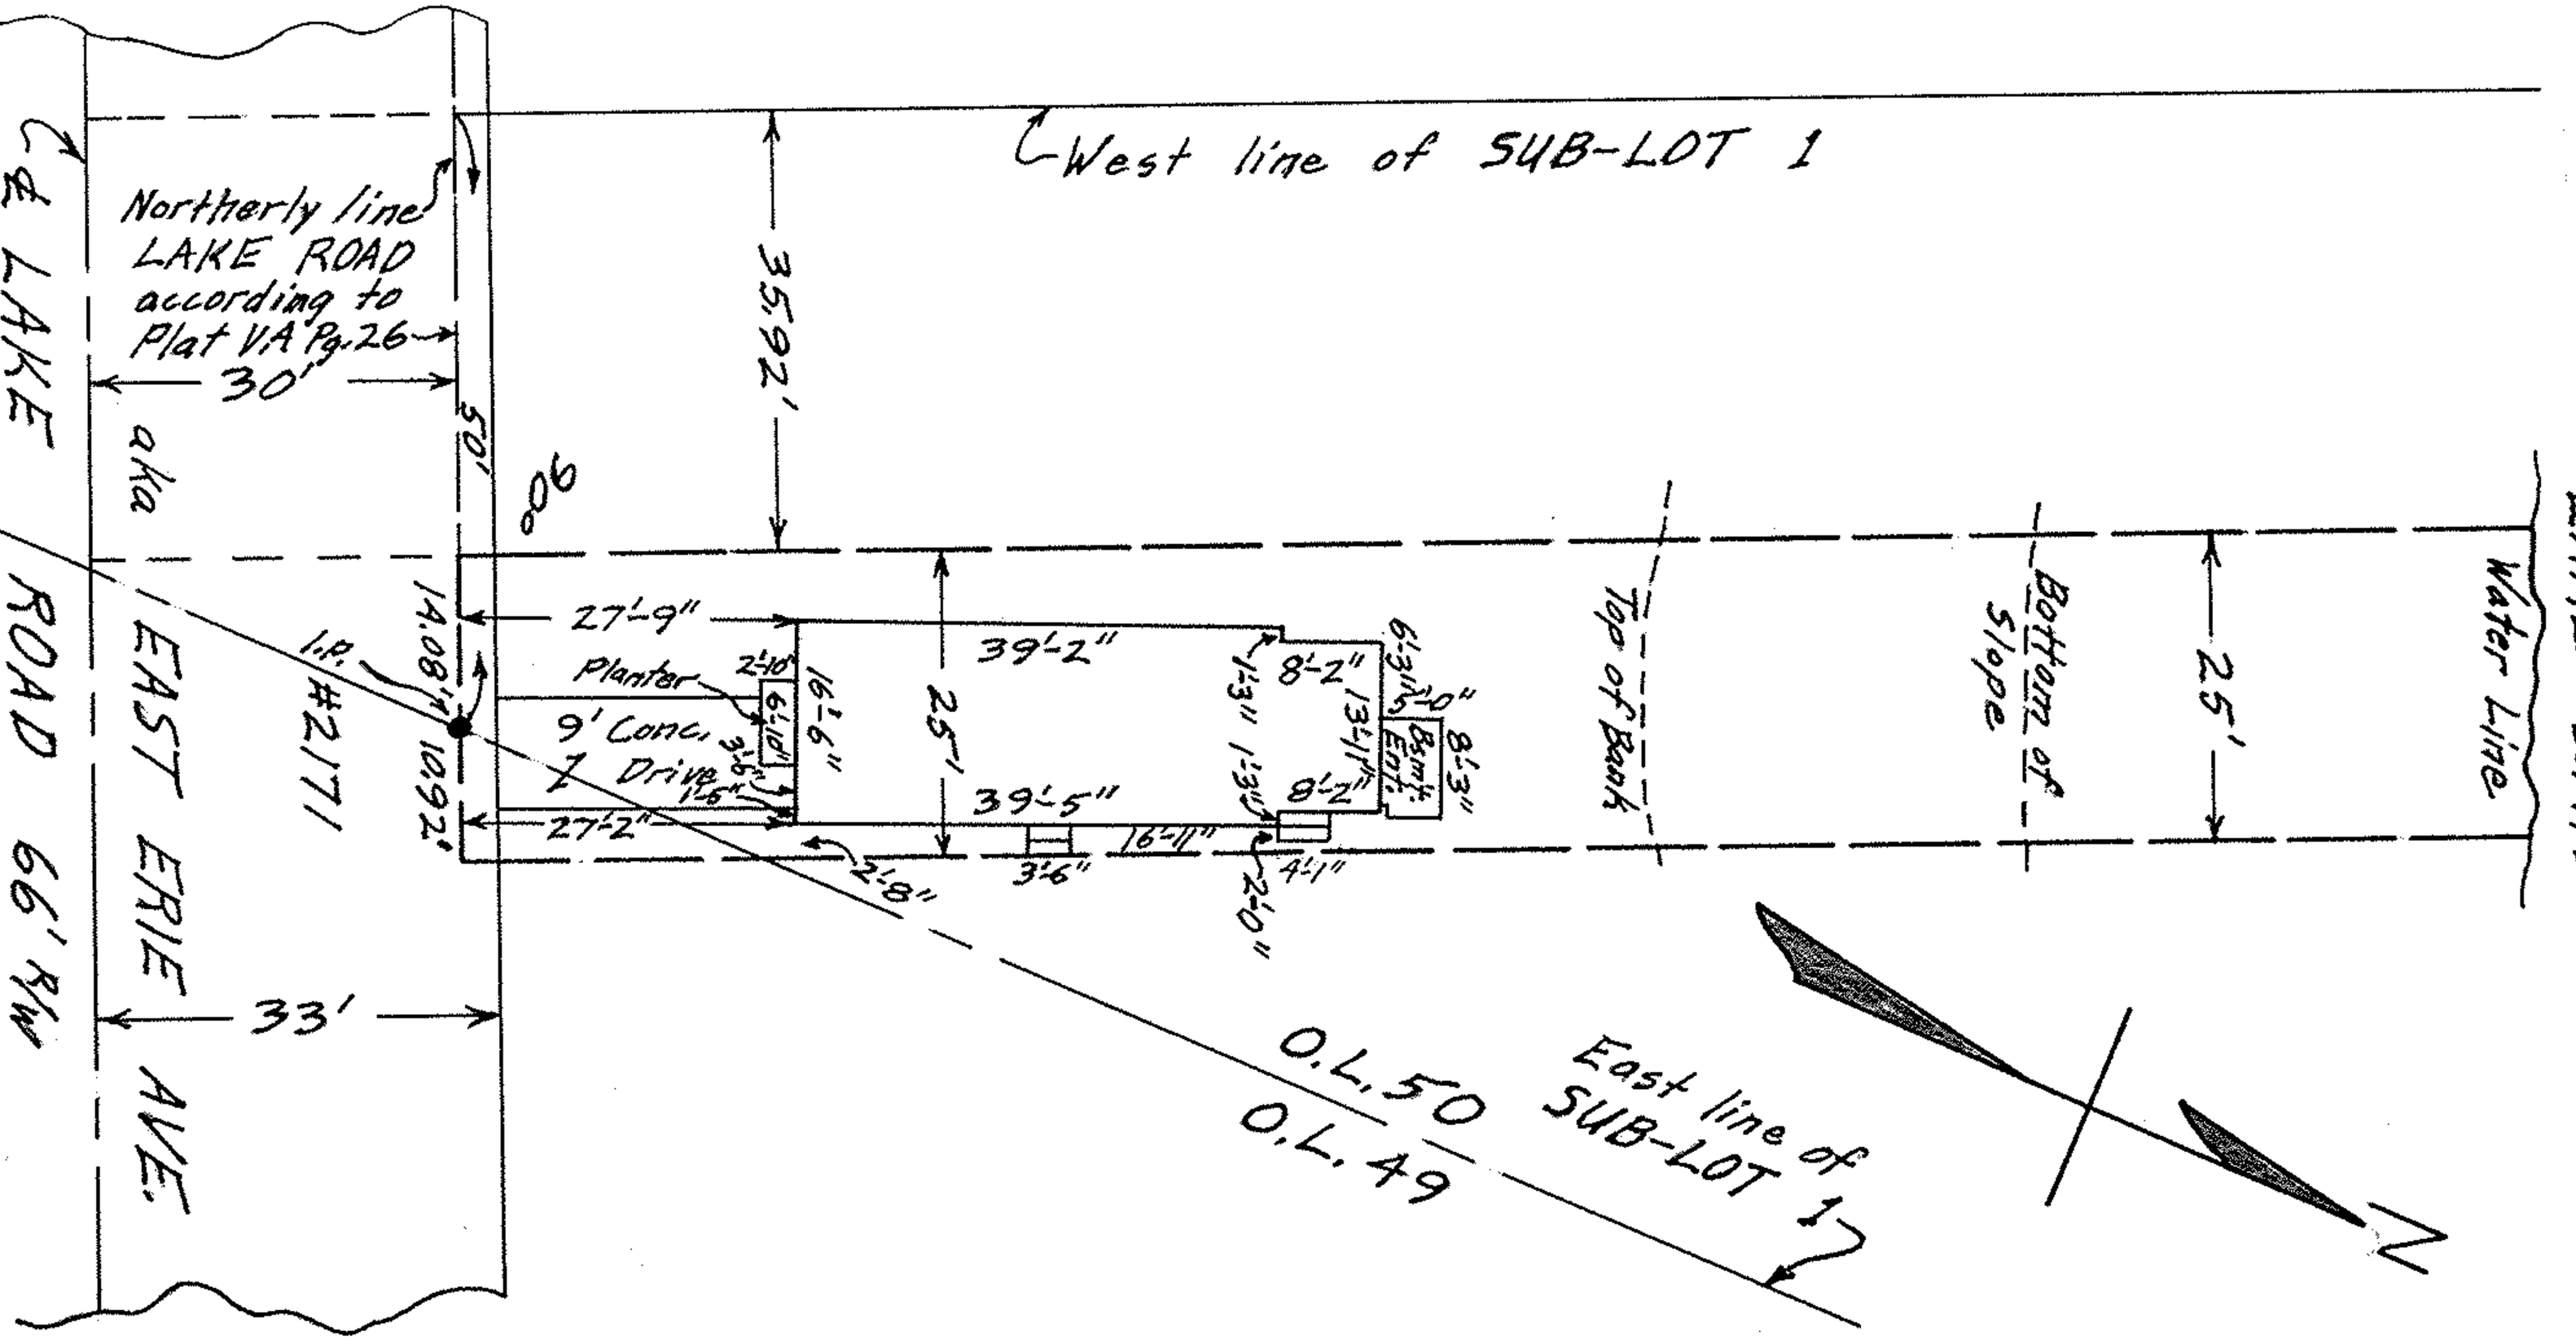

MAP OF PART OF SUB-LOT NO. 1 OF T. G. GAWN'S SUB'N. (VOL. 4 PG. 26) OF PART OF ORIG. LOT 50, AND PART OF ORIG. LOT 49 OF SHEFFIELD TWP.
LORAIN CITY LORAIN COUNTY OHIO
SCALE: 1" = 20' APRIL 26-1968 1:00 P.M.
Gary E. Penfound REG. SURVEYOR

Charles E. & Carole Anne Maynard

03-00-050 PC