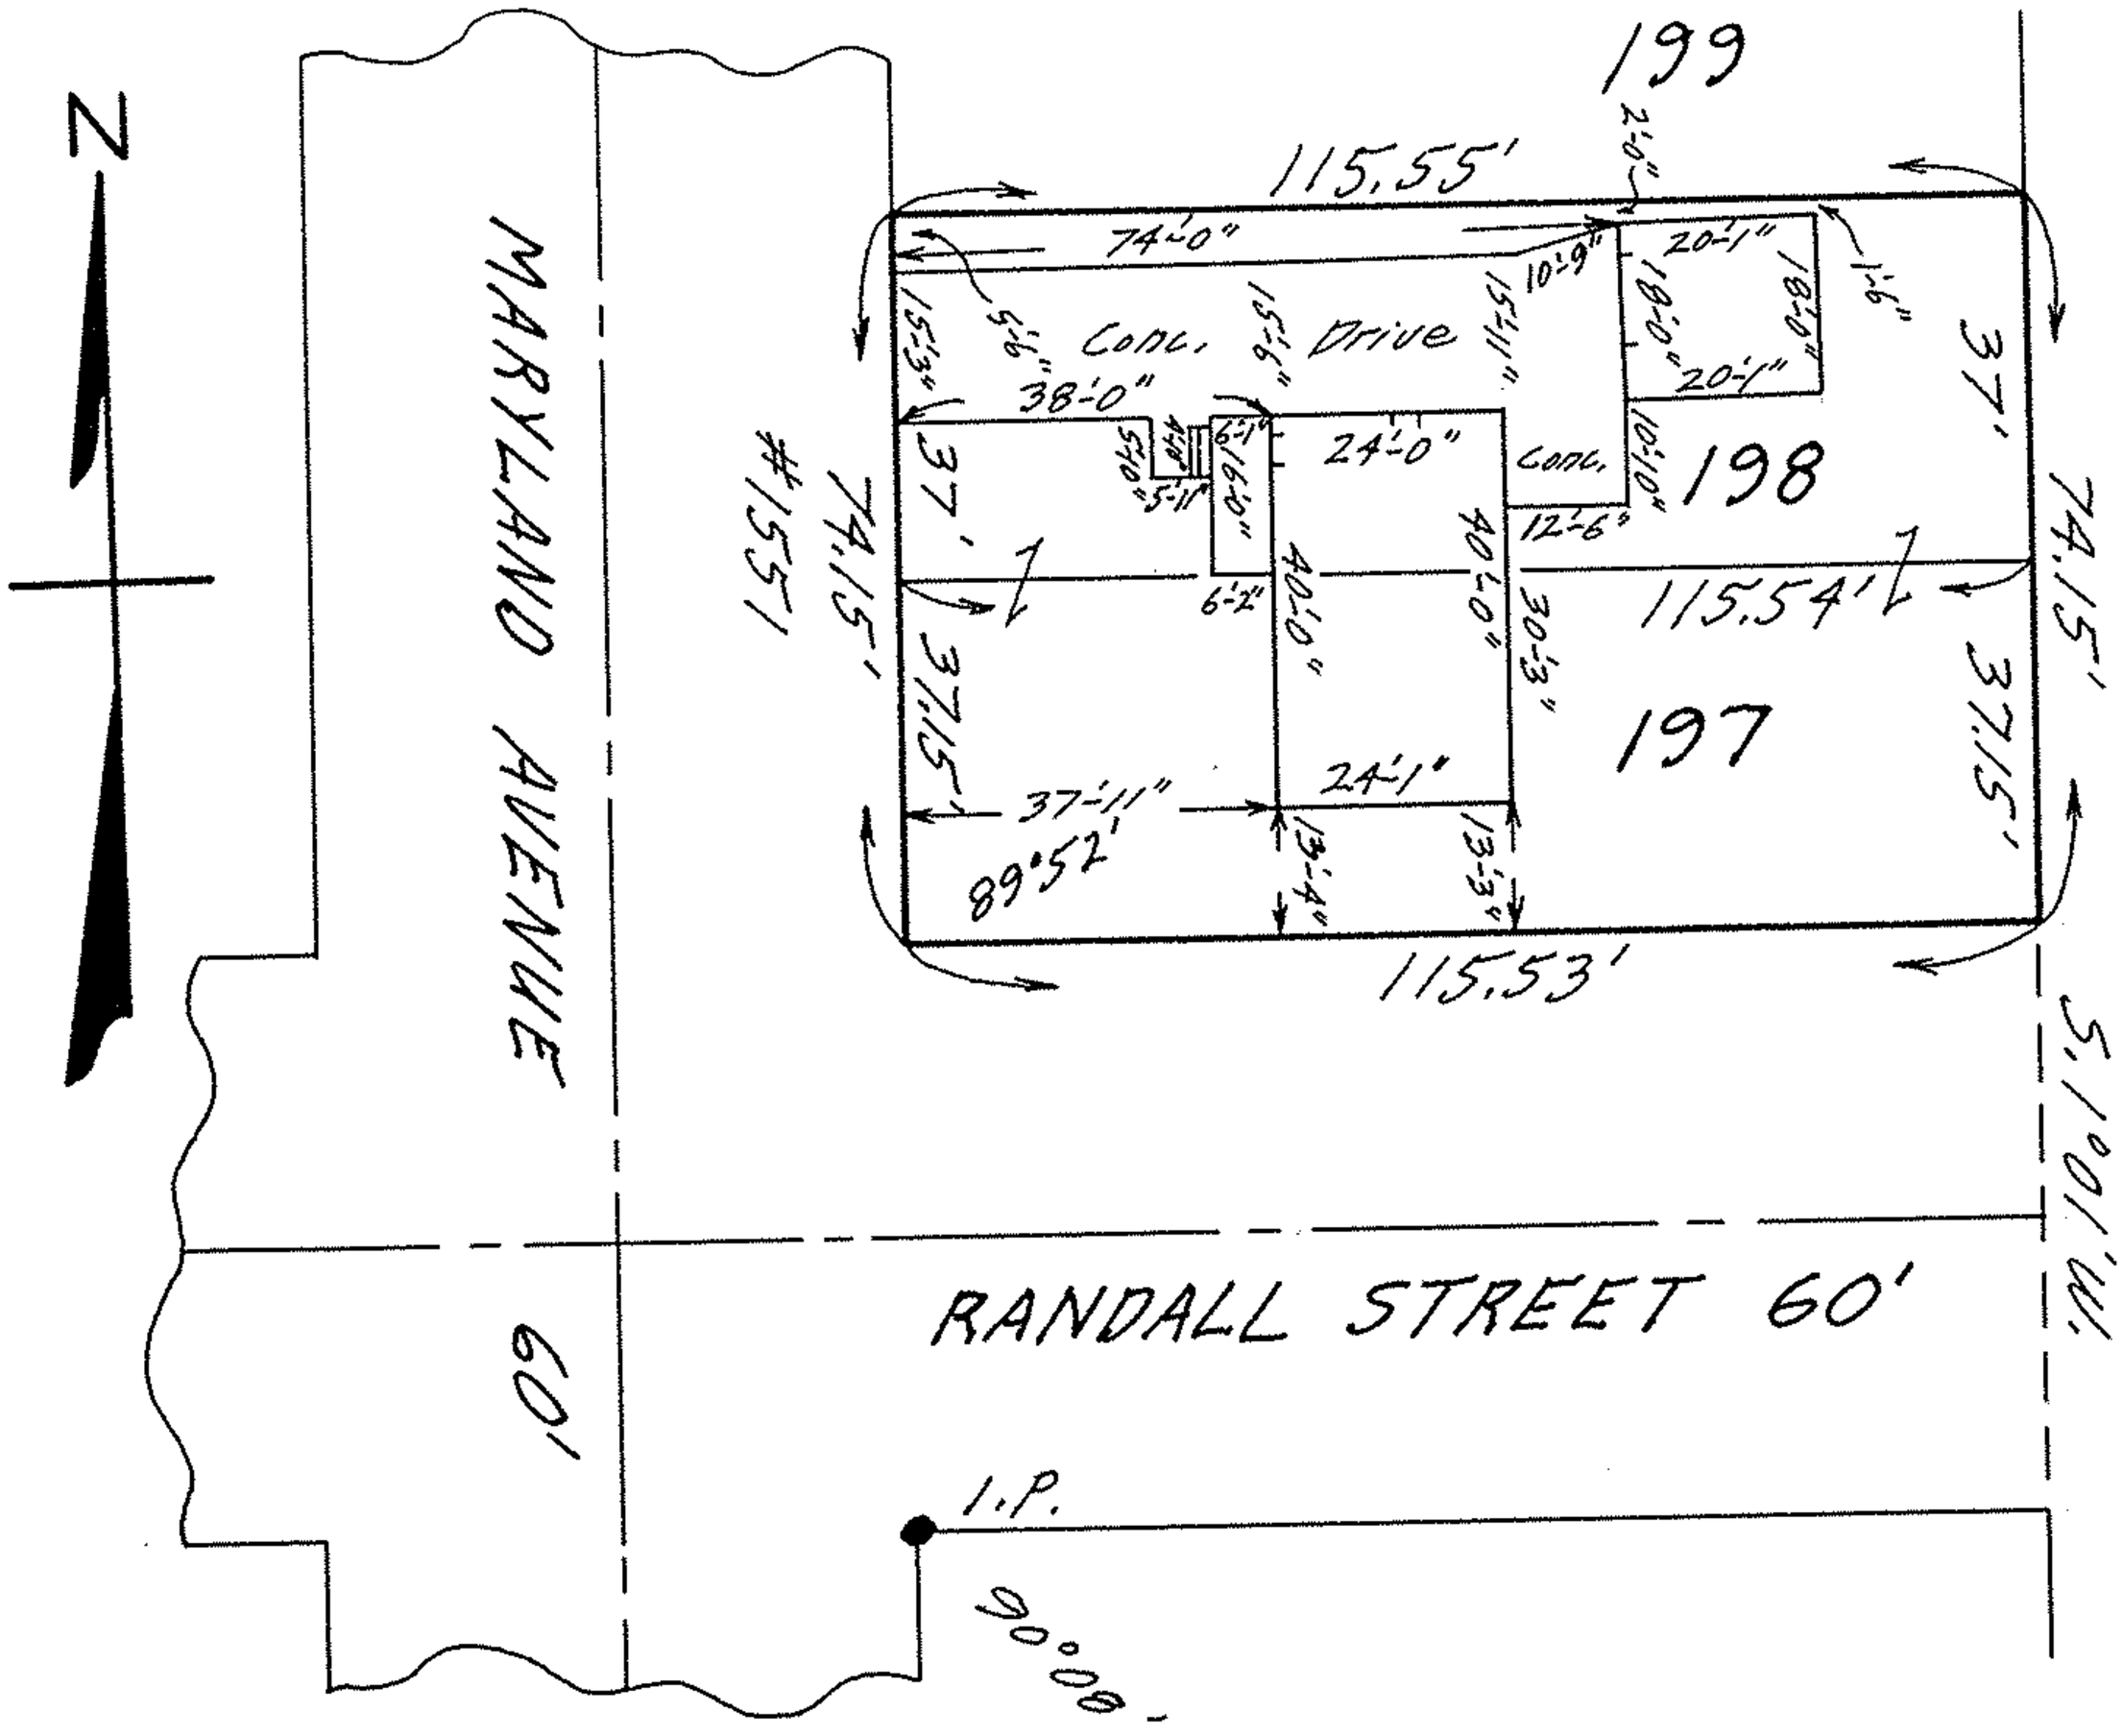

MAP OF SUB-LOTS NOS. 197 & 198
COLORADO PARK ALL'T. VOL. 9 PG. 12
ORIG. LOT NO. 53 SHEFFIELD TWP.
LORAIN CITY - LORAIN COUNTY - OHIO
SCALE: 1"=30' DEC. 5-1970 1:45 P.M.
NOTE: There are no encroachments on this property.
Gary E. Penfound REG. SURVEYOR NO. 4457

CITY TITLE Co. Order No. E-1413
Vargo to Suchey

03-00-053