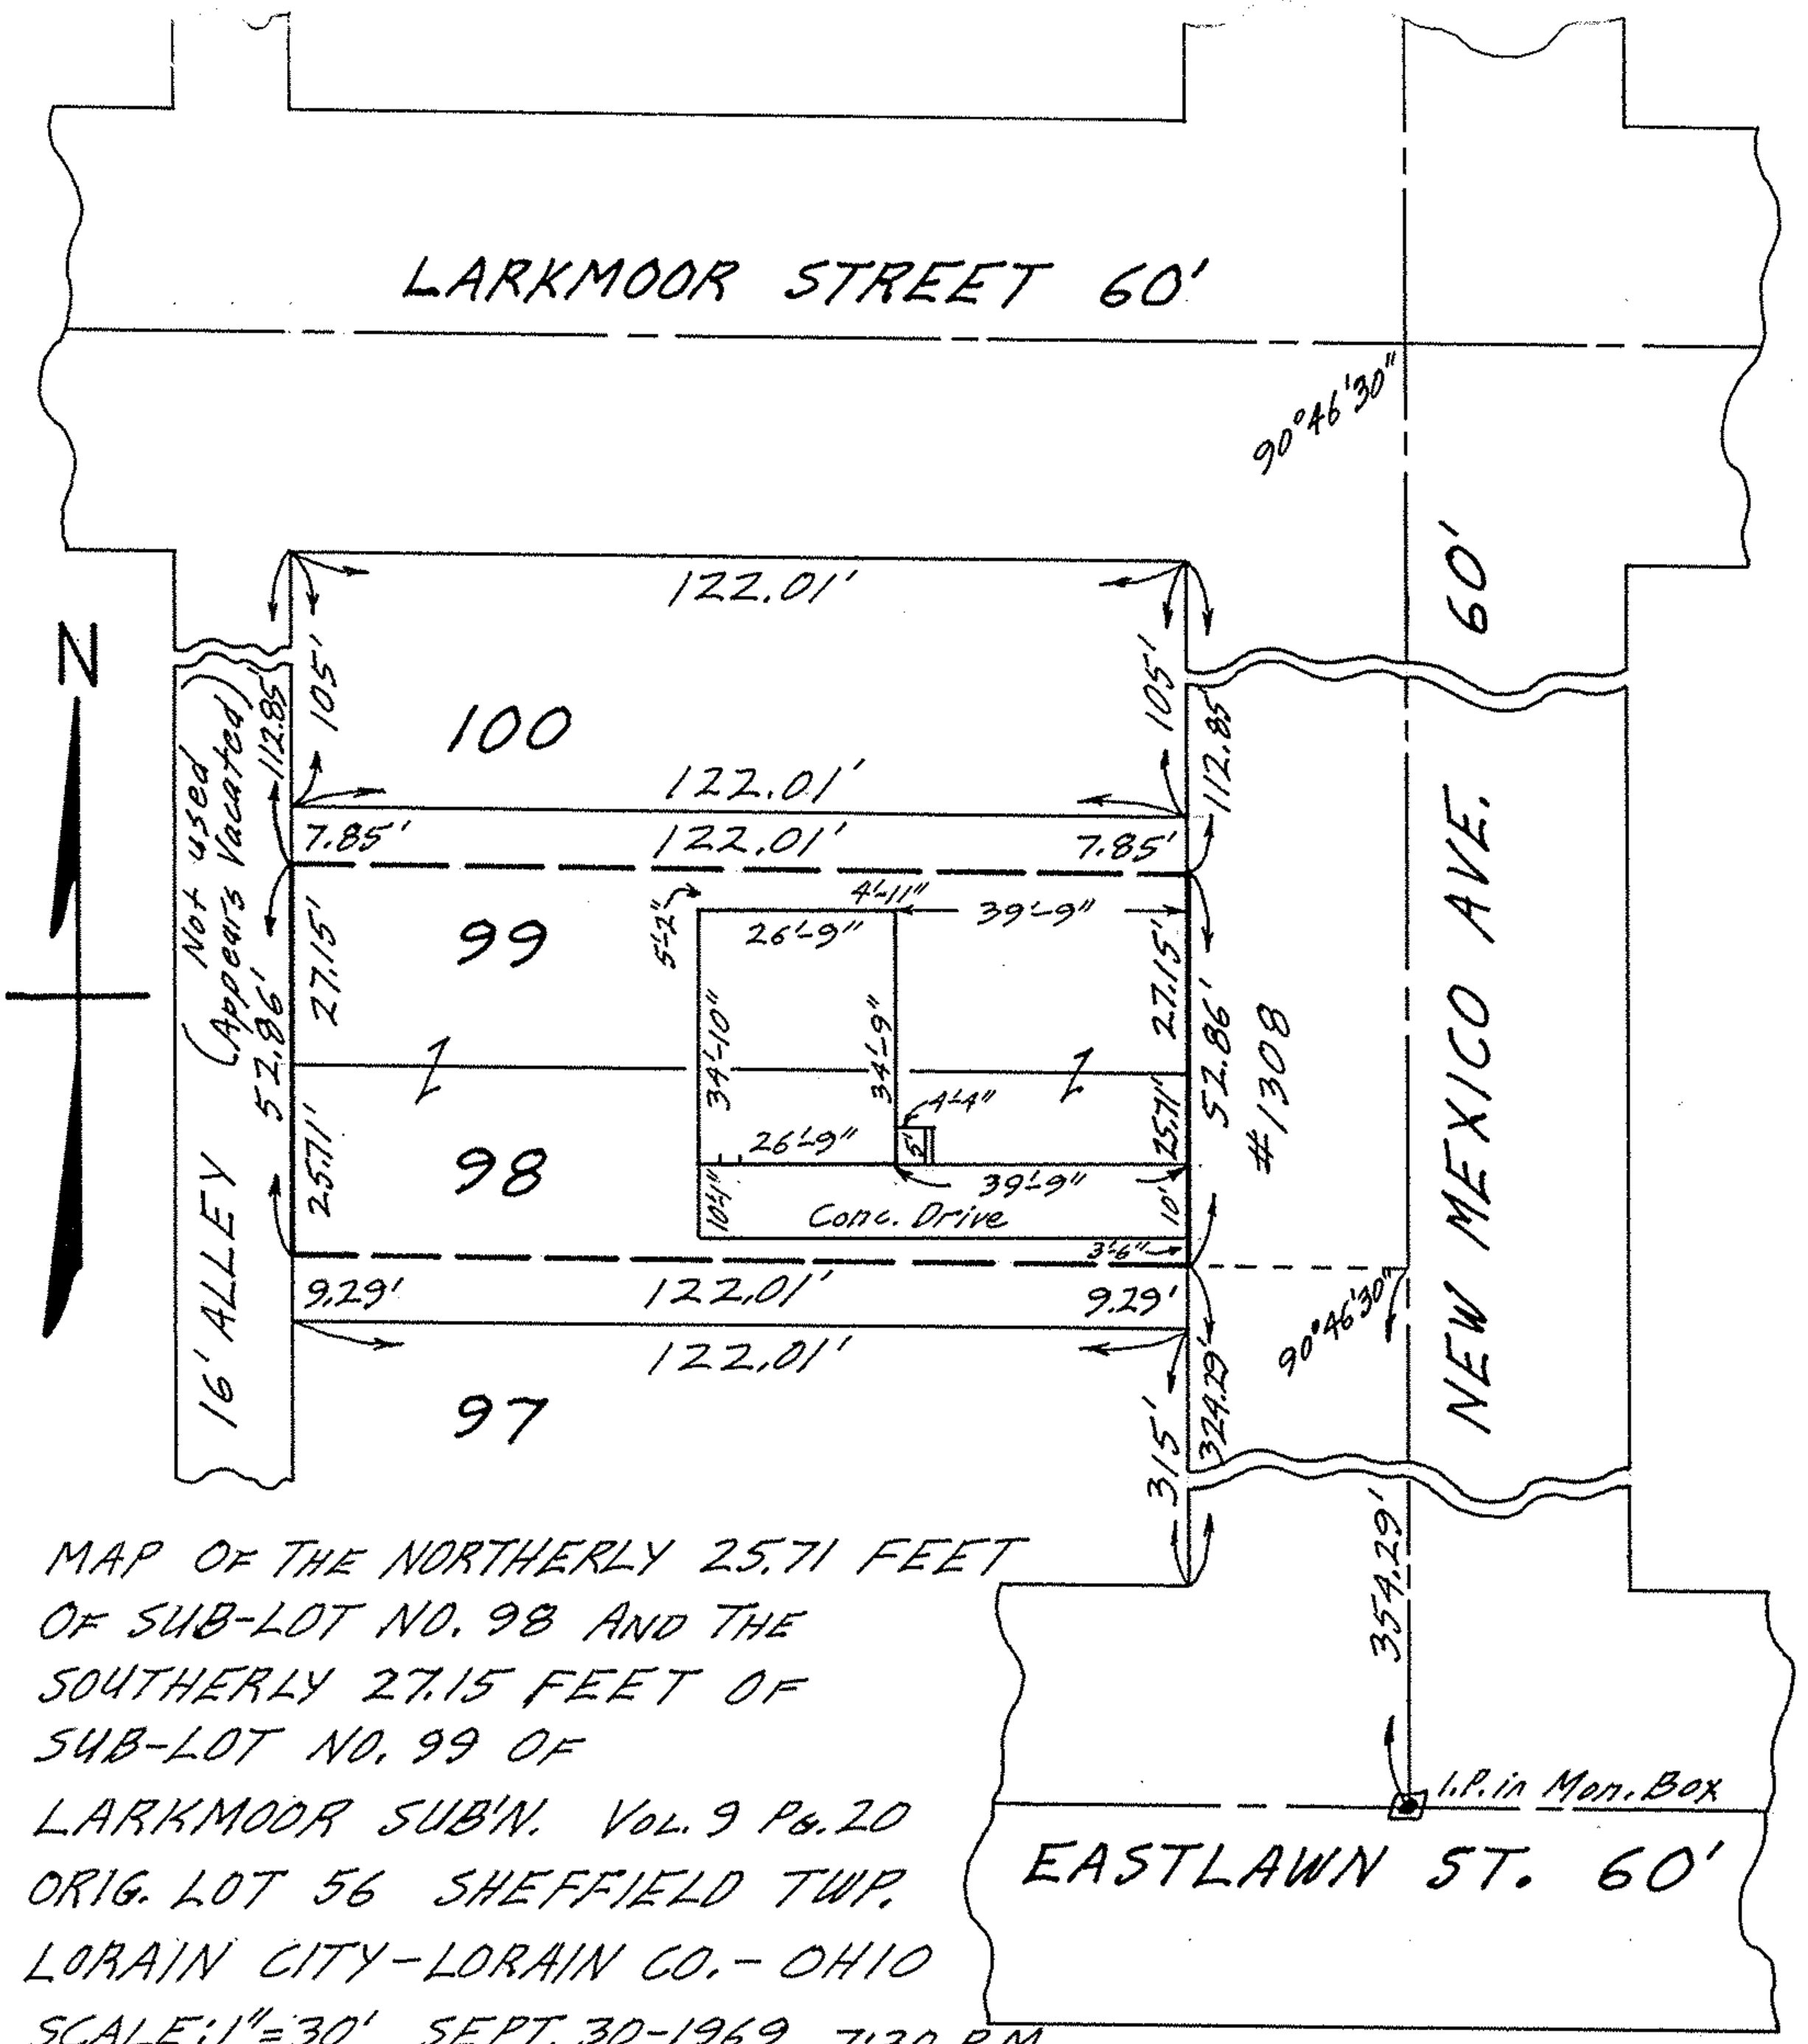

MAP OF THE NORTHERLY 25.71 FEET
OF SUB-LOT NO. 98 AND THE
SOUTHERLY 27.15 FEET OF
SUB-LOT NO. 99 OF
LARKMOOR SUB'N. VOL. 9 PG. 20
ORIG. LOT 56 SHEFFIELD TWP.
LORAIN CITY - LORAIN CO. - OHIO
SCALE: 1" = 30' SEPT. 30-1969 7:30 P.M.

NOTE: There are no encroachments on the above property.

Gary E. Penfound REG. SURVEYOR NO. 4457

CITY TITLE Co. Order No. E-862-3

Edward D. & Grace H. Jones to John J. & Susan F. Zaborowski

03-00-056